LEGEND

BHARAT SANCHAR NIGAM LIMITED


- Existing OFC Route
- Proposed OFC UG
- Proposed OFC Aerial Route
- Moling
- Block Router
- GP Router
- Bharatnet HandHole
- Bharatnet Joint Chambers
- Bharatnet Cement Route Marker
- G.I Pipe
- PVC Pipe
- DWC Pipe
- PCC
- Road Width
- Road ctr Line

- Kilometer Stone
- Protection
- Flyovers
- OT
- Culvert
- Bridge
- Railway Tracks
- Railway Crossing
- Road under Rly. Bridge
- Splitter 1:4
- Splitter 1:2
- Gram Panchayat
- Block
- Buildings
- Gate
- Temple
- Gurudwara

- Church
- School
- Mosque
- Bus Stand
- Railway Station
- Airport
- Fire Station
- Police Station
- Hospital
- College/University
- Hotel
- Petrol Bunk
- Theatre
- Industry
- Post Office
- Shopping Mall

- Gas Pipeline Crossing
- High Tension Line
- Transformer
- Electrical Pole
- Traffic Signal Pole
- HT Tower
- OFC Stone Others
- DOT Exch
- BSNL BTS
- Telephone Pole
- Proposed Pole
- Existing Pole
- Manhole
- Zero Manhole
- Coupler

AS BUILT DIAGRAM

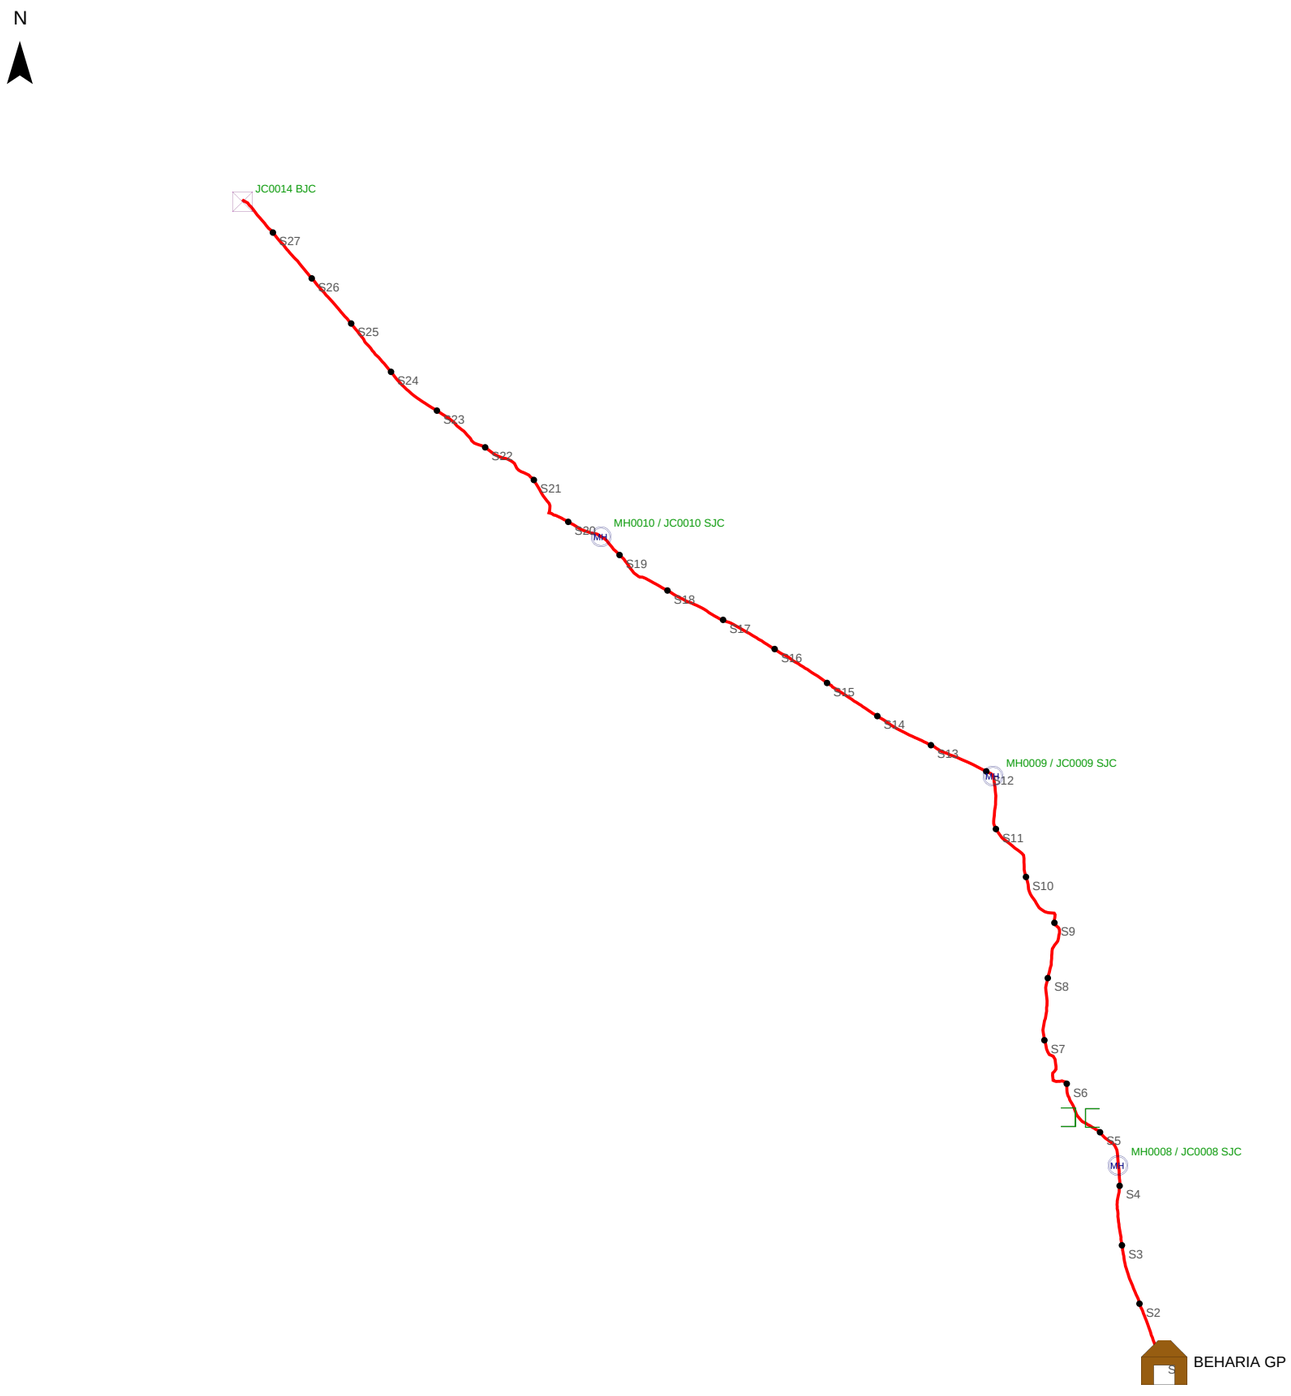

PACKAGE 9/ WEST BENGAL - WEST BENGAL (ST) - MURSHIDABAD (DT) - HARIHARPARA (BL)

- ROUTE LENGTH (M) : 6686
- NEW LENGTH (M) : 6686
- HDD LENGTH (M) : 6686
- OT LENGTH (M) : 0
- SURVEYED PIECES : 0
- COUPLERS : 0
- JOINT CHAMBERS : 3
- MANHOLES : 3
- ROUTE INDICATORS : 20
- KM STONES : 2
- NO OF CULVERTS : 1
- NO OF BRIDGES : 0
- LANDMARKS : 2
- NOT SURVEYED GAPS (M) : 0
- ROUTE : GP110619 > MH0008 > MH0009 > MH0010 > JC0014

NOTE : ALL MESURMENTS ARE IN METERES (M)


ROAD OFFSET = DISTANCE FROM ROAD CENTRE LINE TO CABLE. ROAD FROM OPENSTREETMAP, CABLE FROM GPS - APPROXIMATE

Amended Bharatnet Program Phase - III

PACKAGE - 9/ WEST BENGAL	PIA - Tera Software
JOB	AS BUILT DRAWING
BLOCK NAME :	HARIHARPARA
SPAN :	BEHARIA GP TO JC0014
FROM GP: BEHARIA GP TO GP: JC0014	

PIA	IE	BSNL

PLANIMETRY SCALE : H/V - 1:25000	SHEET SIZE - A3
FROM CH: 0 M TO CH: 6686 M	SHEET NO. - 00
Span Length :- 6.686 KM	DATE:

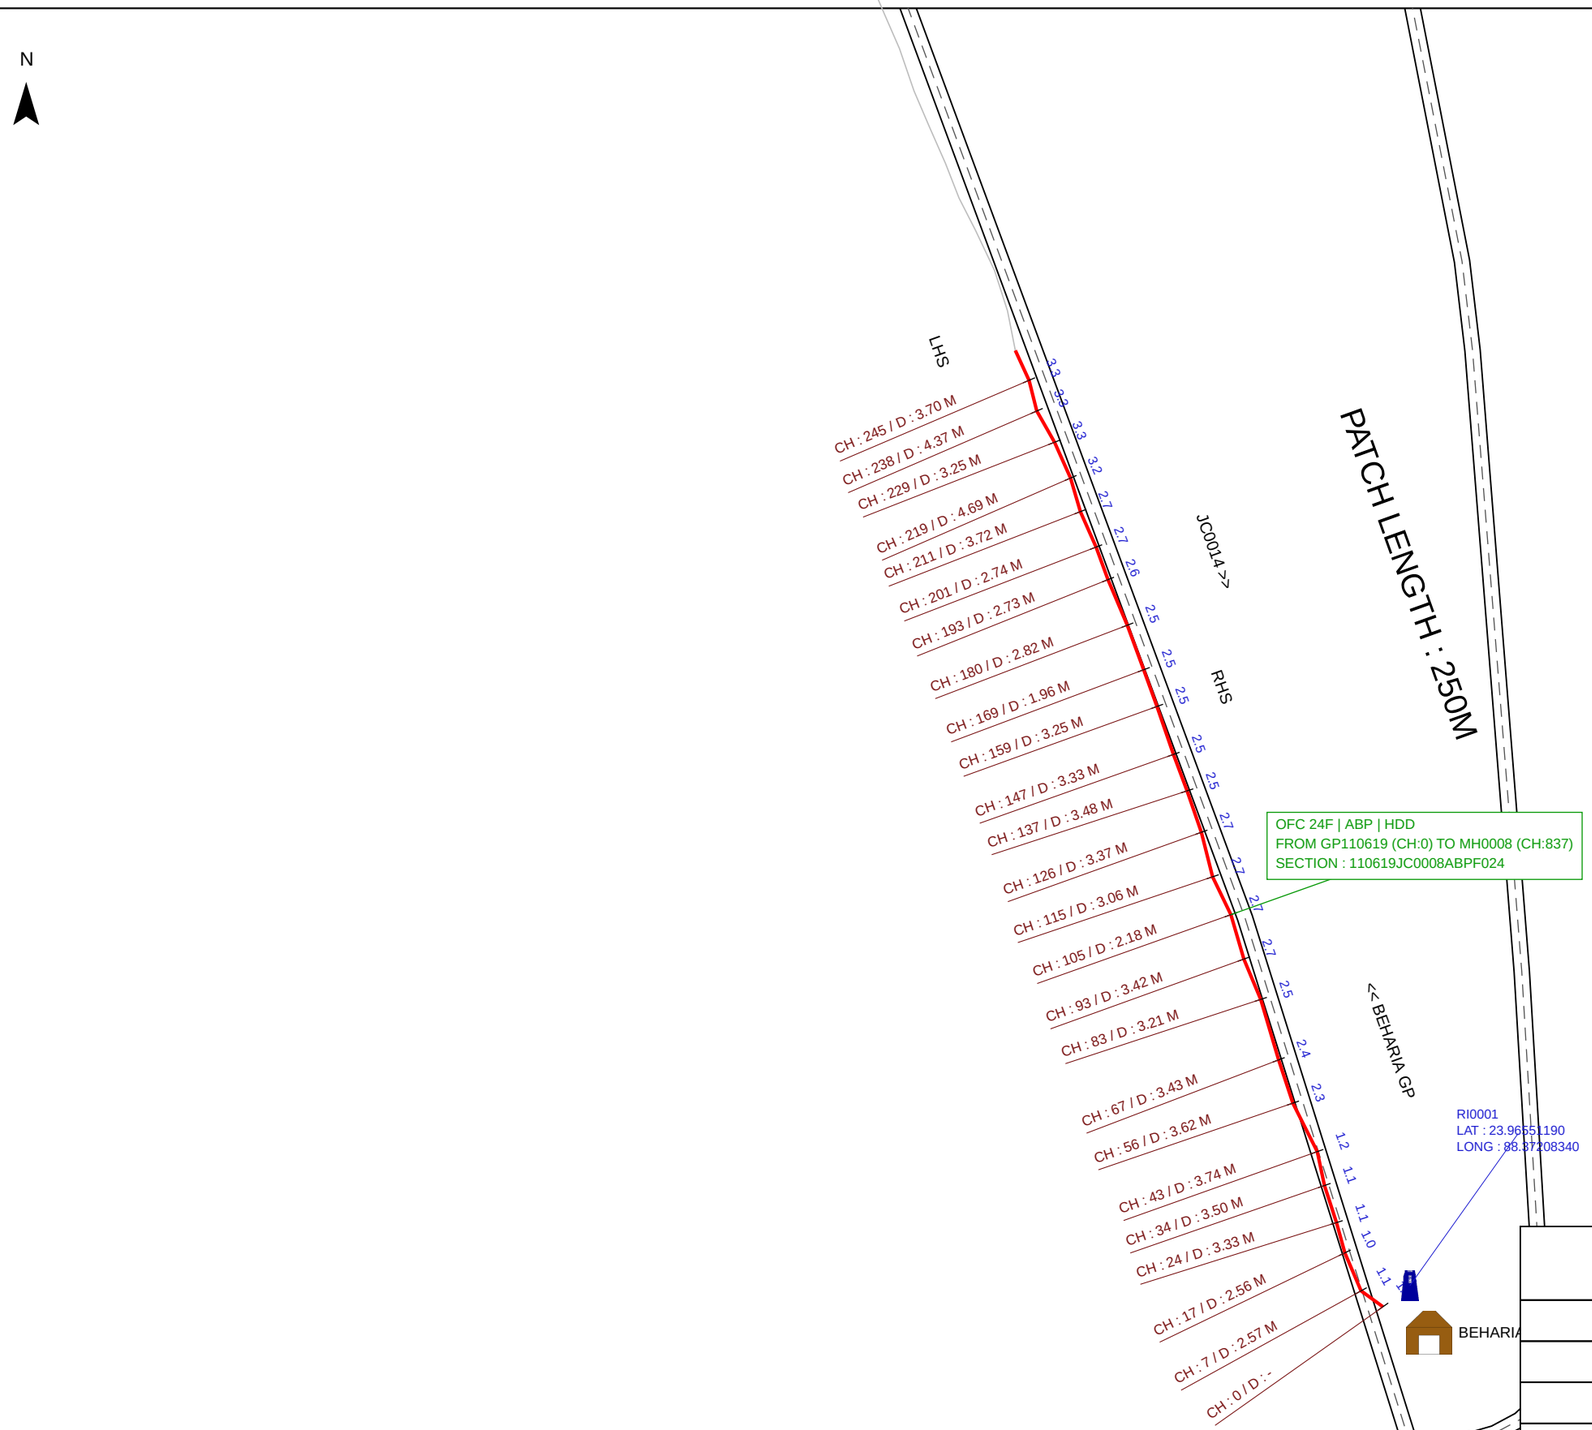

Amended Bharatnet Program Phase - III


PACKAGE - 9/ WEST BENGAL	PIA - Tera Software
JOB	AS BUILT DRAWING
BLOCK NAME :	HARIHARPARA
SPAN :	BEHARIA GP TO JC0014
FROM GP: BEHARIA GP TO GP: JC0014	

PIA	IE	BSNL

PLANIMETRY SCALE : H/V - 1:1500	SHEET SIZE - A3
FROM CH: 0 M TO CH: 250 M	SHEET NO. - 1
Patch Length :- 250 m	DATE:

NOTE : ALL MESURMENTS ARE IN METERES (M)

ROAD OFFSET = DISTANCE FROM ROAD CENTRE LINE TO CABLE. ROAD FROM OPENSTREETMAP, CABLE FROM GPS - APPROXIMATE

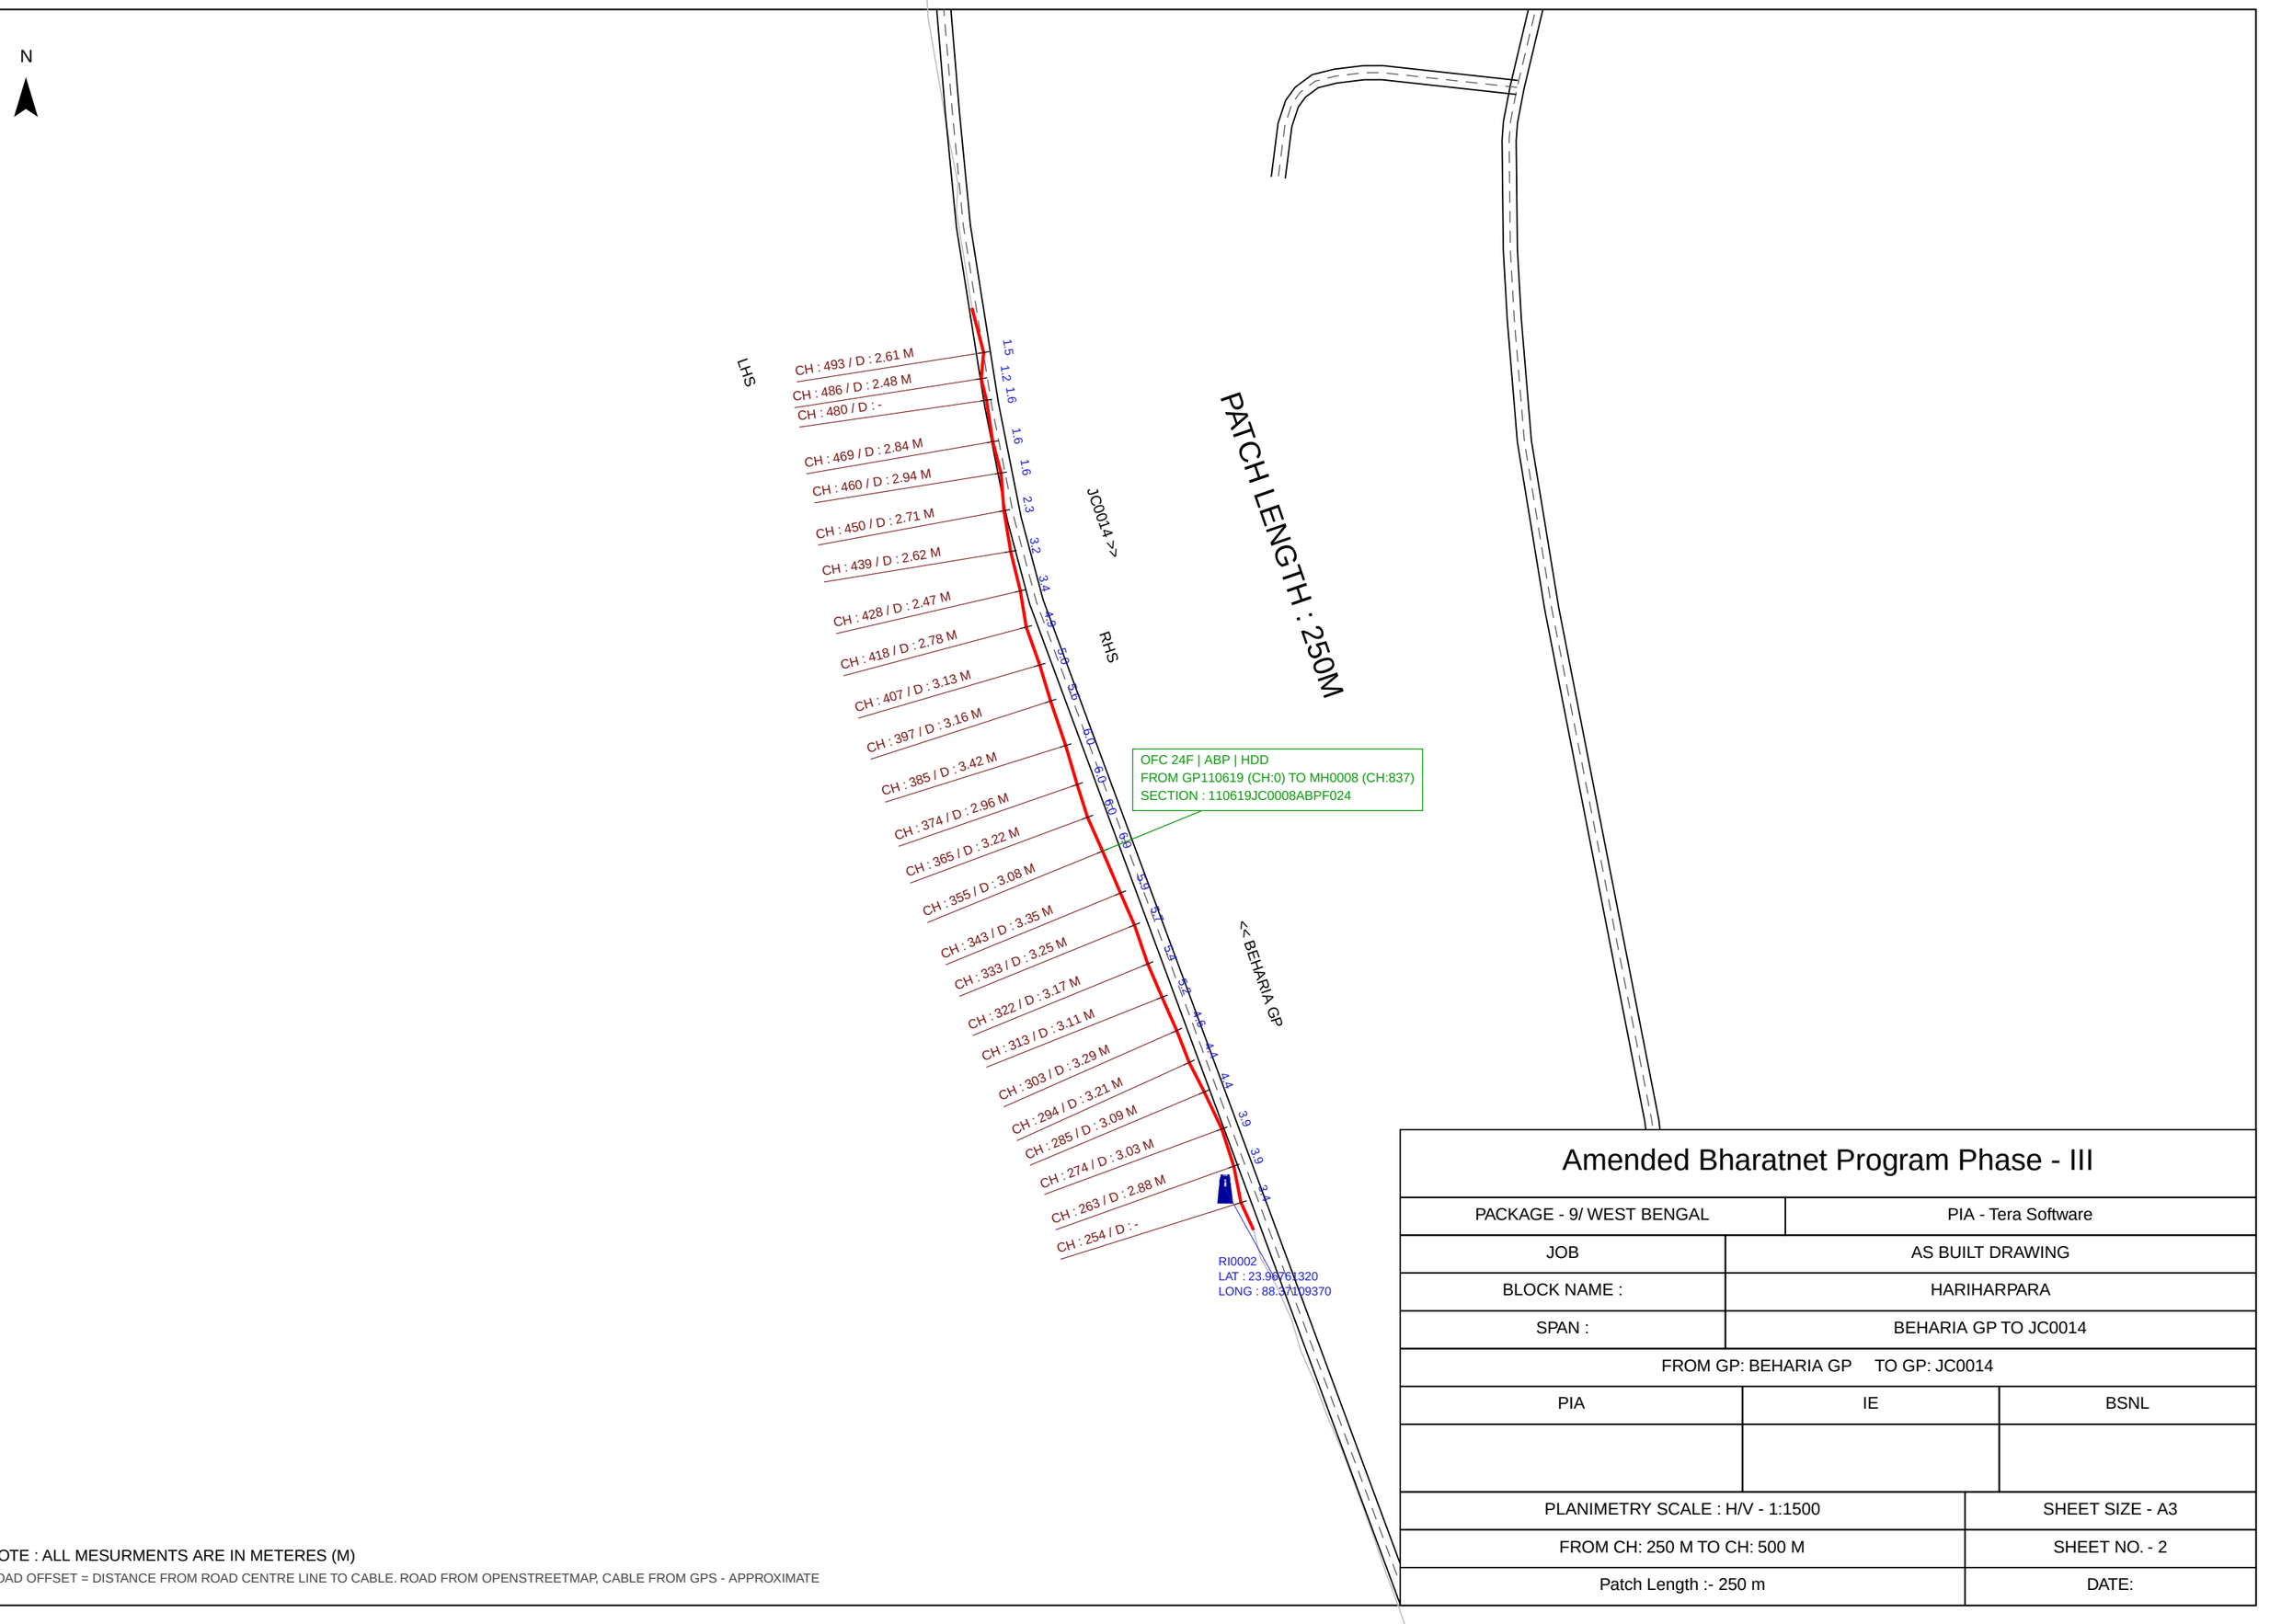

NOTE : ALL MESURMENTS ARE IN METERES (M)


ROAD OFFSET = DISTANCE FROM ROAD CENTRE LINE TO CABLE. ROAD FROM OPENSTREETMAP, CABLE FROM GPS - APPROXIMATE

Amended Bharatnet Program Phase - III

PACKAGE - 9/ WEST BENGAL	PIA - Tera Software
JOB	AS BUILT DRAWING
BLOCK NAME :	HARIHARPARA
SPAN :	BEHARIA GP TO JC0014
FROM GP: BEHARIA GP TO GP: JC0014	

PIA	IE	BSNL

PLANIMETRY SCALE : H/V - 1:1500	SHEET SIZE - A3
FROM CH: 250 M TO CH: 500 M	SHEET NO. - 2
Patch Length :- 250 m	DATE:

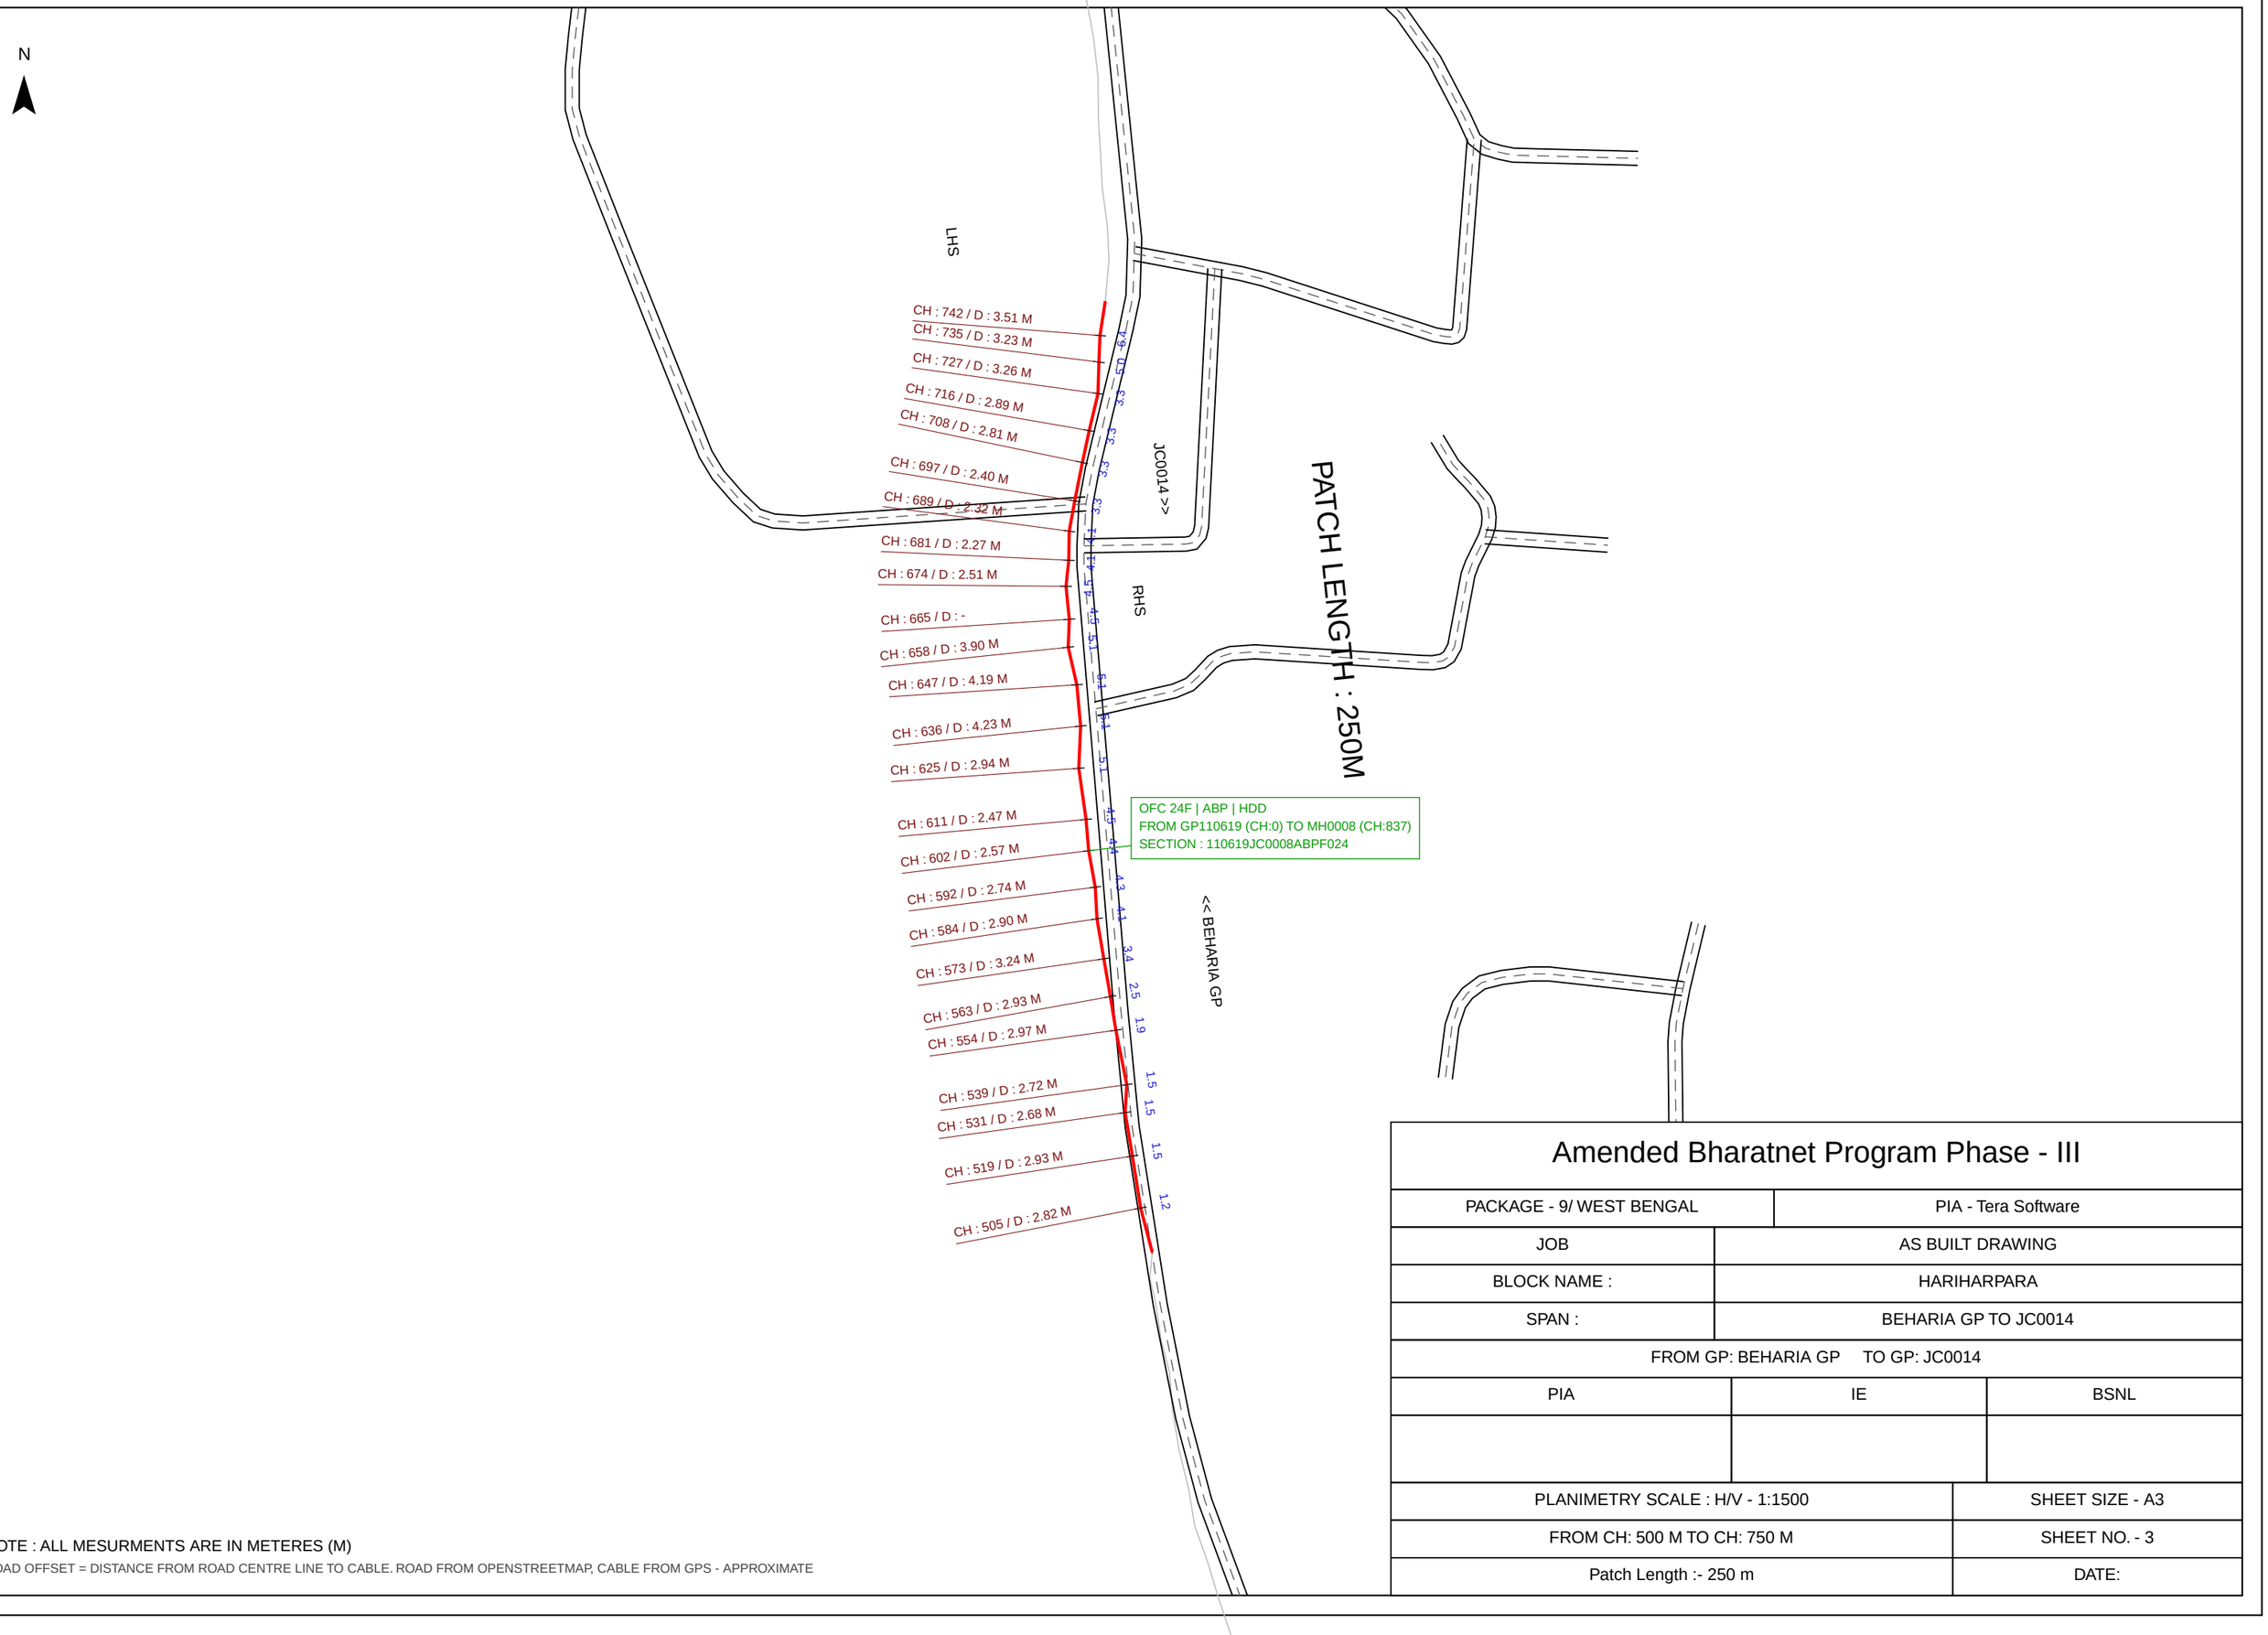

NOTE : ALL MESURMENTS ARE IN METERES (M)

ROAD OFFSET = DISTANCE FROM ROAD CENTRE LINE TO CABLE. ROAD FROM OPENSTREETMAP, CABLE FROM GPS - APPROXIMATE

Amended Bharatnet Program Phase - III

PACKAGE - 9/ WEST BENGAL	PIA - Tera Software
JOB	AS BUILT DRAWING
BLOCK NAME :	HARIHARPARA
SPAN :	BEHARIA GP TO JC0014
FROM GP: BEHARIA GP TO GP: JC0014	

PIA	IE	BSNL

PLANIMETRY SCALE : H/V - 1:1500	SHEET SIZE - A3
FROM CH: 500 M TO CH: 750 M	SHEET NO. - 3
Patch Length :- 250 m	DATE:

N

OFC 24F | ABP | HDD
FROM MH0008 (CH:837) TO MH0009 (CH:2722)
SECTION : JC0008JC0009ABPF024
DRUM ID : H2570 | CABLE (0479-1399)

CH : 984 / D : 2.40 M
CH : 970 / D : 2.38 M
CH : 959 / D : 2.32 M
CH : 947 / D : 2.59 M
CH : 940 / D : 2.42 M
CH : 929 / D : 2.40 M
CH : 922 / D : 2.68 M
CH : 911 / D : 2.89 M
CH : 899 / D : 3.39 M
CH : 890 / D : 3.19 M
CH : 879 / D : 3.23 M
CH : 868 / D : 3.31 M
CH : 860 / D : 3.65 M
CH : 849 / D : 3.42 M
CH : 837 / D : -
CH : 823 / D : 2.13 M
CH : 812 / D : 2.58 M
CH : 801 / D : 3.05 M
CH : 792 / D : 2.46 M
CH : 782 / D : 2.60 M
CH : 772 / D : 2.38 M
CH : 762 / D : 3.09 M
CH : 752 / D : 2.85 M

LHS
RHS
JC0014 >>
<< BEHARIA GP
PATCH LENGTH : 250M

MH0008 / JC0008 SJC (CH:837)
24F Cable | DRUM ID : H2570 START (M 0479)
LAT : 23.97268490
LONG : 88.37028240

R10003
LAT : 23.97270390
LONG : 88.37024640

OFC 24F | ABP | HDD
FROM GP110619 (CH:0) TO MH0008 (CH:837)
SECTION : 110619JC0008ABPF024

NOTE : ALL MESURMENTS ARE IN METERES (M)
ROAD OFFSET = DISTANCE FROM ROAD CENTRE LINE TO CABLE. ROAD FROM OPENSTREETMAP, CABLE FROM GPS - APPROXIMATE

Amended Bharatnet Program Phase - III

PACKAGE - 9/ WEST BENGAL	PIA - Tera Software	
JOB	AS BUILT DRAWING	
BLOCK NAME :	HARIHARPARA	
SPAN :	BEHARIA GP TO JC0014	
FROM GP: BEHARIA GP TO GP: JC0014		
PIA	IE	BSNL
PLANIMETRY SCALE : H/V - 1:1000	SHEET SIZE - A3	
FROM CH: 750 M TO CH: 1000 M	SHEET NO. - 4	
Patch Length :- 250 m	DATE:	

N

PATCH LENGTH : 250M

JC0014 >7

<< BEHARIA GP

RHS

LHS

CH : 1243 / D : 3.67 M

CH : 1231 / D : 2.88 M

CH : 1223 / D : 3.04 M

CH : 1215 / D : 2.46 M

CH : 1207 / D : 2.73 M

CH : 1199 / D : 2.41 M

CH : 1190 / D : 2.81 M

CH : 1182 / D : 2.90 M

CH : 1171 / D : 2.94 M

CH : 1161 / D : 3.20 M

CH : 1152 / D : 3.64 M

CH : 1143 / D : 4.36 M

CH : 1132 / D : 5.45 M

CH : 1124 / D : 5.72 M

CH : 1115 / D : 7.11 M

CH : 1106 / D : 7.21 M

CH : 1096 / D : 6.56 M

CH : 1087 / D : 3.86 M

CH : 1079 / D : -

CH : 1070 / D : 2.08 M

CH : 1060 / D : 2.28 M

CH : 1051 / D : 2.49 M

CH : 1042 / D : 2.43 M

CH : 1031 / D : 2.42 M

CH : 1024 / D : 2.30 M

CH : 1011 / D : 2.32 M

CH : 1001 / D : 2.35 M

OFC 24F | ABP | HDD
FROM MH0008 (CH:837) TO MH0009 (CH:2722)
SECTION : JC0008JC0009ABPF024
DRUM ID : H2570 | CABLE (0479-1399)

RI0004
LAT : 23.97428240
LONG : 88.36887290

CULVERT L : 6.1 M (PR)

NOTE : ALL MESURMENTS ARE IN METERES (M)


ROAD OFFSET = DISTANCE FROM ROAD CENTRE LINE TO CABLE. ROAD FROM OPENSTREETMAP, CABLE FROM GPS - APPROXIMATE

Amended Bharatnet Program Phase - III

PACKAGE - 9/ WEST BENGAL	PIA - Tera Software
JOB	AS BUILT DRAWING
BLOCK NAME :	HARIHARPARA
SPAN :	BEHARIA GP TO JC0014
FROM GP: BEHARIA GP	TO GP: JC0014

PIA	IE	BSNL

PLANIMETRY SCALE : H/V - 1:1000	SHEET SIZE - A3
FROM CH: 1000 M TO CH: 1250 M	SHEET NO. - 5
Patch Length :- 250 m	DATE:

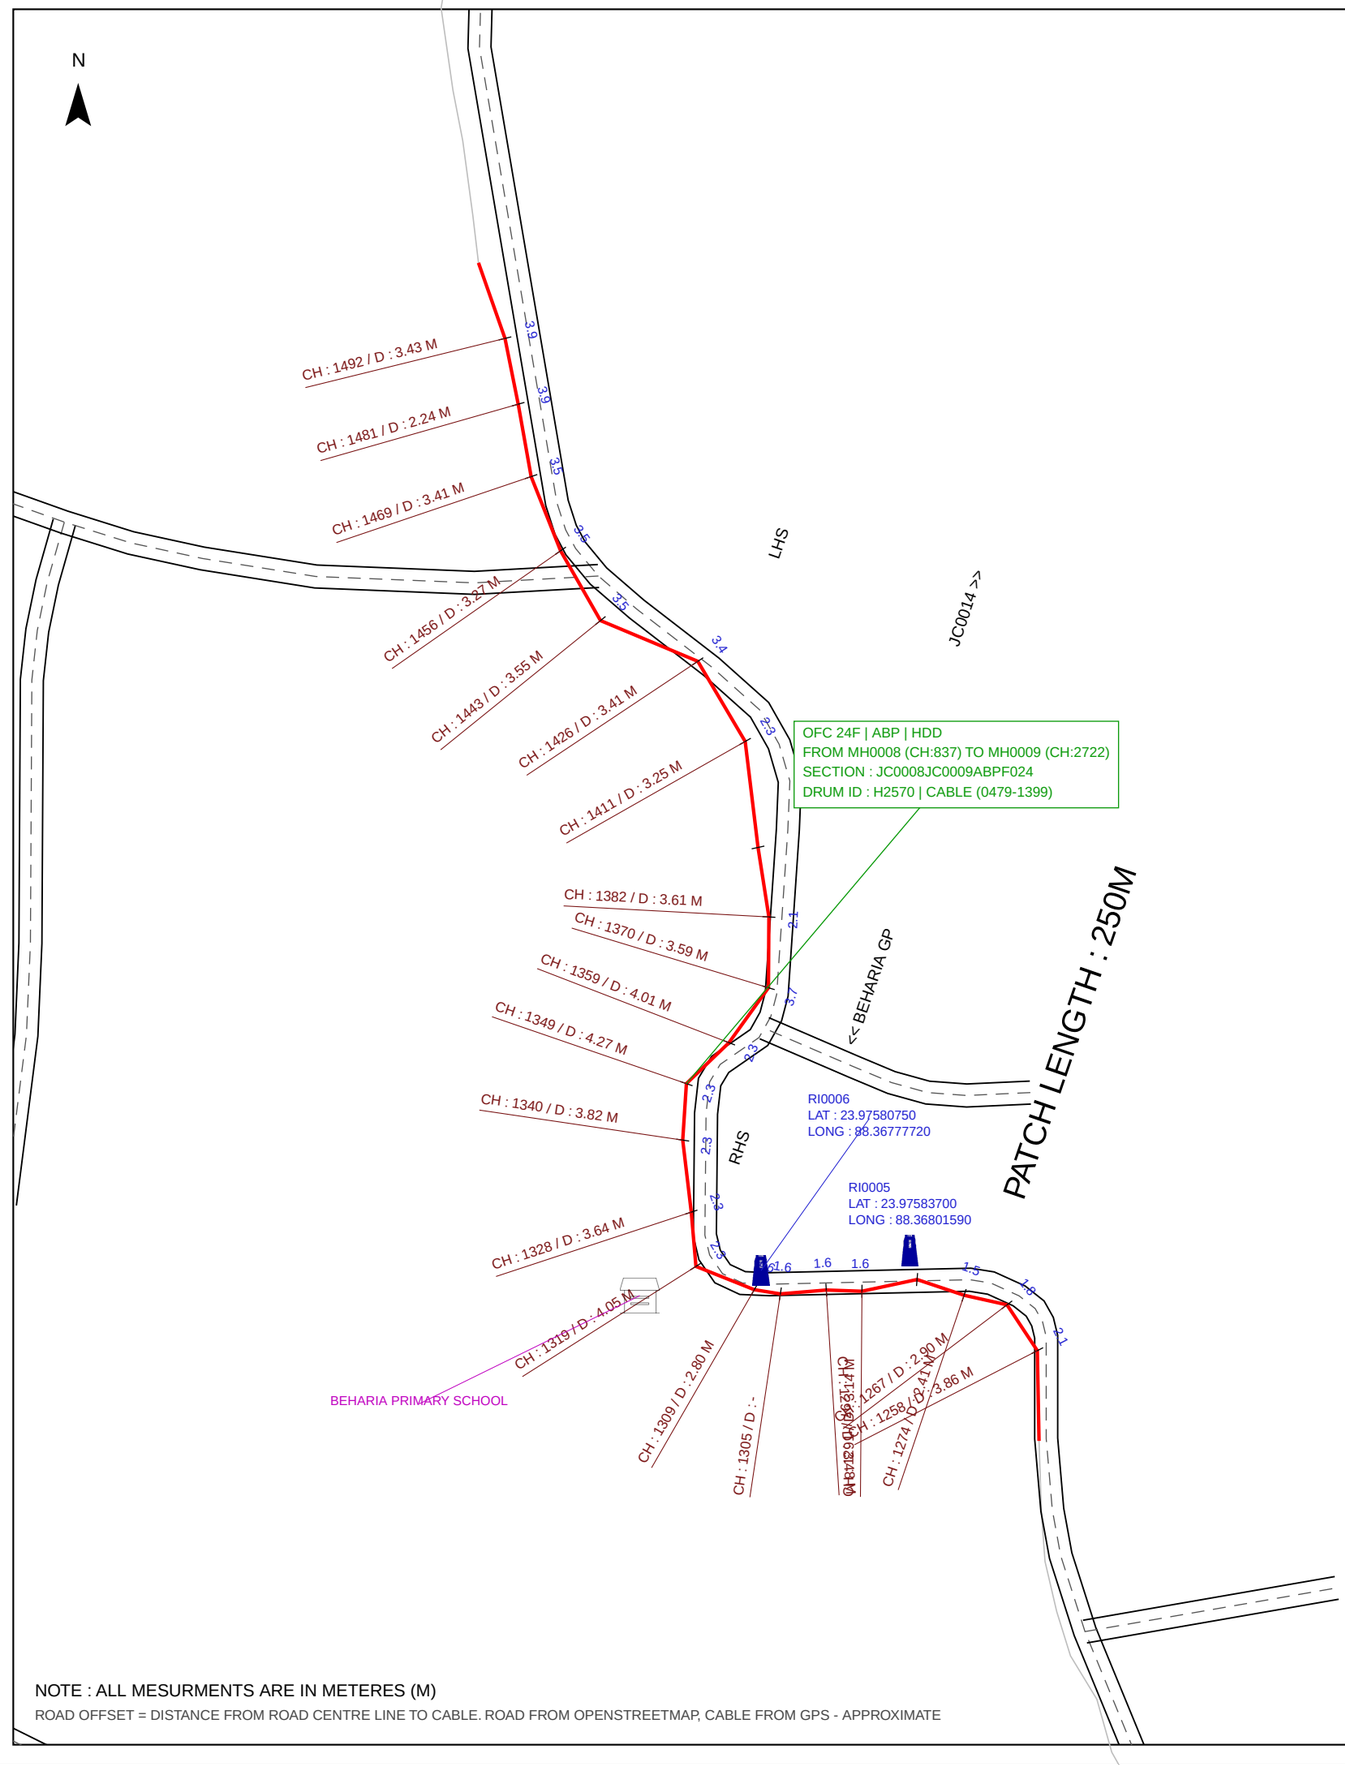

NOTE : ALL MESURMENTS ARE IN METERES (M)

ROAD OFFSET = DISTANCE FROM ROAD CENTRE LINE TO CABLE. ROAD FROM OPENSTREETMAP, CABLE FROM GPS - APPROXIMATE

Amended Bharatnet Program Phase - III

PACKAGE - 9/ WEST BENGAL	PIA - Tera Software
JOB	AS BUILT DRAWING
BLOCK NAME :	HARIHARPARA
SPAN :	BEHARIA GP TO JC0014
FROM GP: BEHARIA GP TO GP: JC0014	

PIA	IE	BSNL

PLANIMETRY SCALE : H/V - 1:1000	SHEET SIZE - A3
FROM CH: 1250 M TO CH: 1500 M	SHEET NO. - 6
Patch Length :- 250 m	DATE:

N

CH : 1749 / D : 2.63 M

CH : 1736 / D : 2.82 M

CH : 1724 / D : 2.44 M

CH : 1711 / D : 2.40 M

CH : 1696 / D : 2.89 M

CH : 1681 / D : 2.90 M

CH : 1669 / D : 2.54 M

CH : 1658 / D : 2.77 M

CH : 1650 / D : 2.41 M

CH : 1636 / D : -

CH : 1627 / D : 3.41 M

CH : 1617 / D : 3.47 M

CH : 1606 / D : 3.42 M

CH : 1596 / D : 3.48 M

CH : 1586 / D : 3.53 M

CH : 1572 / D : 3.62 M

CH : 1562 / D : 3.65 M

CH : 1548 / D : 3.65 M

CH : 1534 / D : 3.47 M

CH : 1526 / D : 3.49 M

CH : 1513 / D : 3.53 M

CH : 1505 / D : 3.36 M

LHS

RHS

JC0014 >>

<< BEHARIA GP

OFC 24F | ABP | HDD
FROM MH0008 (CH:837) TO MH0009 (CH:2722)
SECTION : JC0008JC0009ABPF024
DRUM ID : H2570 | CABLE (0479-1399)


PATCH LENGTH : 250M

NOTE : ALL MESURMENTS ARE IN METERES (M)

ROAD OFFSET = DISTANCE FROM ROAD CENTRE LINE TO CABLE. ROAD FROM OPENSTREETMAP, CABLE FROM GPS - APPROXIMATE

Amended Bharatnet Program Phase - III

PACKAGE - 9/ WEST BENGAL	PIA - Tera Software	
JOB	AS BUILT DRAWING	
BLOCK NAME :	HARIHARPARA	
SPAN :	BEHARIA GP TO JC0014	
FROM GP: BEHARIA GP TO GP: JC0014		
PIA	IE	BSNL
PLANIMETRY SCALE : H/V - 1:1500	SHEET SIZE - A3	
FROM CH: 1500 M TO CH: 1750 M	SHEET NO. - 7	
Patch Length :- 250 m	DATE:	

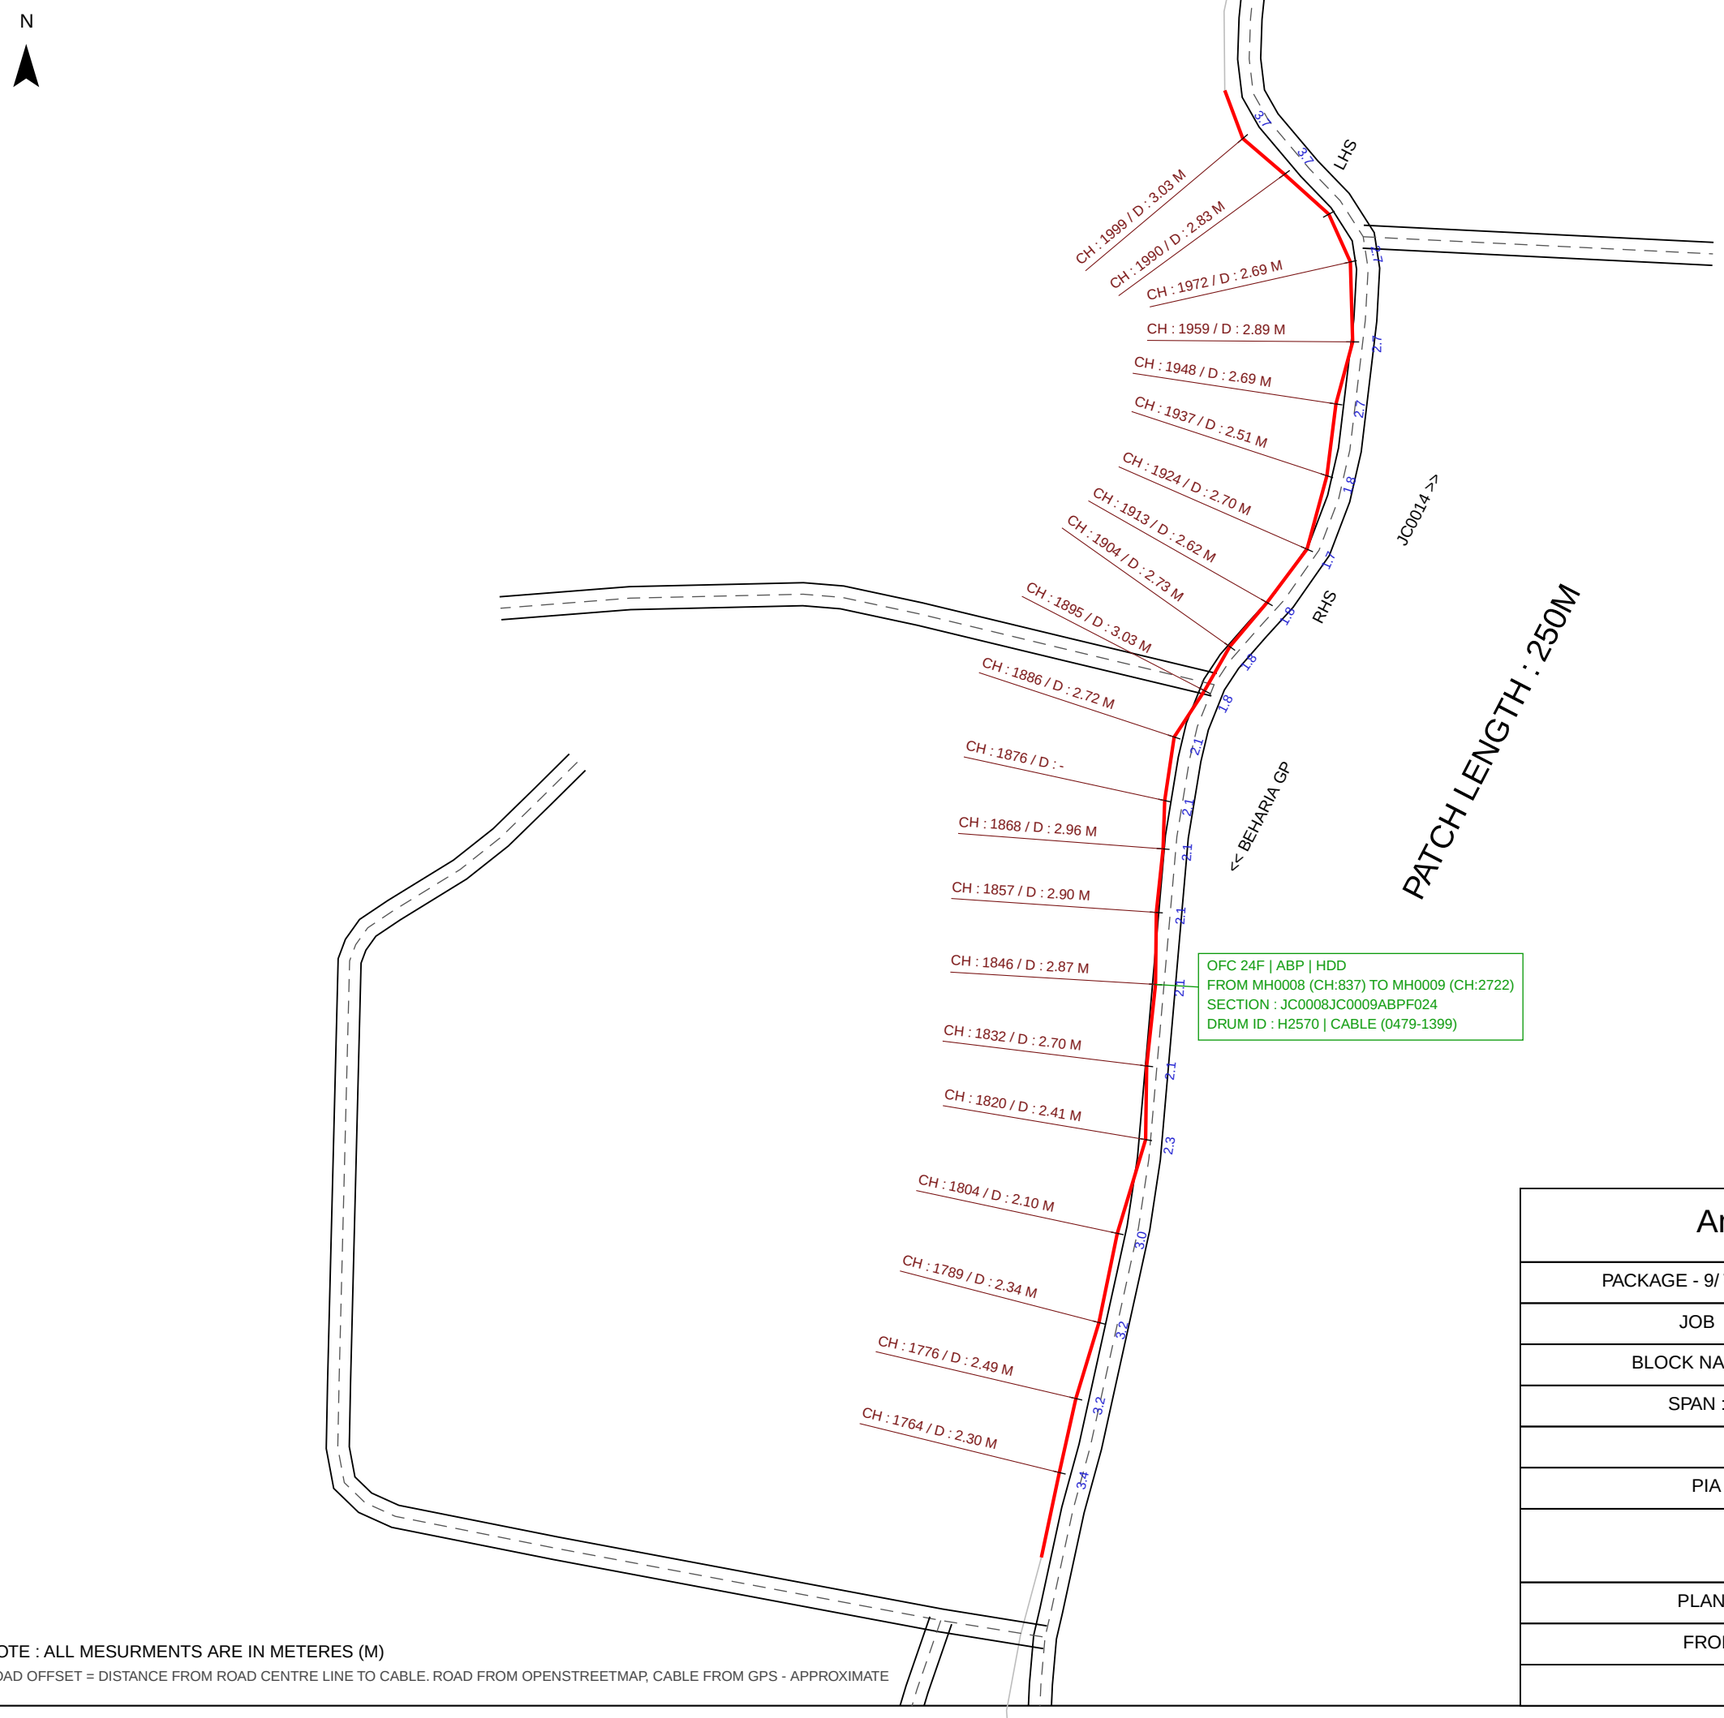

NOTE : ALL MESURMENTS ARE IN METERES (M)


ROAD OFFSET = DISTANCE FROM ROAD CENTRE LINE TO CABLE. ROAD FROM OPENSTREETMAP, CABLE FROM GPS - APPROXIMATE

Amended Bharatnet Program Phase - III

PACKAGE - 9/ WEST BENGAL	PIA - Tera Software
JOB	AS BUILT DRAWING
BLOCK NAME :	HARIHARPARA
SPAN :	BEHARIA GP TO JC0014
FROM GP: BEHARIA GP	TO GP: JC0014

PIA	IE	BSNL

PLANIMETRY SCALE : H/V - 1:1000	SHEET SIZE - A3
FROM CH: 1750 M TO CH: 2000 M	SHEET NO. - 8
Patch Length :- 250 m	DATE:

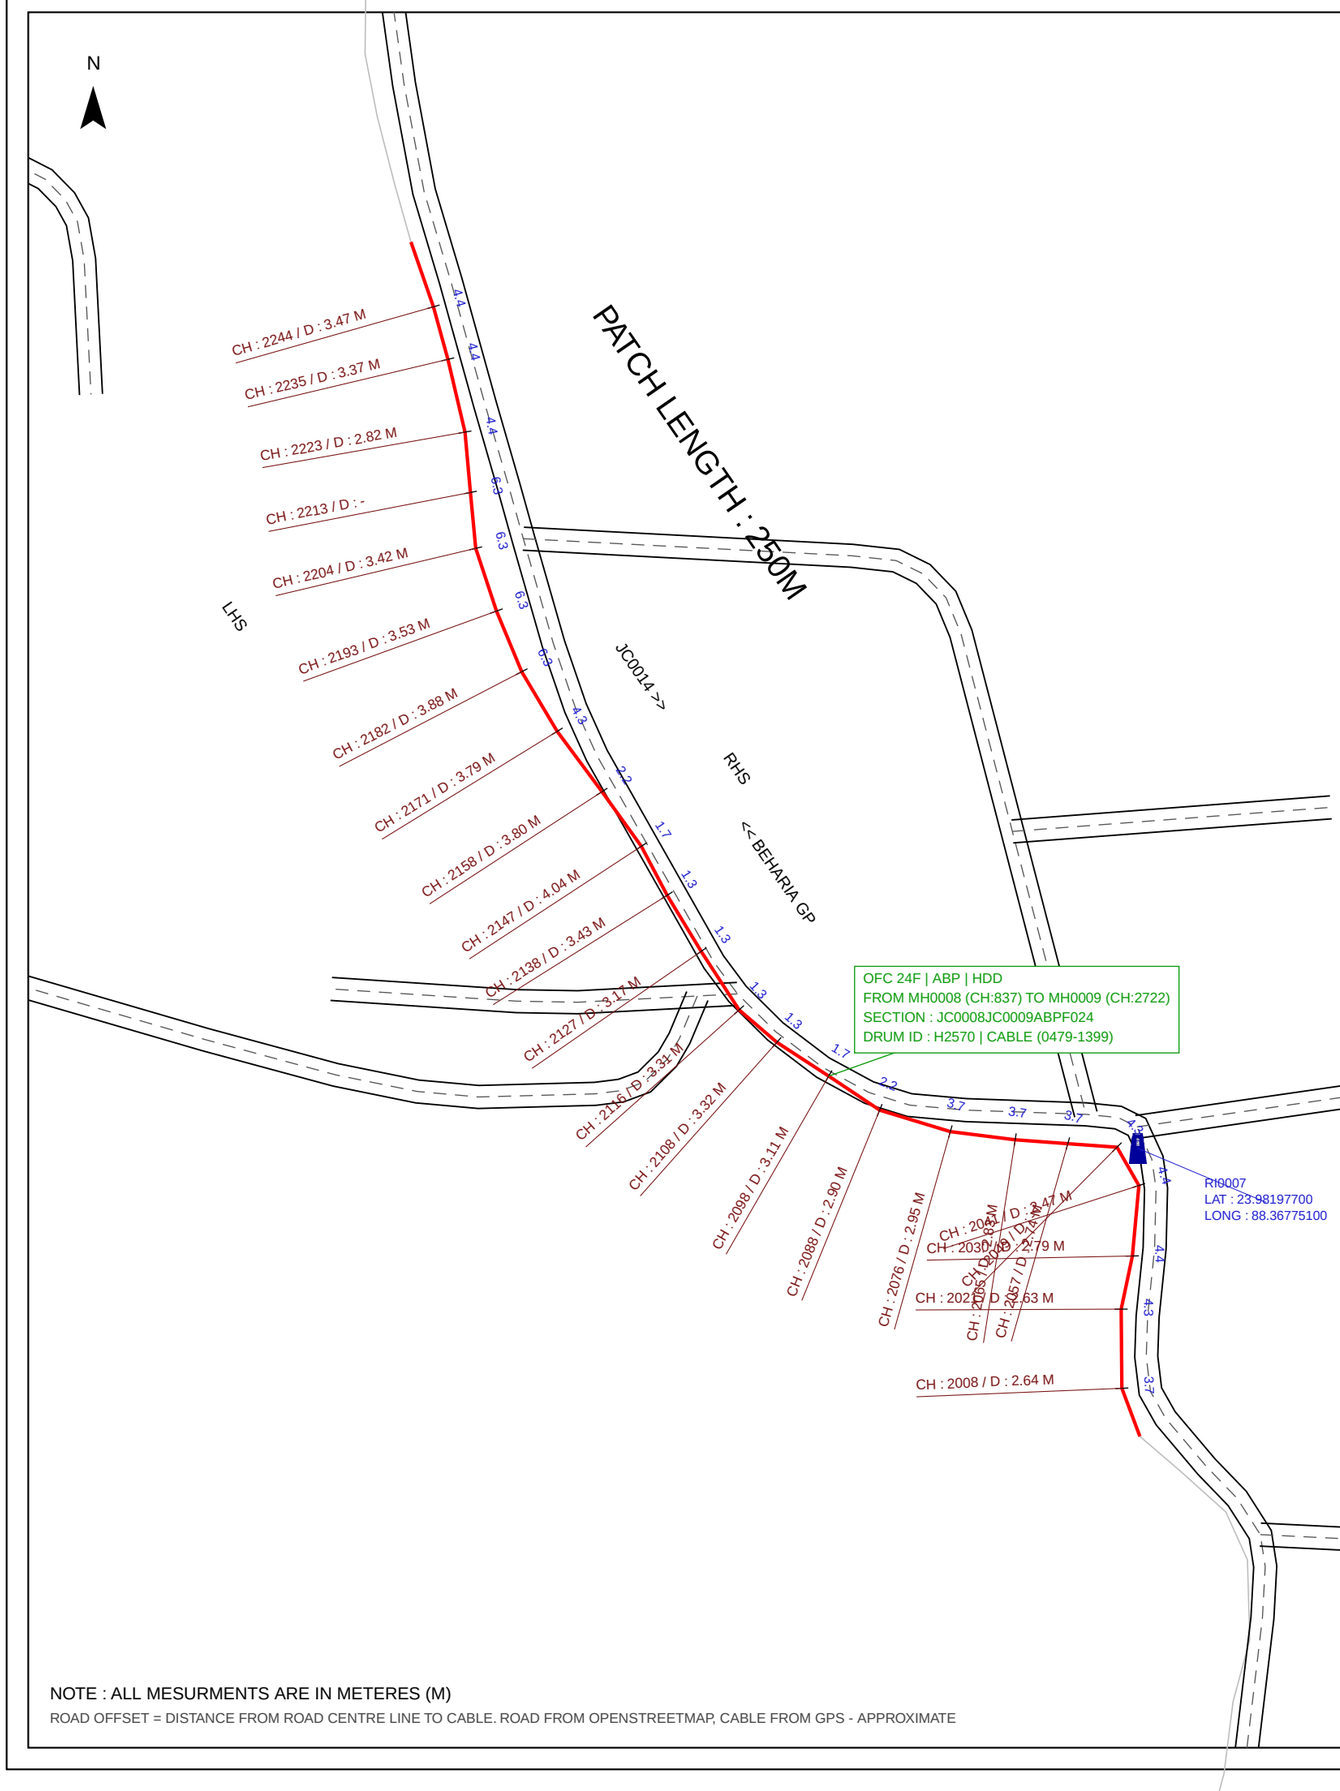

NOTE : ALL MESURMENTS ARE IN METERES (M)


ROAD OFFSET = DISTANCE FROM ROAD CENTRE LINE TO CABLE. ROAD FROM OPENSTREETMAP, CABLE FROM GPS - APPROXIMATE

Amended Bharatnet Program Phase - III

PACKAGE - 9/ WEST BENGAL	PIA - Tera Software
JOB	AS BUILT DRAWING
BLOCK NAME :	HARIHARPARA
SPAN :	BEHARIA GP TO JC0014
FROM GP: BEHARIA GP TO GP: JC0014	

PIA	IE	BSNL

PLANIMETRY SCALE : H/V - 1:1000	SHEET SIZE - A3
FROM CH: 2000 M TO CH: 2250 M	SHEET NO. - 9
Patch Length :- 250 m	DATE:

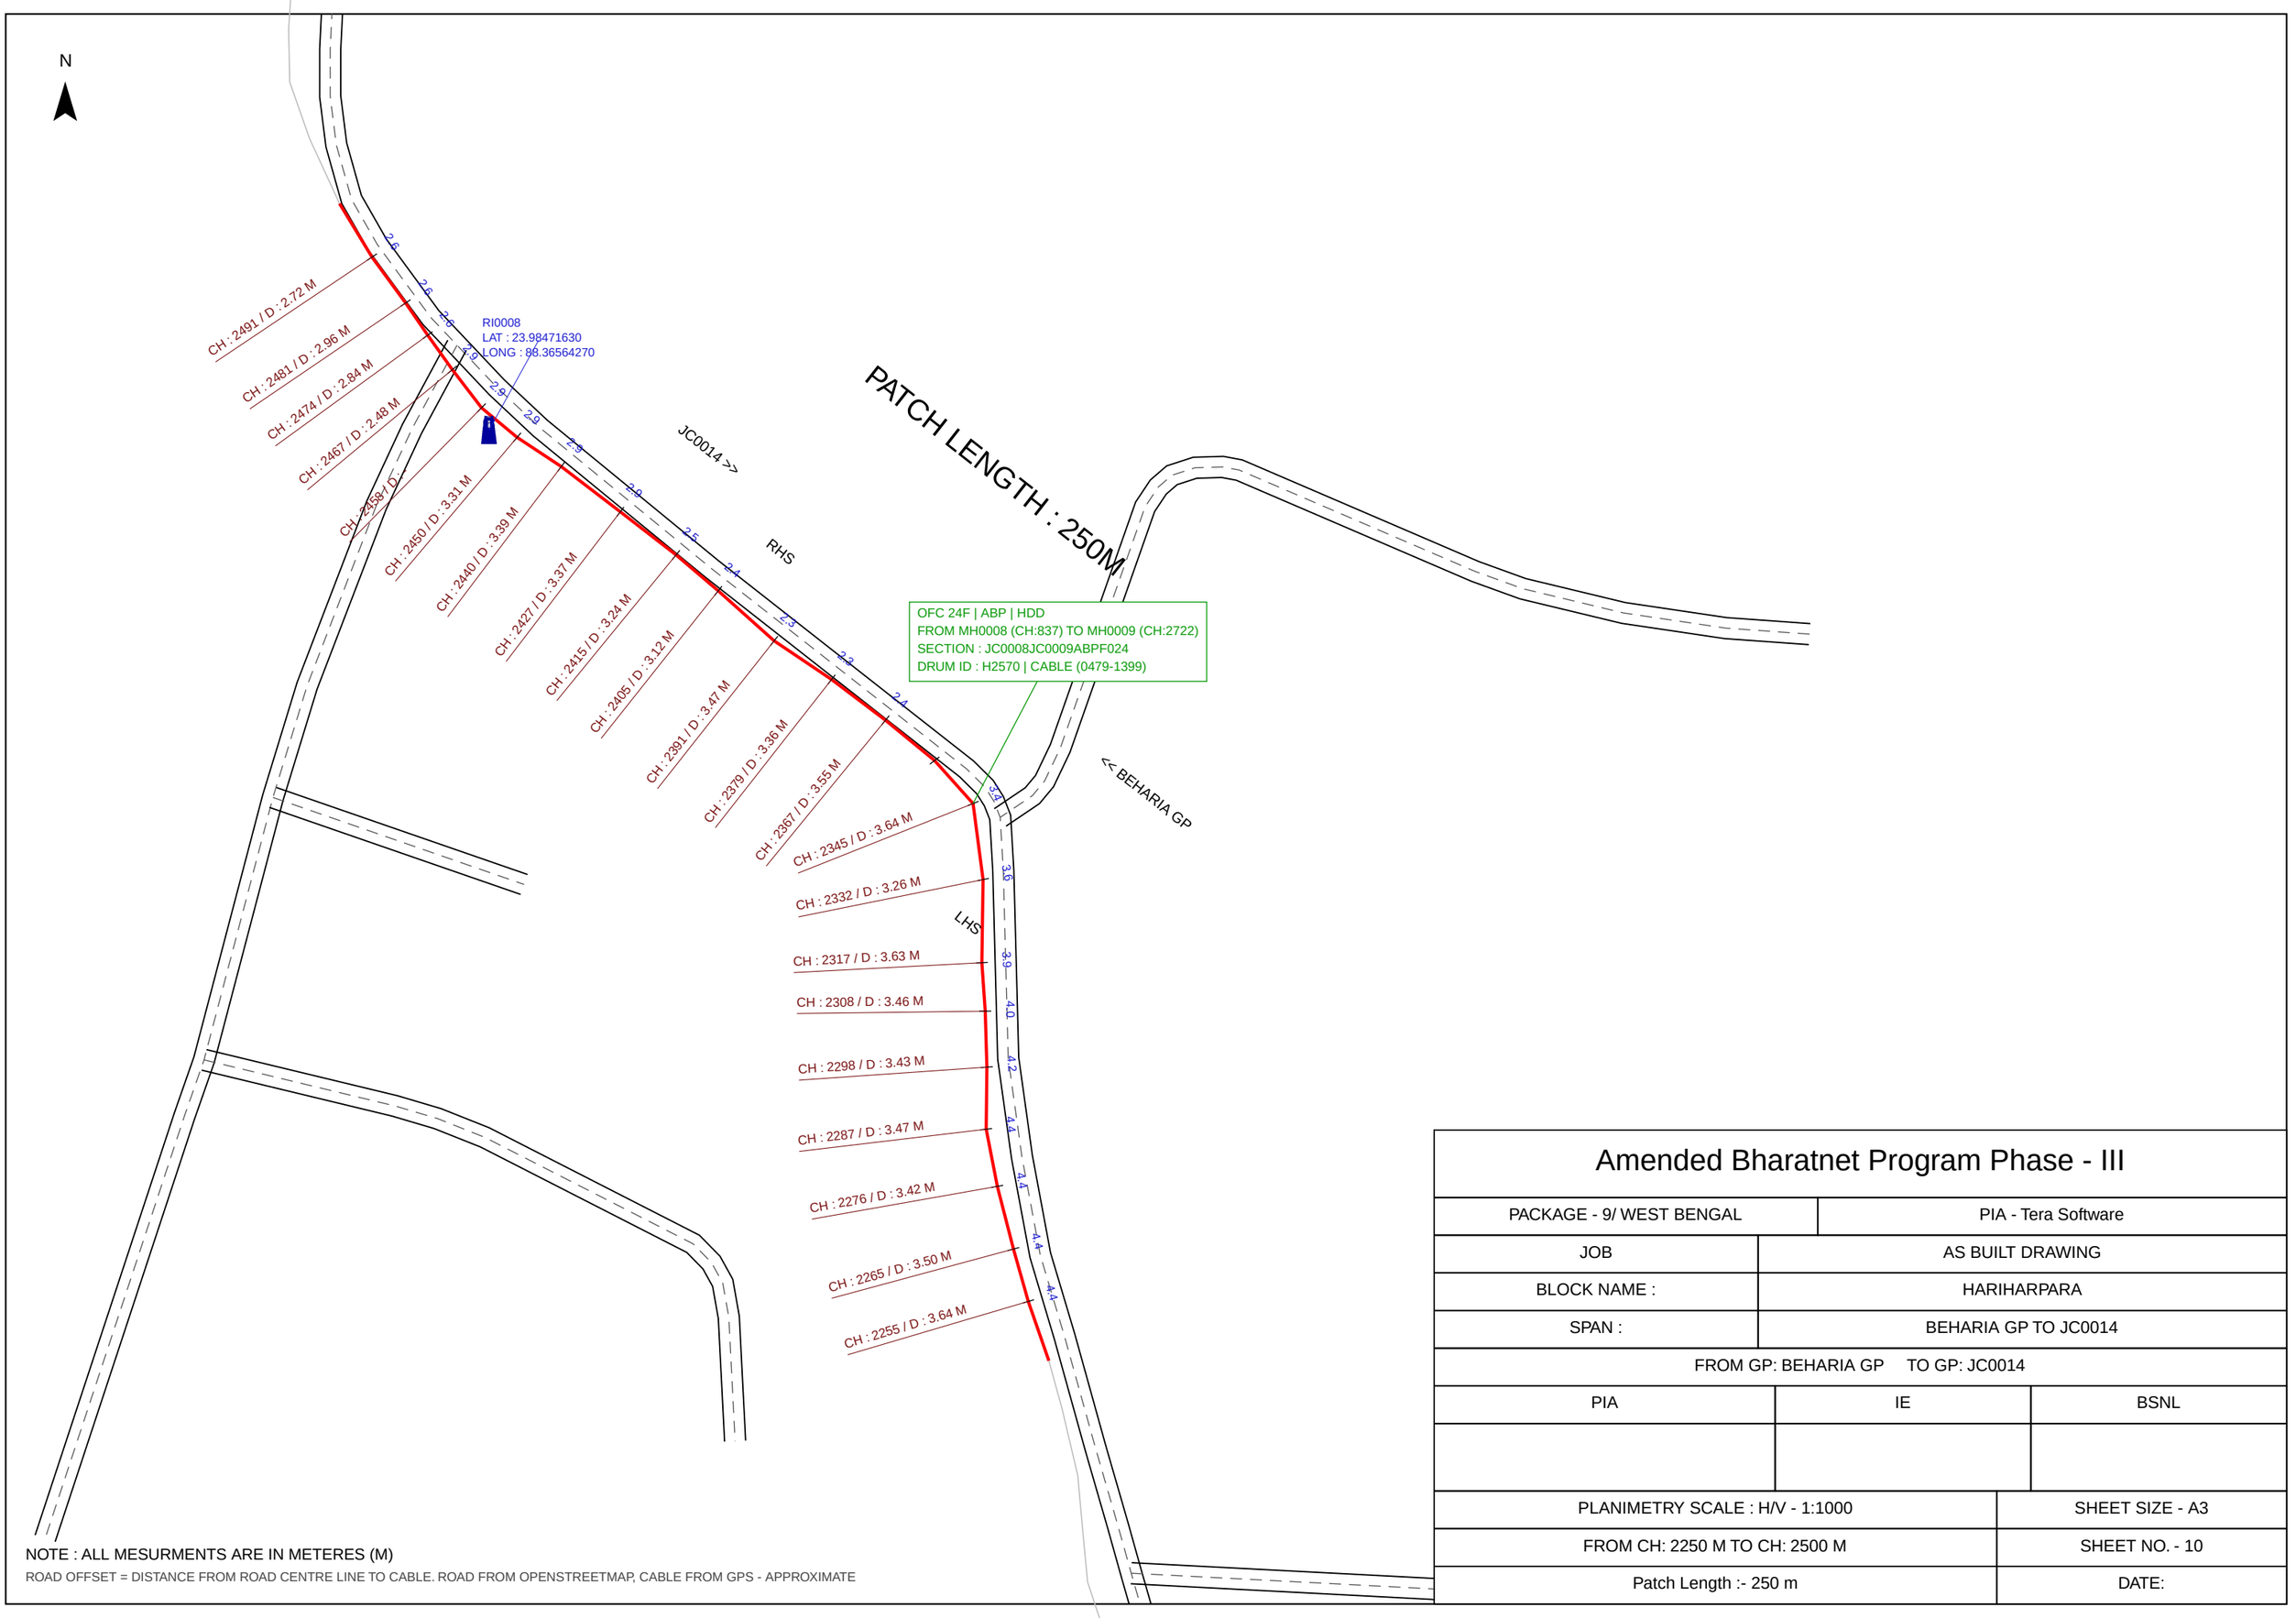

NOTE : ALL MESURMENTS ARE IN METERES (M)

ROAD OFFSET = DISTANCE FROM ROAD CENTRE LINE TO CABLE. ROAD FROM OPENSTREETMAP, CABLE FROM GPS - APPROXIMATE

Amended Bharatnet Program Phase - III

PACKAGE - 9/ WEST BENGAL	PIA - Tera Software
JOB	AS BUILT DRAWING
BLOCK NAME :	HARIHARPARA
SPAN :	BEHARIA GP TO JC0014
FROM GP: BEHARIA GP TO GP: JC0014	

PIA	IE	BSNL

PLANIMETRY SCALE : H/V - 1:1000	SHEET SIZE - A3
FROM CH: 2250 M TO CH: 2500 M	SHEET NO. - 10
Patch Length :- 250 m	DATE:

N

OFC 24F | ABP | HDD
FROM MH0009 (CH:2722) TO MH0010 (CH:4617)
SECTION : JC0009JC0010ABPF024
DRUM ID : H2679 | CABLE (0168-2059)

RAMKRISHNAPUR BUS STOP

LHS

RH0009
LAT : 23.98703280
LONG : 88.36527550

MH0009 / JC0009 SJC (CH:2722)
24F Cable | DRUM ID : H2679 START (M 0168)
LAT : 23.98702400
LONG : 88.36527620

CH : 2709 / D : 2.95 M
CH : 2717 / D : 3.90 M
CH : 2698 / D : 3.69 M
CH : 2686 / D : 3.90 M
CH : 2676 / D : 3.68 M
CH : 2663 / D : 4.12 M
CH : 2652 / D : 3.75 M
CH : 2641 / D : 3.62 M
CH : 2630 / D : 3.71 M
CH : 2616 / D : 3.76 M
CH : 2605 / D : 3.45 M
CH : 2592 / D : 3.52 M
CH : 2581 / D : 3.43 M
CH : 2570 / D : 3.94 M
CH : 2558 / D : 3.72 M
CH : 2547 / D : 3.69 M
CH : 2535 / D : 3.44 M
CH : 2526 / D : 3.23 M
CH : 2515 / D : 2.80 M
CH : 2502 / D : 2.62 M

RHS

JC0014 >>

<< BEHARIA GP

PATCH LENGTH : 250M

OFC 24F | ABP | HDD
FROM MH0008 (CH:837) TO MH0009 (CH:2722)
SECTION : JC0008JC0009ABPF024
DRUM ID : H2570 | CABLE (0479-1399)

NOTE : ALL MESURMENTS ARE IN METERES (M)


ROAD OFFSET = DISTANCE FROM ROAD CENTRE LINE TO CABLE. ROAD FROM OPENSTREETMAP, CABLE FROM GPS - APPROXIMATE

Amended Bharatnet Program Phase - III

PACKAGE - 9/ WEST BENGAL	PIA - Tera Software
JOB	AS BUILT DRAWING
BLOCK NAME :	HARIHARPARA
SPAN :	BEHARIA GP TO JC0014
FROM GP: BEHARIA GP TO GP: JC0014	

PIA	IE	BSNL

PLANIMETRY SCALE : H/V - 1:1500	SHEET SIZE - A3
FROM CH: 2500 M TO CH: 2750 M	SHEET NO. - 11
Patch Length :- 250 m	DATE:

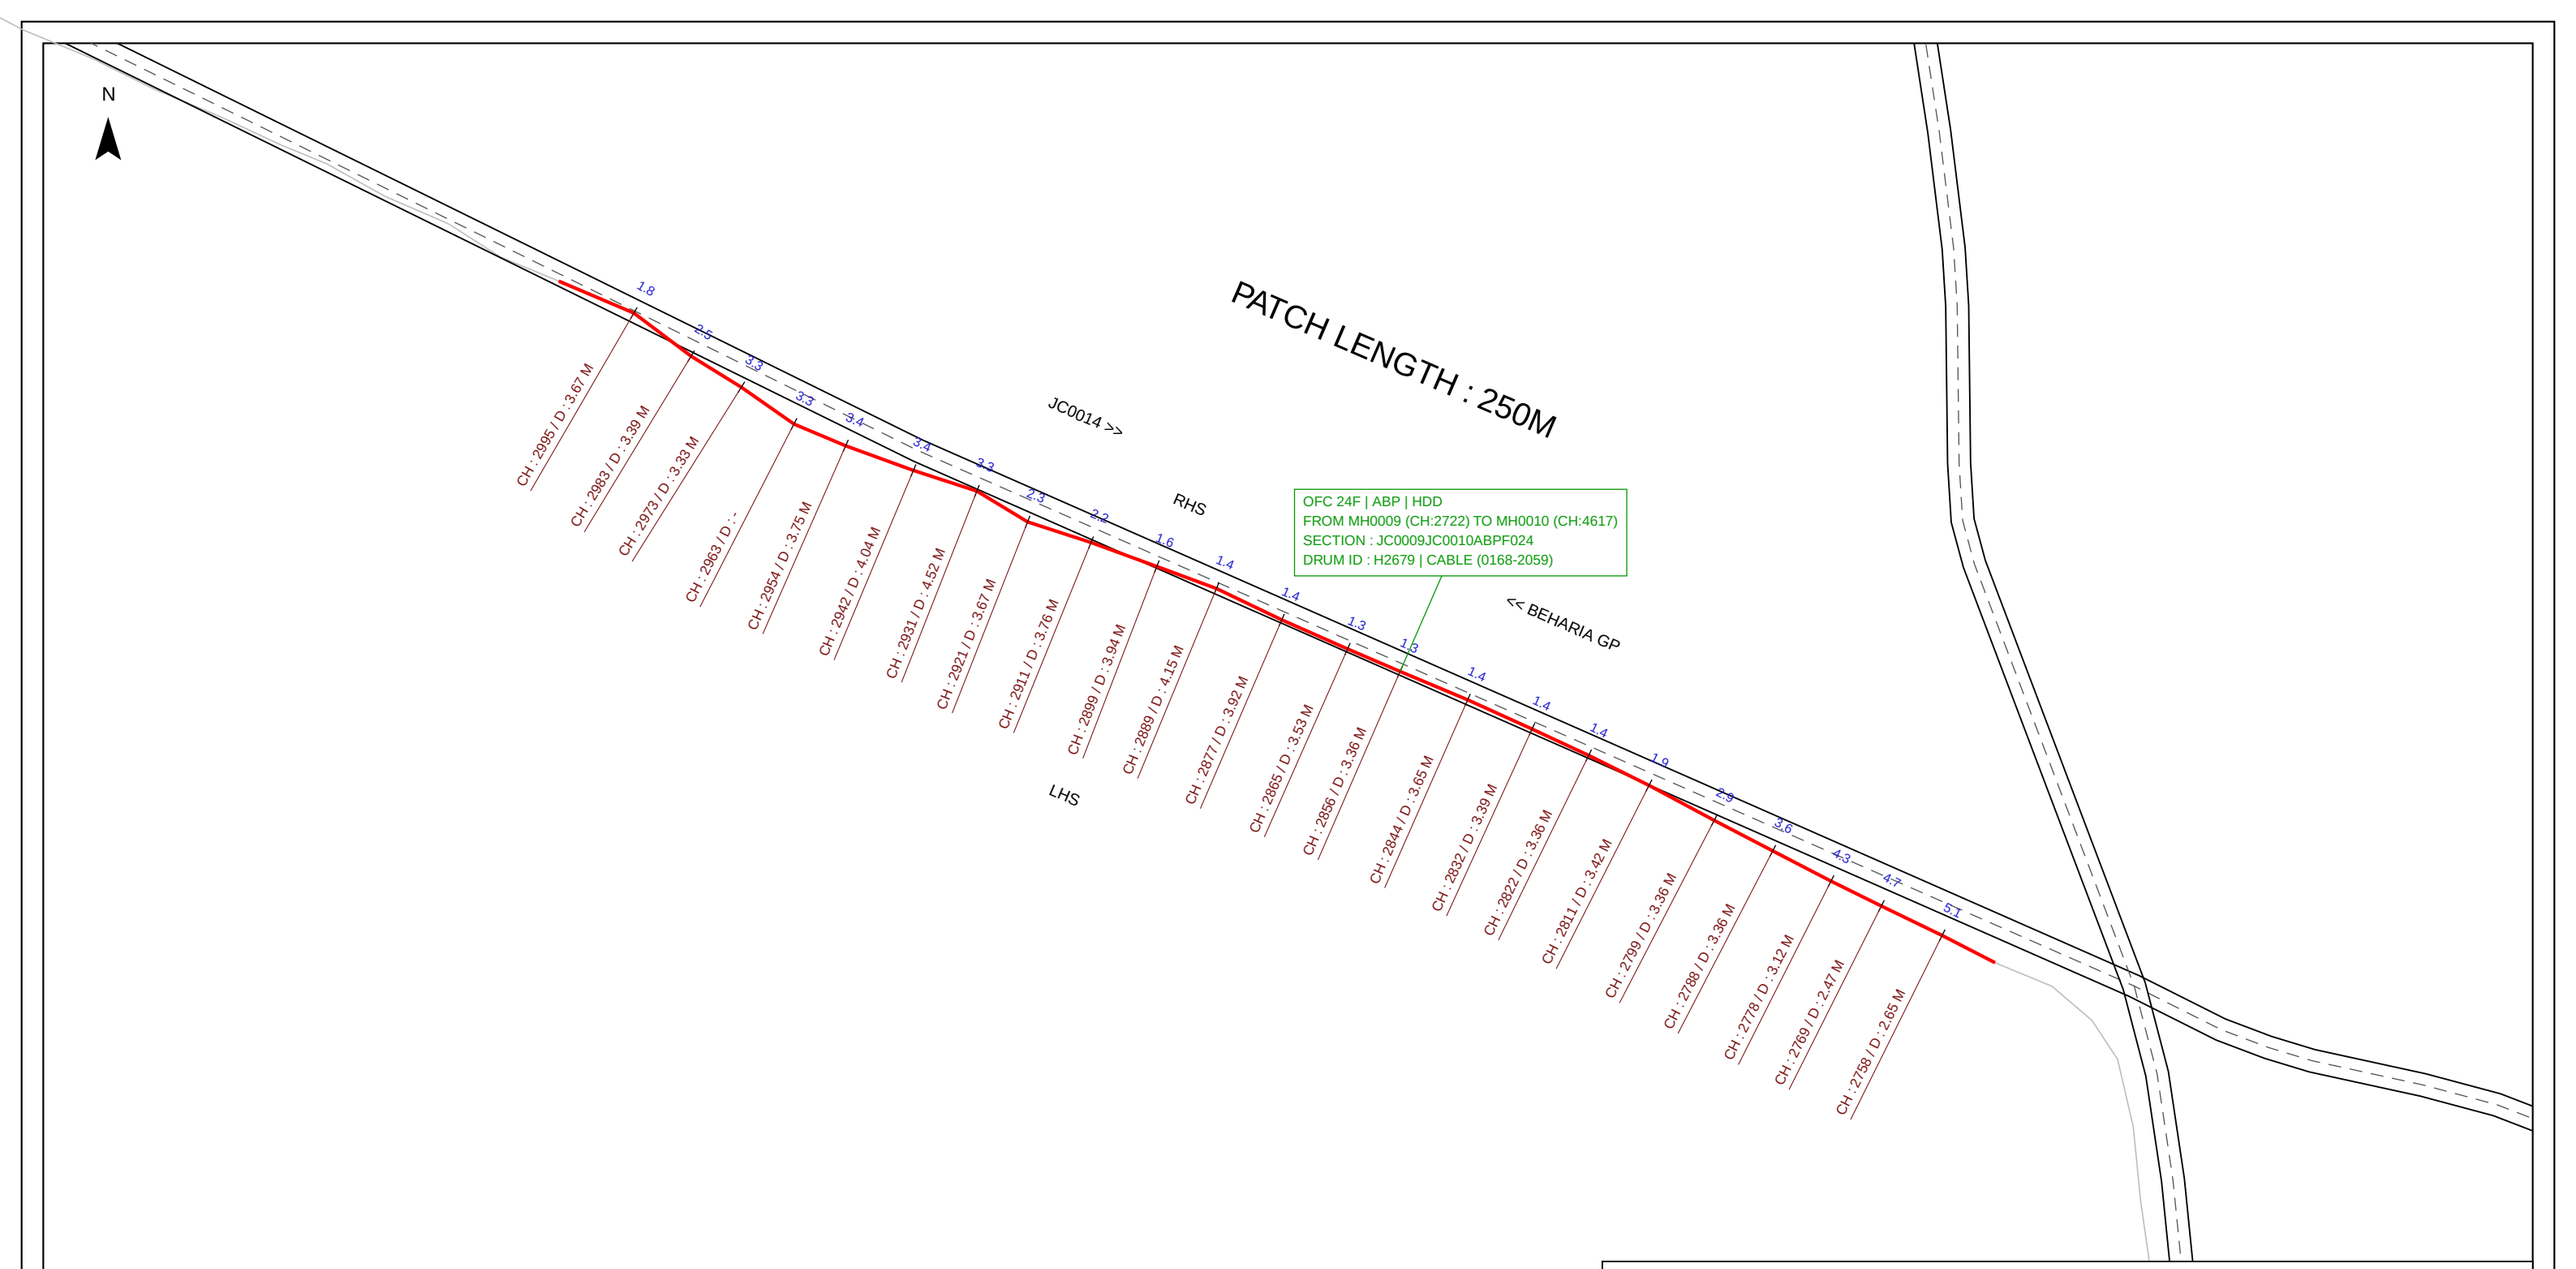

NOTE : ALL MESURMENTS ARE IN METERES (M)

ROAD OFFSET = DISTANCE FROM ROAD CENTRE LINE TO CABLE. ROAD FROM OPENSTREETMAP, CABLE FROM GPS - APPROXIMATE

Amended Bharatnet Program Phase - III

PACKAGE - 9/ WEST BENGAL	PIA - Tera Software
JOB	AS BUILT DRAWING
BLOCK NAME :	HARIHARPARA
SPAN :	BEHARIA GP TO JC0014
FROM GP: BEHARIA GP TO GP: JC0014	

PIA	IE	BSNL

PLANIMETRY SCALE : H/V - 1:1000	SHEET SIZE - A3
FROM CH: 2750 M TO CH: 3000 M	SHEET NO. - 12
Patch Length :- 250 m	DATE:

N

PATCH LENGTH : 250M

RI0010
LAT : 23.98899980
LONG : 88.36098000

JC0014 >>

RHS

LHS

<< BEHARIA GP

OFC 24F | ABP | HDD
FROM MH0009 (CH:2722) TO MH0010 (CH:4617)
SECTION : JC0009JC0010ABPF024
DRUM ID : H2679 | CABLE (0168-2059)

CH : 3248 / D : 3.56 M
CH : 3238 / D : 3.78 M
CH : 3229 / D : 2.63 M
CH : 3216 / D : -
CH : 3202 / D : 3.41 M
CH : 3191 / D : 3.18 M
CH : 3179 / D : 3.43 M
CH : 3169 / D : 3.11 M
CH : 3159 / D : 3.11 M
CH : 3147 / D : 3.26 M
CH : 3135 / D : 2.82 M
CH : 3126 / D : 2.86 M
CH : 3114 / D : 2.99 M
CH : 3105 / D : 3.12 M
CH : 3092 / D : 2.97 M
CH : 3081 / D : 3.10 M
CH : 3069 / D : 2.25 M
CH : 3059 / D : 2.99 M
CH : 3051 / D : 2.87 M
CH : 3040 / D : 2.94 M
CH : 3028 / D : 3.18 M
CH : 3018 / D : 3.28 M
CH : 3008 / D : 3.23 M

NOTE : ALL MESURMENTS ARE IN METERES (M)

ROAD OFFSET = DISTANCE FROM ROAD CENTRE LINE TO CABLE. ROAD FROM OPENSTREETMAP, CABLE FROM GPS - APPROXIMATE

Amended Bharatnet Program Phase - III

PACKAGE - 9/ WEST BENGAL	PIA - Tera Software	
JOB	AS BUILT DRAWING	
BLOCK NAME :	HARIHARPARA	
SPAN :	BEHARIA GP TO JC0014	
FROM GP: BEHARIA GP TO GP: JC0014		
PIA	IE	BSNL
PLANIMETRY SCALE : H/V - 1:1000	SHEET SIZE - A3	
FROM CH: 3000 M TO CH: 3250 M	SHEET NO. - 13	
Patch Length :- 250 m	DATE:	

N

RI0011
LAT : 23.99029320
LONG : 88.35881330

PATCH LENGTH : 250M

JC0014 >>

RHS

LHS

<< BEHARIA GP

OFC 24F | ABP | HDD
FROM MH0009 (CH:2722) TO MH0010 (CH:4617)
SECTION : JC0009JC0010ABPF024
DRUM ID : H2679 | CABLE (0168-2059)

CH : 3491 / D : 2.74 M
CH : 3483 / D : 2.48 M
CH : 3476 / D : -
CH : 3468 / D : 3.64 M
CH : 3461 / D : 3.96 M
CH : 3451 / D : 3.68 M
CH : 3438 / D : 3.23 M
CH : 3424 / D : 2.98 M
CH : 3411 / D : 2.66 M
CH : 3403 / D : 2.89 M
CH : 3393 / D : 2.74 M
CH : 3383 / D : 3.19 M
CH : 3371 / D : 3.48 M
CH : 3358 / D : 3.55 M
CH : 3347 / D : 3.47 M
CH : 3337 / D : 3.47 M
CH : 3328 / D : 3.60 M
CH : 3313 / D : 3.61 M
CH : 3304 / D : 3.34 M
CH : 3290 / D : 3.70 M
CH : 3279 / D : 3.85 M
CH : 3267 / D : 4.16 M
CH : 3257 / D : 3.91 M

NOTE : ALL MESURMENTS ARE IN METERES (M)


ROAD OFFSET = DISTANCE FROM ROAD CENTRE LINE TO CABLE. ROAD FROM OPENSTREETMAP, CABLE FROM GPS - APPROXIMATE

Amended Bharatnet Program Phase - III

PACKAGE - 9/ WEST BENGAL	PIA - Tera Software
JOB	AS BUILT DRAWING
BLOCK NAME :	HARIHARPARA
SPAN :	BEHARIA GP TO JC0014
FROM GP: BEHARIA GP TO GP: JC0014	

PIA	IE	BSNL

PLANIMETRY SCALE : H/V - 1:1000	SHEET SIZE - A3
FROM CH: 3250 M TO CH: 3500 M	SHEET NO. - 14
Patch Length :- 250 m	DATE:

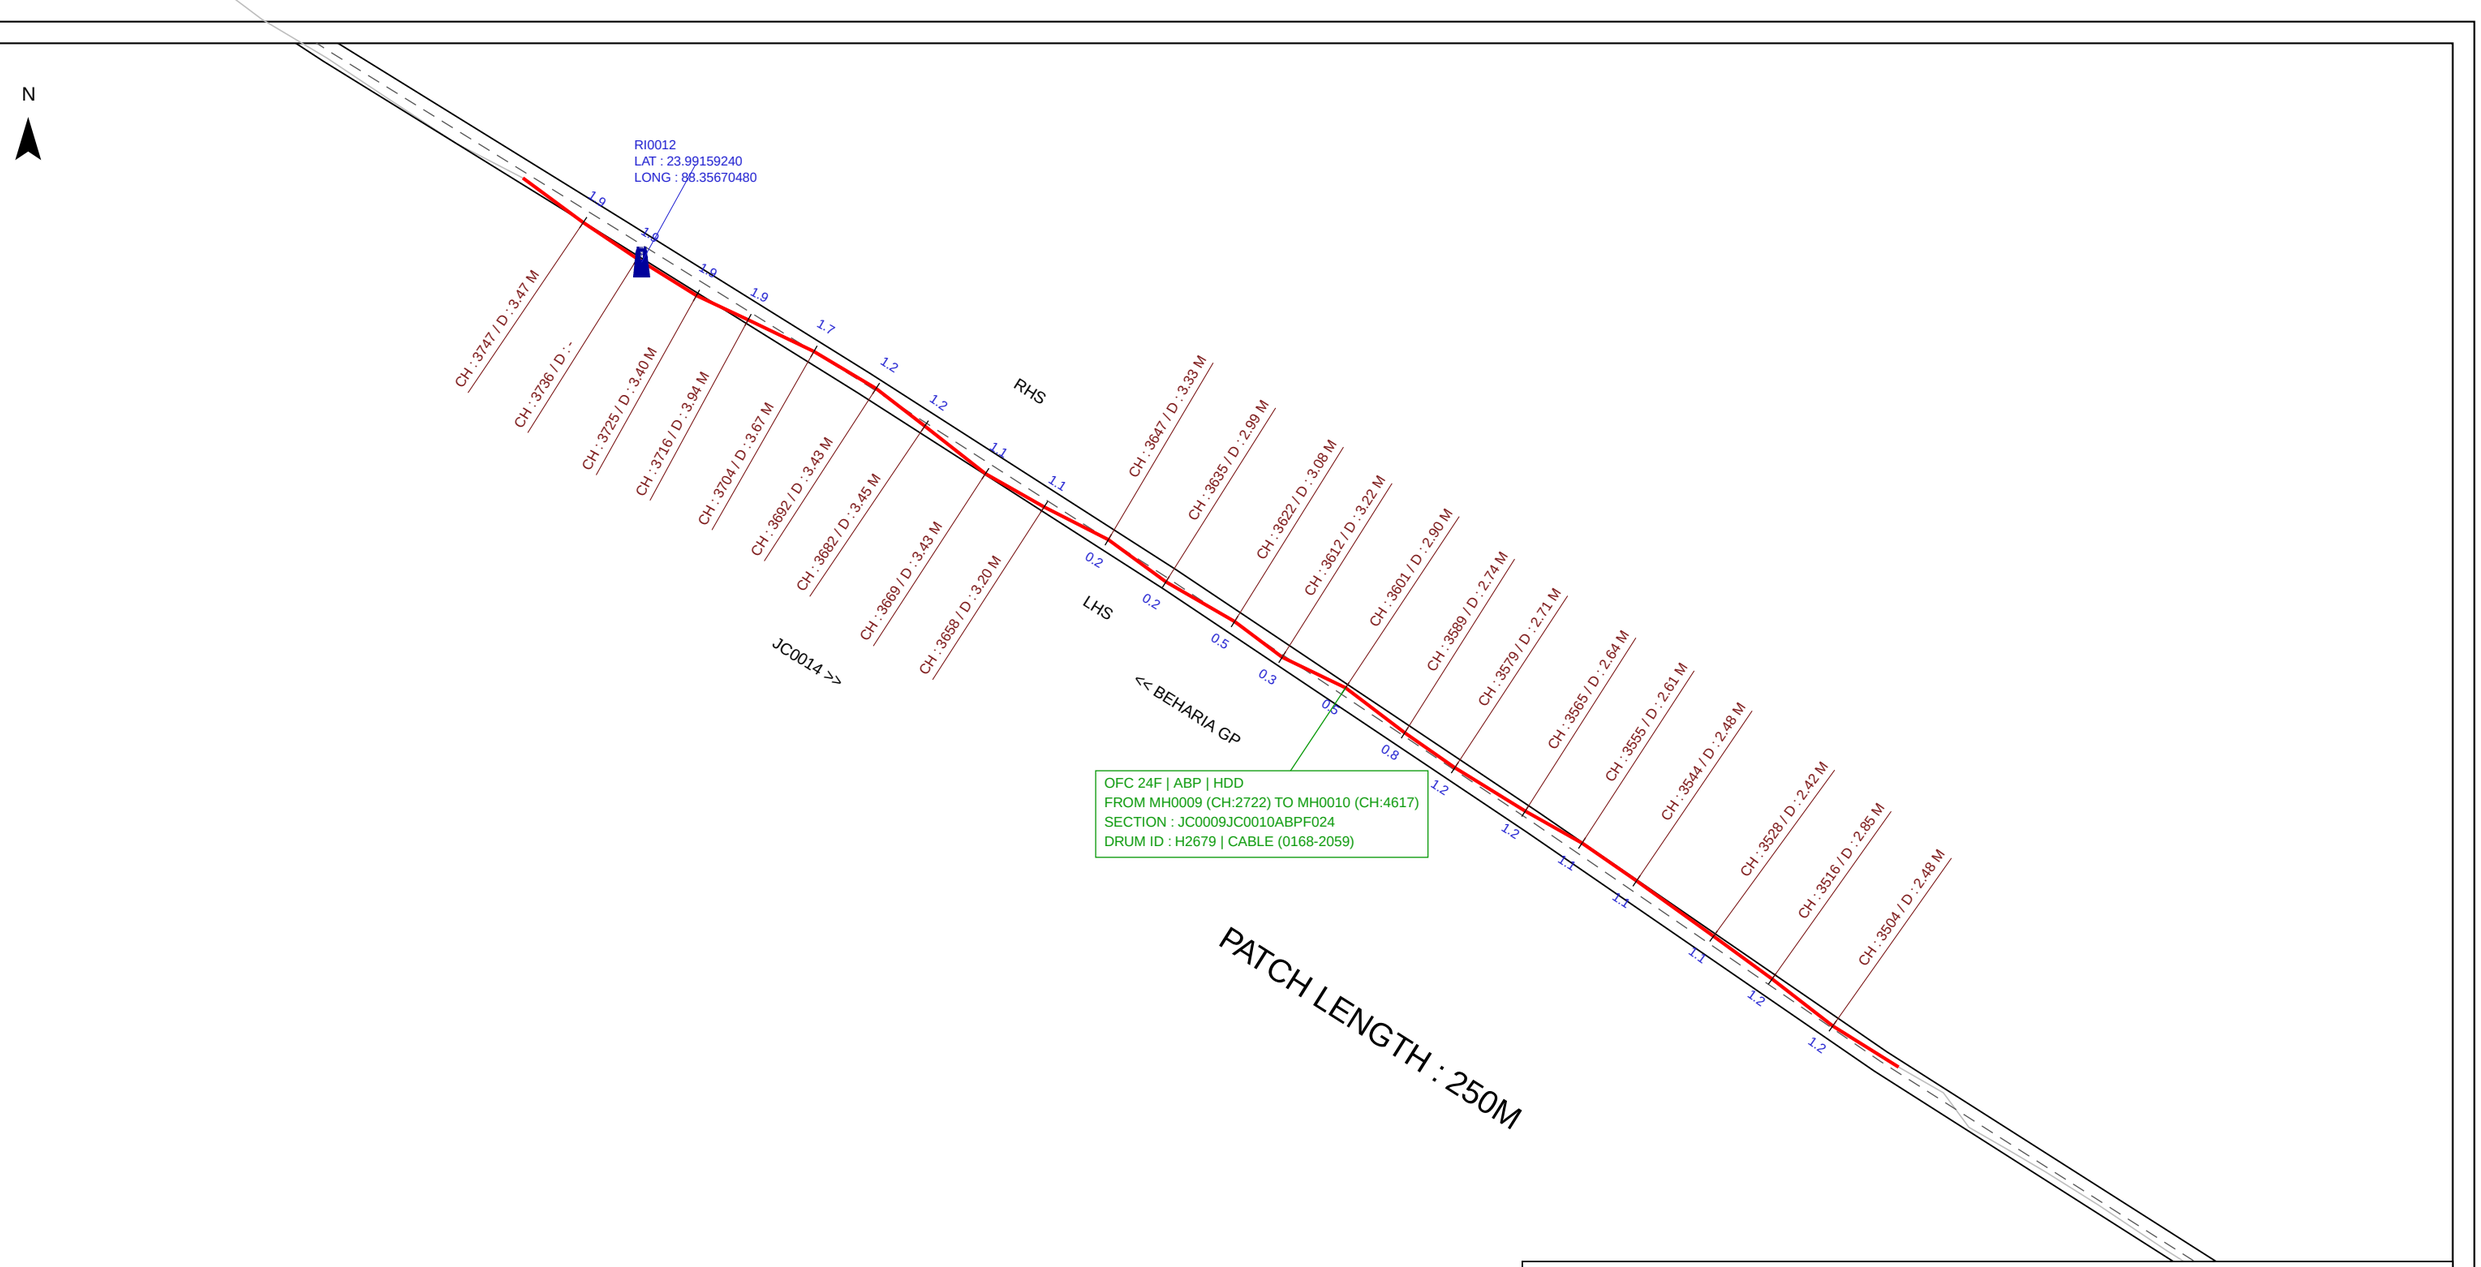

NOTE : ALL MESURMENTS ARE IN METERES (M)

ROAD OFFSET = DISTANCE FROM ROAD CENTRE LINE TO CABLE. ROAD FROM OPENSTREETMAP, CABLE FROM GPS - APPROXIMATE


Amended Bharatnet Program Phase - III

PACKAGE - 9/ WEST BENGAL	PIA - Tera Software
JOB	AS BUILT DRAWING
BLOCK NAME :	HARIHARPARA
SPAN :	BEHARIA GP TO JC0014
FROM GP: BEHARIA GP TO GP: JC0014	

PIA	IE	BSNL

PLANIMETRY SCALE : H/V - 1:1000	SHEET SIZE - A3
FROM CH: 3500 M TO CH: 3750 M	SHEET NO. - 15
Patch Length :- 250 m	DATE:

N

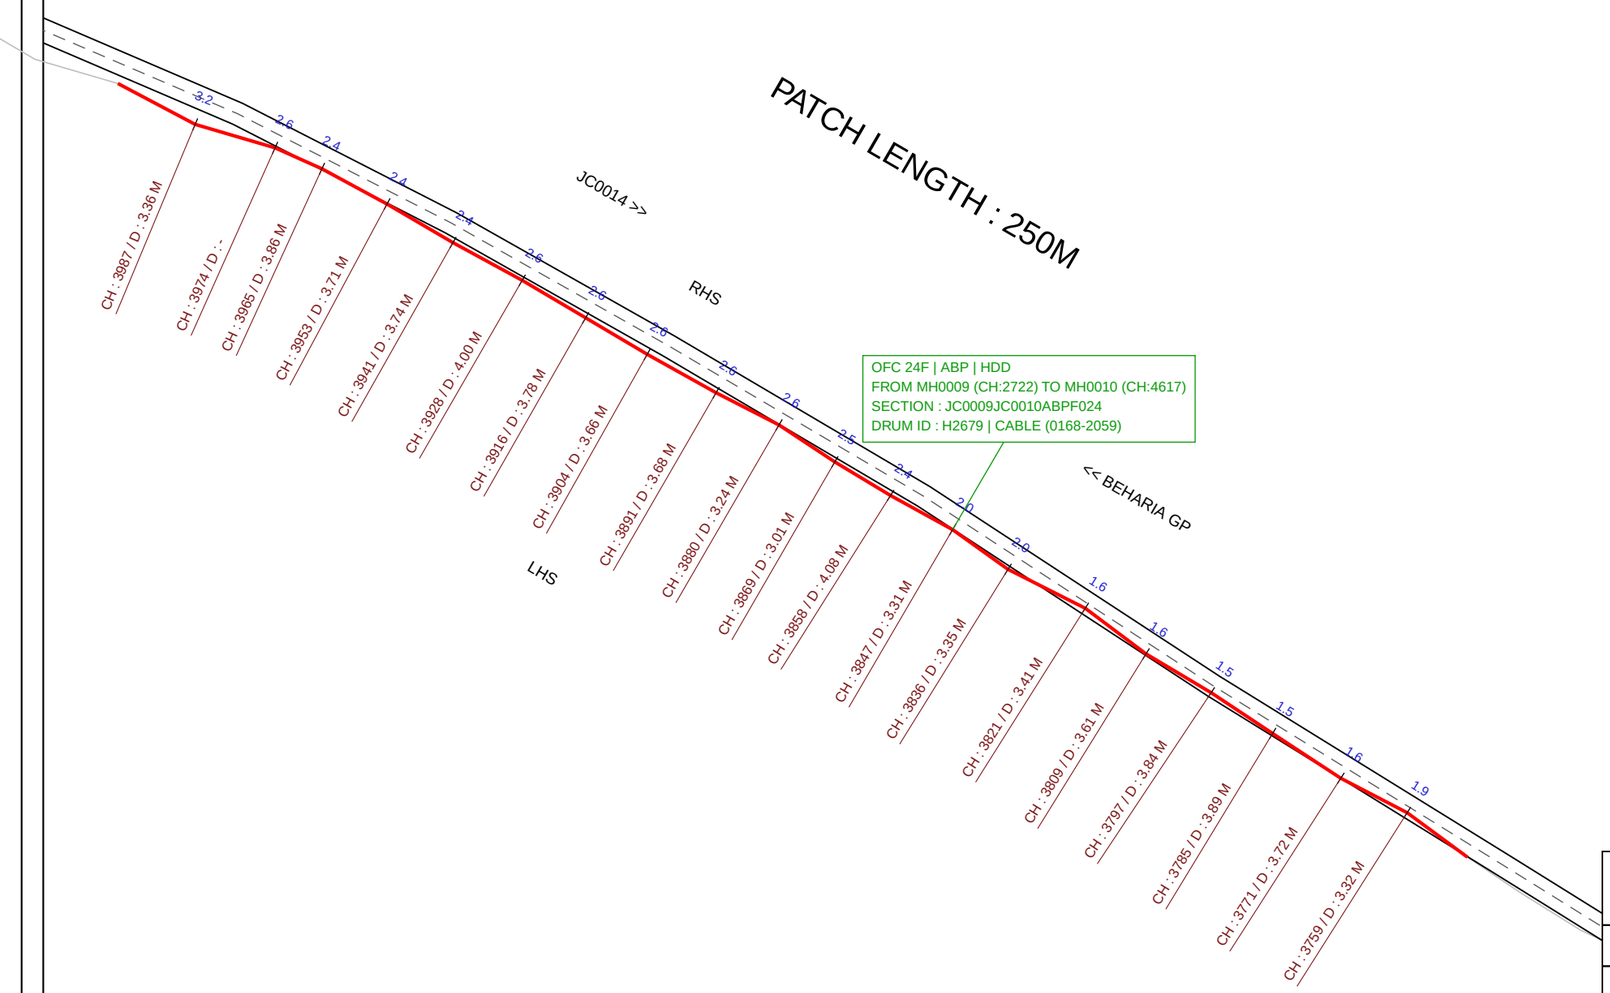

NOTE : ALL MESURMENTS ARE IN METERES (M)


ROAD OFFSET = DISTANCE FROM ROAD CENTRE LINE TO CABLE. ROAD FROM OPENSTREETMAP, CABLE FROM GPS - APPROXIMATE

Amended Bharatnet Program Phase - III

PACKAGE - 9/ WEST BENGAL	PIA - Tera Software
JOB	AS BUILT DRAWING
BLOCK NAME :	HARIHARPARA
SPAN :	BEHARIA GP TO JC0014
FROM GP: BEHARIA GP TO GP: JC0014	

PIA	IE	BSNL

PLANIMETRY SCALE : H/V - 1:1000	SHEET SIZE - A3
FROM CH: 3750 M TO CH: 4000 M	SHEET NO. - 16
Patch Length :- 250 m	DATE:

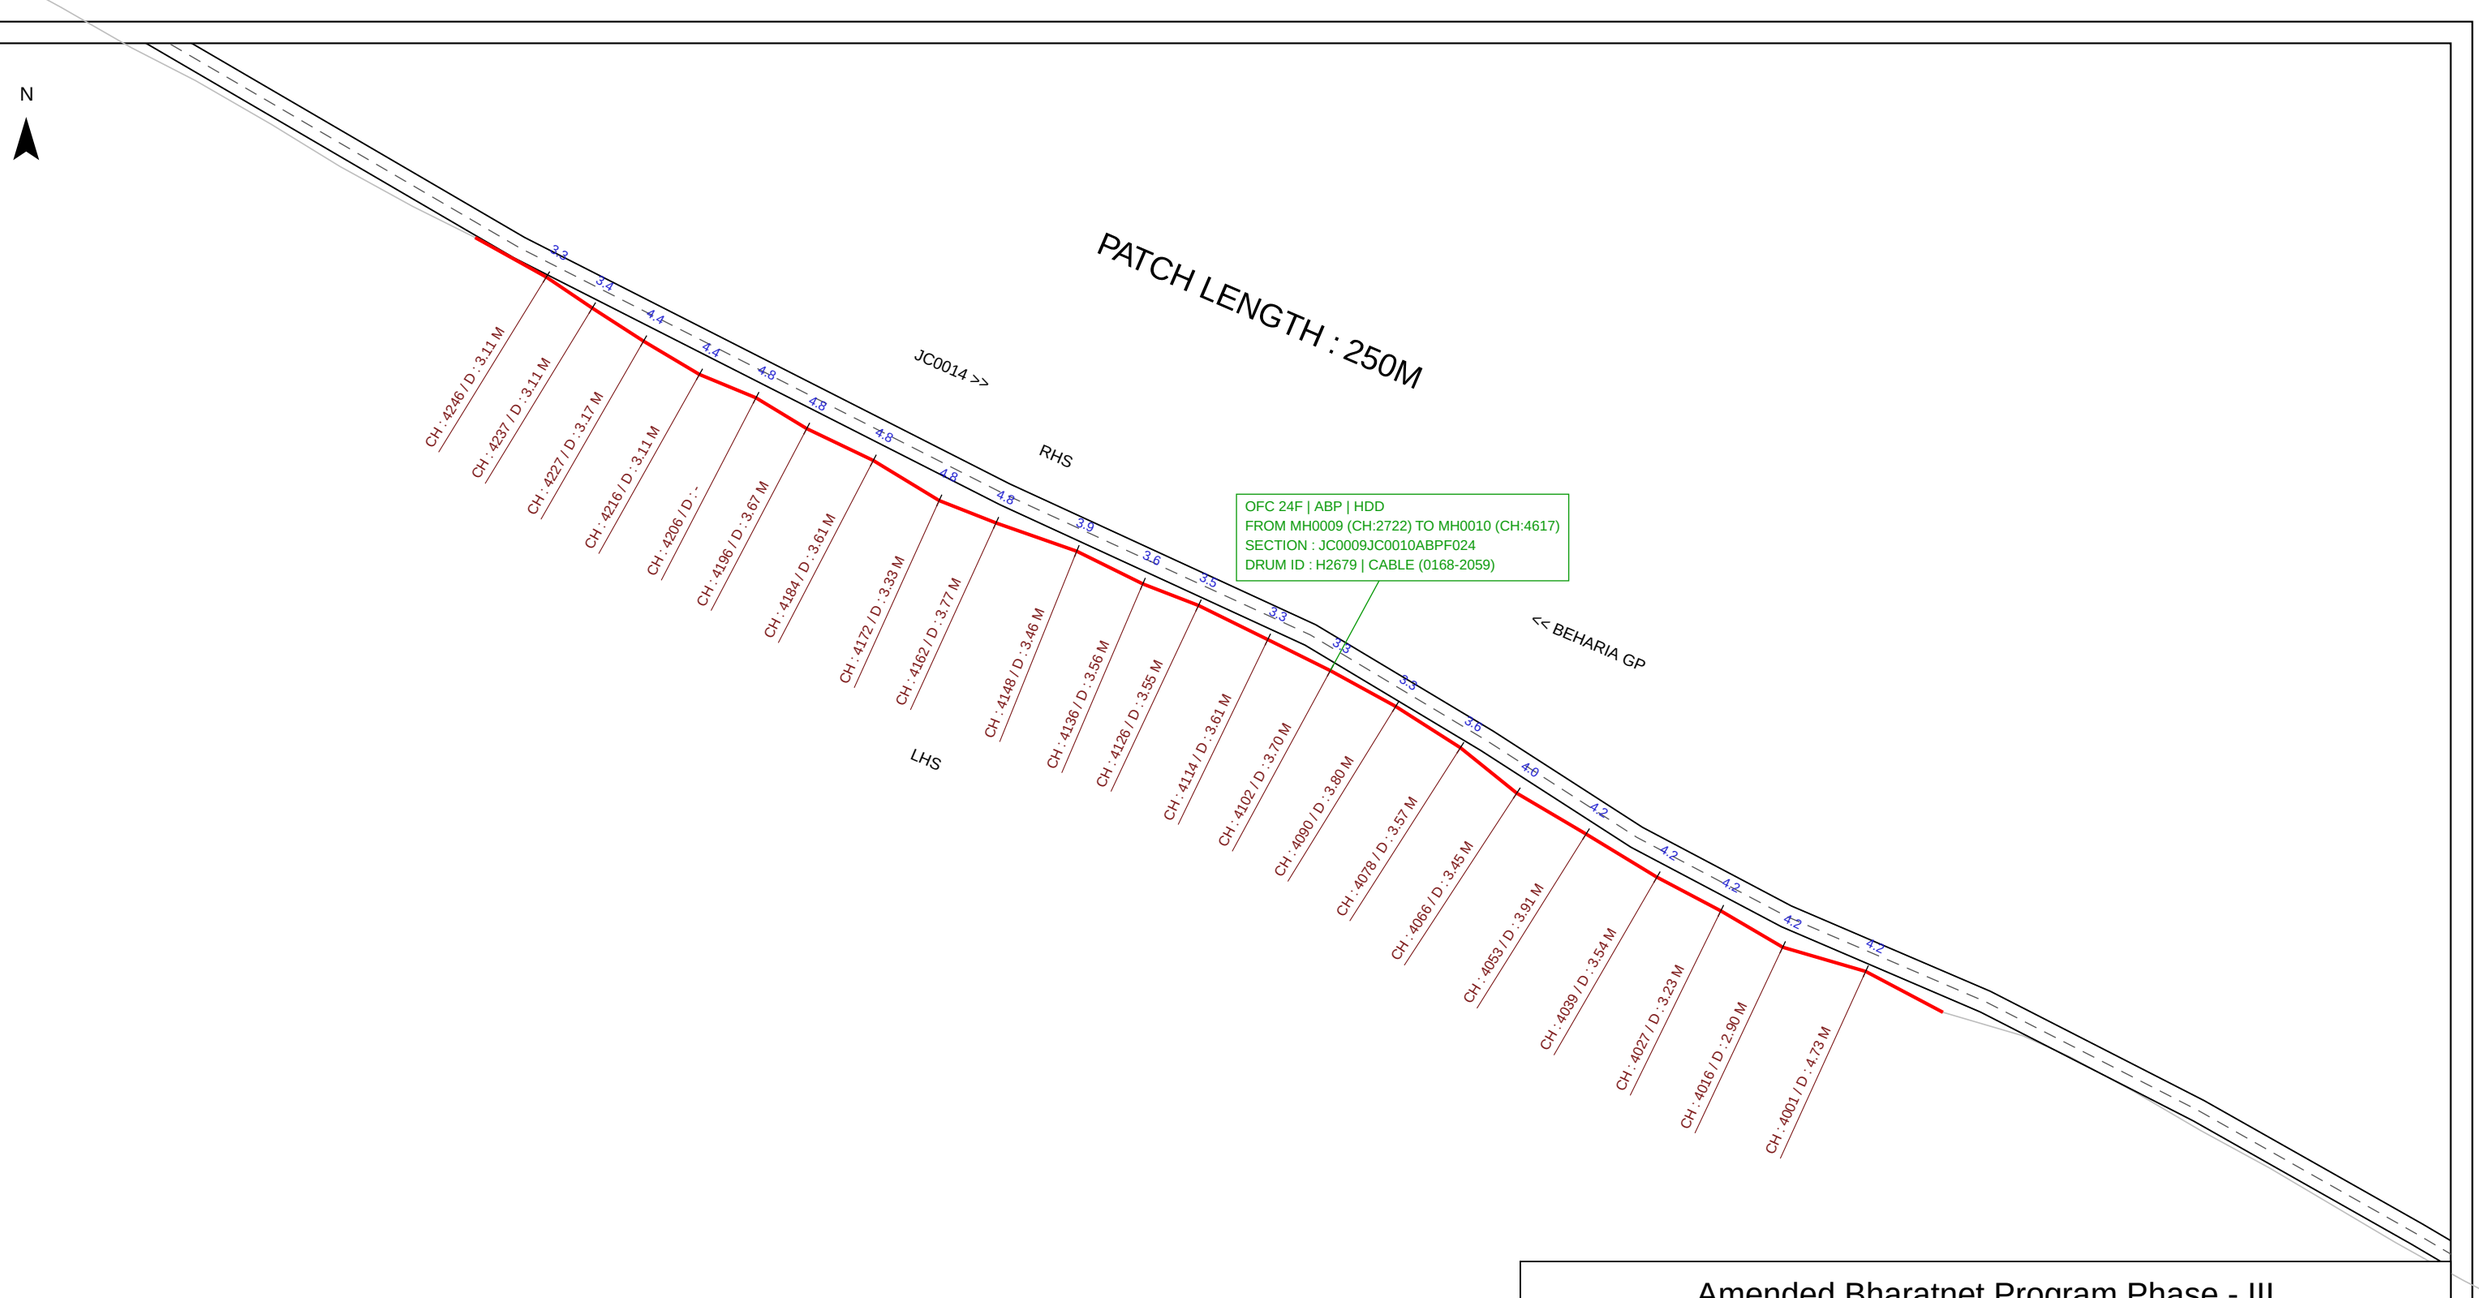

NOTE : ALL MESURMENTS ARE IN METERES (M)

ROAD OFFSET = DISTANCE FROM ROAD CENTRE LINE TO CABLE. ROAD FROM OPENSTREETMAP, CABLE FROM GPS - APPROXIMATE

Amended Bharatnet Program Phase - III

PACKAGE - 9/ WEST BENGAL	PIA - Tera Software
JOB	AS BUILT DRAWING
BLOCK NAME :	HARIHARPARA
SPAN :	BEHARIA GP TO JC0014
FROM GP: BEHARIA GP TO GP: JC0014	

PIA	IE	BSNL

PLANIMETRY SCALE : H/V - 1:1000	SHEET SIZE - A3
FROM CH: 4000 M TO CH: 4250 M	SHEET NO. - 17
Patch Length :- 250 m	DATE:

N

PATCH LENGTH : 250M

RHS

LHS

OFC 24F | ABP | HDD
FROM MH0009 (CH:2722) TO MH0010 (CH:4617)
SECTION : JC0009JC0010ABPF024
DRUM ID : H2679 | CABLE (0168-2059)

RI0013
LAT : 23.99435680
LONG : 88.35113180

JC0014 >>

<< BEHARIA GP

CH : 4497 / D : 2.64 M
CH : 4485 / D : 2.46 M
CH : 4476 / D : 2.67 M
CH : 4465 / D : 2.55 M
CH : 4453 / D : 2.58 M
CH : 4440 / D : 3.20 M
CH : 4427 / D : 2.45 M
CH : 4415 / D : 2.36 M
CH : 4401 / D : 2.96 M
CH : 4392 / D : 2.09 M
CH : 4385 / D : -
CH : 4375 / D : 3.31 M
CH : 4361 / D : 3.09 M
CH : 4348 / D : 3.17 M
CH : 4336 / D : 2.04 M
CH : 4323 / D : 2.91 M
CH : 4311 / D : 3.30 M
CH : 4297 / D : 3.17 M
CH : 4284 / D : 2.84 M
CH : 4270 / D : 3.30 M
CH : 4259 / D : 3.40 M

NOTE : ALL MESURMENTS ARE IN METERES (M)

ROAD OFFSET = DISTANCE FROM ROAD CENTRE LINE TO CABLE. ROAD FROM OPENSTREETMAP, CABLE FROM GPS - APPROXIMATE

Amended Bharatnet Program Phase - III

PACKAGE - 9/ WEST BENGAL	PIA - Tera Software
JOB	AS BUILT DRAWING
BLOCK NAME :	HARIHARPARA
SPAN :	BEHARIA GP TO JC0014
FROM GP: BEHARIA GP TO GP: JC0014	

PIA	IE	BSNL

PLANIMETRY SCALE : H/V - 1:1000	SHEET SIZE - A3
FROM CH: 4250 M TO CH: 4500 M	SHEET NO. - 18
Patch Length :- 250 m	DATE:

N

PATCH LENGTH : 250M

CH : 4748 / D : 2.83 M
CH : 4738 / D : 2.47 M
CH : 4727 / D : 2.32 M
CH : 4716 / D : 2.51 M
CH : 4705 / D : 2.73 M
CH : 4692 / D : 2.05 M
CH : 4675 / D : 2.57 M
CH : 4661 / D : 3.38 M
CH : 4646 / D : 3.00 M
CH : 4635 / D : 3.06 M

JC0014 >>

RHS

<< BEHARIA GP

OFC 24F | ABP | HDD
FROM MH0010 (CH:4617) TO JC0014 (CH:6686)
SECTION : JC0010JC0014ABPF024
DRUM ID : H2738 | CABLE (0122-2057)

RI0014
LAT : 23.99583490
LONG : 88.34948160

CH : 4617 / D : -
CH : 4611 / D : 2.59 M
CH : 4601 / D : 3.31 M
CH : 4589 / D : 3.16 M
CH : 4579 / D : 2.93 M
CH : 4565 / D : 2.68 M
CH : 4554 / D : 2.52 M
CH : 4543 / D : 2.60 M
CH : 4532 / D : 3.27 M
CH : 4521 / D : 2.61 M
CH : 4509 / D : 2.62 M

LHS

OFC 24F | ABP | HDD
FROM MH0009 (CH:2722) TO MH0010 (CH:4617)
SECTION : JC0009JC0010ABPF024
DRUM ID : H2679 | CABLE (0168-2059)

MH0010 / JC0010 SJC (CH:4617)
24F Cable | DRUM ID : H2738 START (M 0122)
24F Cable | DRUM ID : H2679 END (M 2059)
LAT : 23.99586680
LONG : 88.34955390

NOTE : ALL MESURMENTS ARE IN METERES (M)


ROAD OFFSET = DISTANCE FROM ROAD CENTRE LINE TO CABLE. ROAD FROM OPENSTREETMAP, CABLE FROM GPS - APPROXIMATE

Amended Bharatnet Program Phase - III

PACKAGE - 9/ WEST BENGAL	PIA - Tera Software
JOB	AS BUILT DRAWING
BLOCK NAME :	HARIHARPARA
SPAN :	BEHARIA GP TO JC0014
FROM GP: BEHARIA GP	TO GP: JC0014

PIA	IE	BSNL

PLANIMETRY SCALE : H/V - 1:1000	SHEET SIZE - A3
FROM CH: 4500 M TO CH: 4750 M	SHEET NO. - 19
Patch Length :- 250 m	DATE:

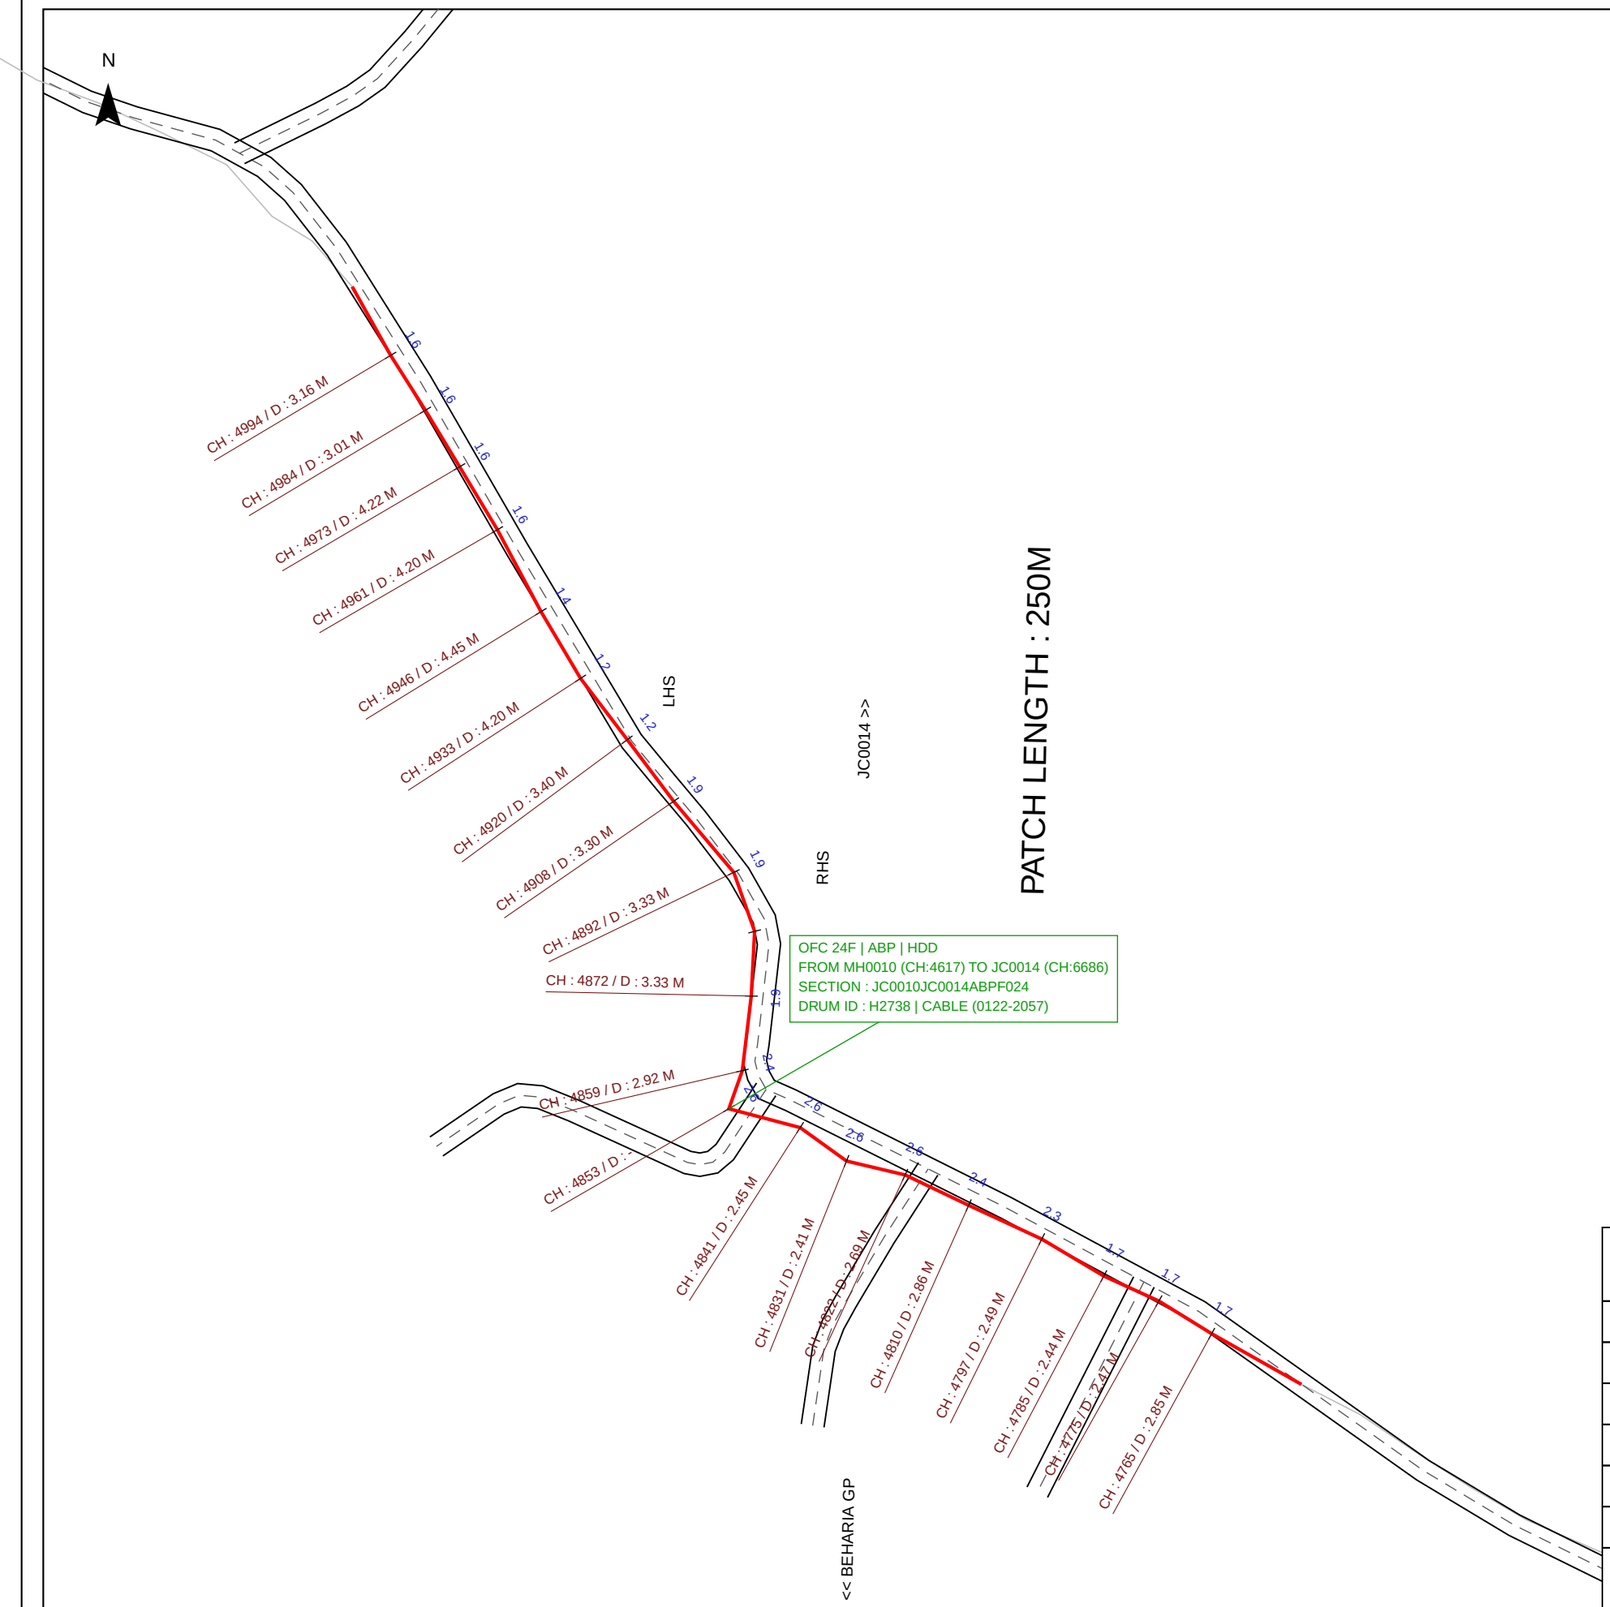

NOTE : ALL MESURMENTS ARE IN METERES (M)

ROAD OFFSET = DISTANCE FROM ROAD CENTRE LINE TO CABLE. ROAD FROM OPENSTREETMAP, CABLE FROM GPS - APPROXIMATE

Amended Bharatnet Program Phase - III

PACKAGE - 9/ WEST BENGAL	PIA - Tera Software
JOB	AS BUILT DRAWING
BLOCK NAME :	HARIHARPARA
SPAN :	BEHARIA GP TO JC0014
FROM GP: BEHARIA GP TO GP: JC0014	

PIA	IE	BSNL

PLANIMETRY SCALE : H/V - 1:1000	SHEET SIZE - A3
FROM CH: 4750 M TO CH: 5000 M	SHEET NO. - 20
Patch Length :- 250 m	DATE:

N

PATCH LENGTH : 250M

JC0014 >>

OFC 24F | ABP | HDD
FROM MH0010 (CH:4617) TO JC0014 (CH:6686)
SECTION : JC0010JC0014ABPF024
DRUM ID : H2738 | CABLE (0122-2057)

RHS

<< BEHARIA GP

LHS

RI0015
LAT : 23.99885170
LONG : 88.34673270

CH : 5242 / D : 2.70 M
CH : 5228 / D : 2.73 M
CH : 5219 / D : 2.27 M
CH : 5210 / D : --
CH : 5199 / D : 2.95 M
CH : 5188 / D : 3.26 M
CH : 5178 / D : 3.19 M
CH : 5169 / D : 3.25 M
CH : 5157 / D : 3.13 M
CH : 5149 / D : 3.15 M
CH : 5137 / D : 3.32 M
CH : 5127 / D : 3.11 M
CH : 5115 / D : 3.85 M
CH : 5104 / D : 3.49 M
CH : 5093 / D : 3.13 M
CH : 5082 / D : 3.03 M
CH : 5070 / D : 2.63 M
CH : 5059 / D : 2.65 M
CH : 5048 / D : 2.69 M
CH : 5036 / D : 2.93 M
CH : 5017 / D : 2.92 M
CH : 5007 / D : 3.20 M

NOTE : ALL MESURMENTS ARE IN METERES (M)

ROAD OFFSET = DISTANCE FROM ROAD CENTRE LINE TO CABLE. ROAD FROM OPENSTREETMAP, CABLE FROM GPS - APPROXIMATE

Amended Bharatnet Program Phase - III

PACKAGE - 9/ WEST BENGAL	PIA - Tera Software
JOB	AS BUILT DRAWING
BLOCK NAME :	HARIHARPARA
SPAN :	BEHARIA GP TO JC0014
FROM GP: BEHARIA GP TO GP: JC0014	

PIA	IE	BSNL

PLANIMETRY SCALE : H/V - 1:1000	SHEET SIZE - A3
FROM CH: 5000 M TO CH: 5250 M	SHEET NO. - 21
Patch Length :- 250 m	DATE:

N

PATCH LENGTH : 250M

JC0014 >>

RHS

LHS

<< BEHARIA GP

RI0016
LAT : 23.99995860
LONG : 88.34372830

OFC 24F | ABP | HDD
FROM MH0010 (CH:4617) TO JC0014 (CH:6686)
SECTION : JC0010JC0014ABPF024
DRUM ID : H2738 | CABLE (0122-2057)

CH : 5492 / D : 2.92 M
CH : 5478 / D : 3.30 M
CH : 5468 / D : 3.17 M
CH : 5456 / D : 3.01 M
CH : 5445 / D : 3.17 M
CH : 5435 / D : 2.70 M
CH : 5425 / D : 3.20 M
CH : 5414 / D : 2.92 M
CH : 5408 / D : -
CH : 5402 / D : 3.40 M
CH : 5393 / D : 3.60 M
CH : 5378 / D : 2.79 M
CH : 5366 / D : 2.62 M
CH : 5356 / D : 2.84 M
CH : 5345 / D : 2.66 M
CH : 5333 / D : 2.58 M
CH : 5325 / D : 2.61 M
CH : 5315 / D : 2.46 M
CH : 5301 / D : 2.70 M
CH : 5291 / D : 2.60 M
CH : 5279 / D : 3.52 M
CH : 5267 / D : 2.90 M
CH : 5253 / D : 2.49 M

NOTE : ALL MESURMENTS ARE IN METERES (M)


ROAD OFFSET = DISTANCE FROM ROAD CENTRE LINE TO CABLE. ROAD FROM OPENSTREETMAP, CABLE FROM GPS - APPROXIMATE

Amended Bharatnet Program Phase - III

PACKAGE - 9/ WEST BENGAL	PIA - Tera Software
JOB	AS BUILT DRAWING
BLOCK NAME :	HARIHARPARA
SPAN :	BEHARIA GP TO JC0014
FROM GP: BEHARIA GP TO GP: JC0014	

PIA	IE	BSNL

PLANIMETRY SCALE : H/V - 1:1000	SHEET SIZE - A3
FROM CH: 5250 M TO CH: 5500 M	SHEET NO. - 22
Patch Length :- 250 m	DATE:

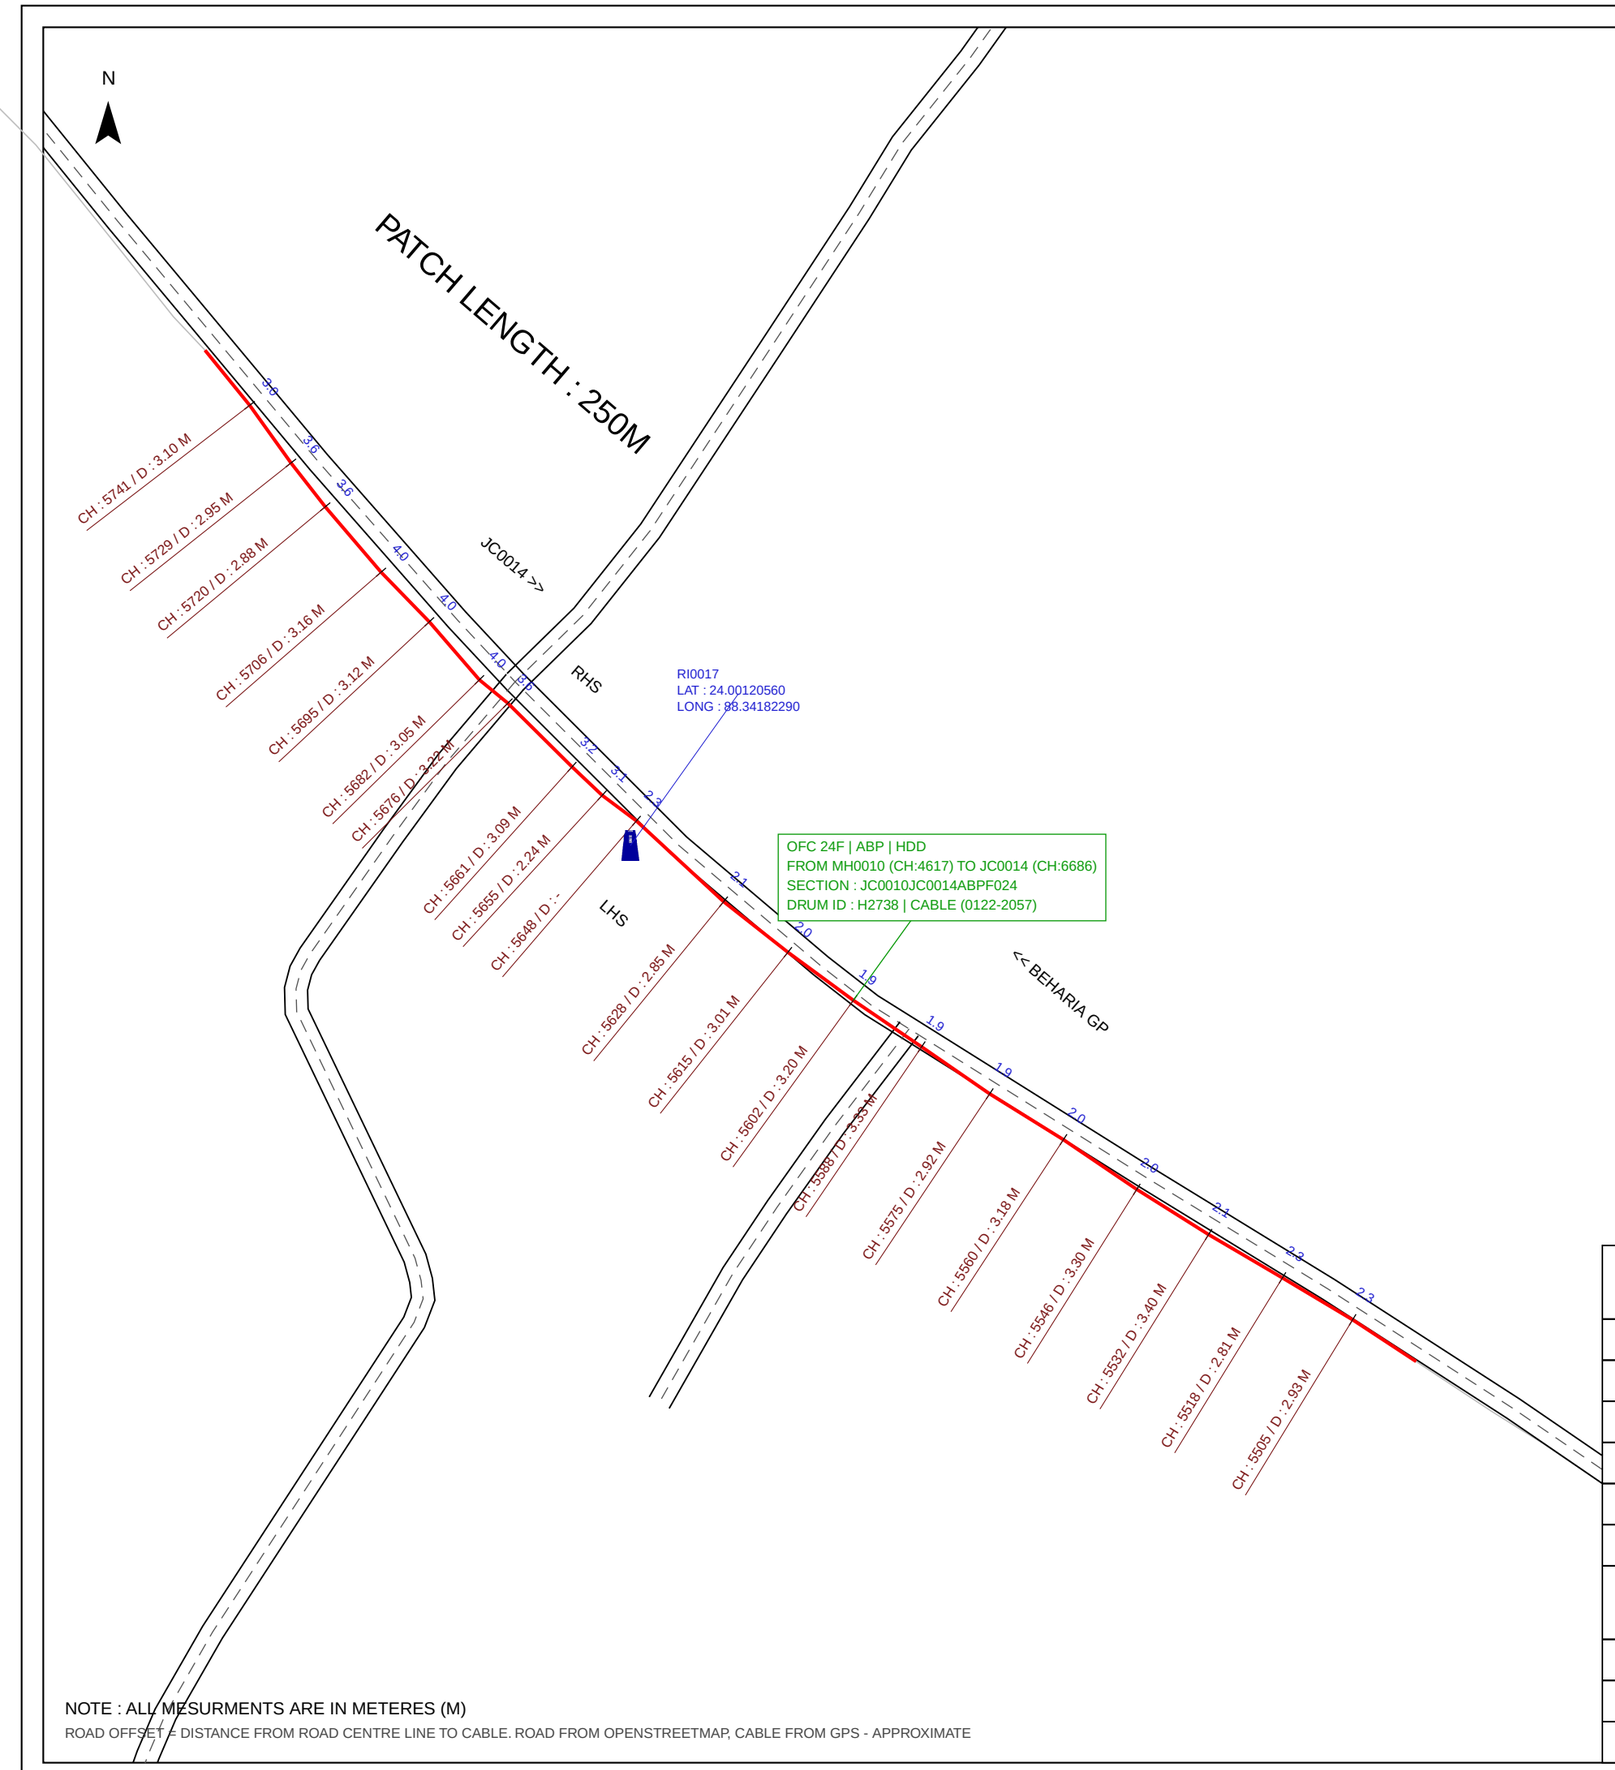

NOTE : ALL MESURMENTS ARE IN METERES (M)


ROAD OFFSET = DISTANCE FROM ROAD CENTRE LINE TO CABLE. ROAD FROM OPENSTREETMAP, CABLE FROM GPS - APPROXIMATE

Amended Bharatnet Program Phase - III

PACKAGE - 9/ WEST BENGAL	PIA - Tera Software
JOB	AS BUILT DRAWING
BLOCK NAME :	HARIHARPARA
SPAN :	BEHARIA GP TO JC0014
FROM GP: BEHARIA GP TO GP: JC0014	

PIA	IE	BSNL

PLANIMETRY SCALE : H/V - 1:1000	SHEET SIZE - A3
FROM CH: 5500 M TO CH: 5750 M	SHEET NO. - 23
Patch Length :- 250 m	DATE:

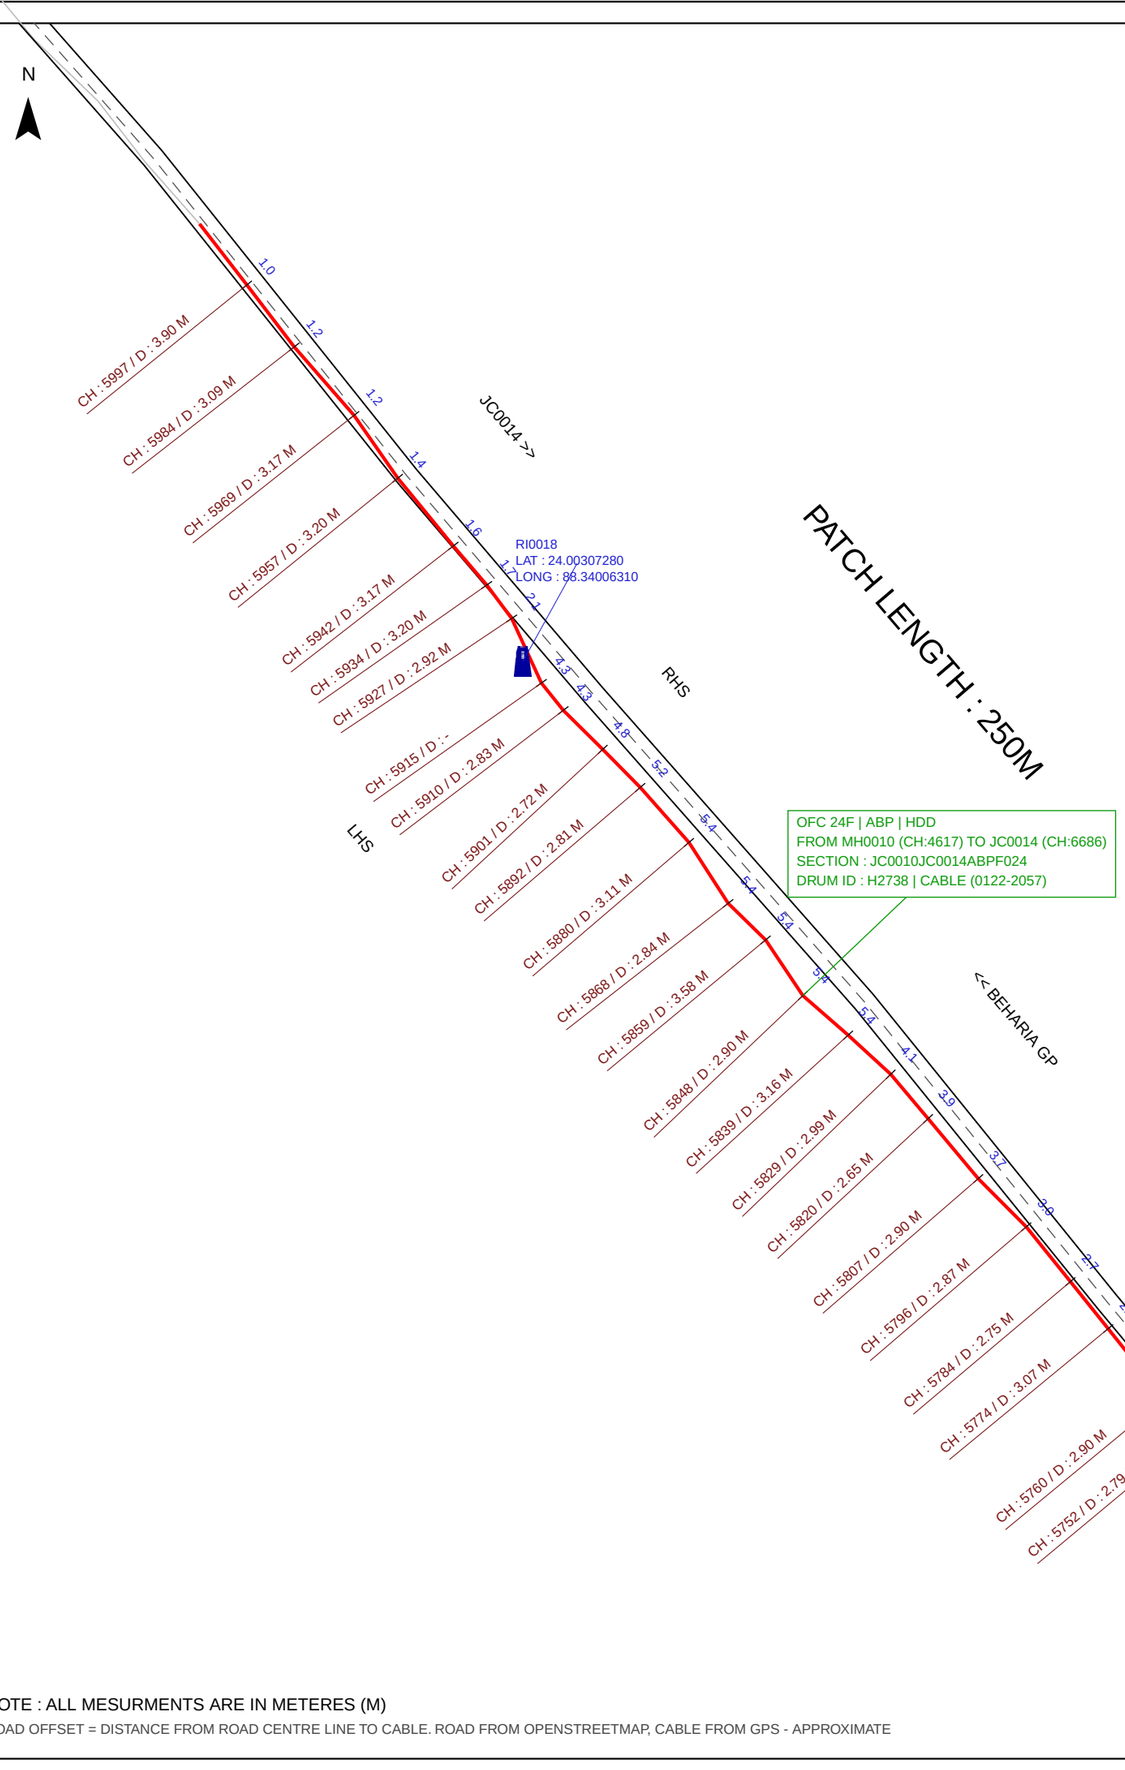

NOTE : ALL MESURMENTS ARE IN METERES (M)


ROAD OFFSET = DISTANCE FROM ROAD CENTRE LINE TO CABLE. ROAD FROM OPENSTREETMAP, CABLE FROM GPS - APPROXIMATE

Amended Bharatnet Program Phase - III

PACKAGE - 9/ WEST BENGAL	PIA - Tera Software
JOB	AS BUILT DRAWING
BLOCK NAME :	HARIHARPARA
SPAN :	BEHARIA GP TO JC0014
FROM GP: BEHARIA GP TO GP: JC0014	

PIA	IE	BSNL

PLANIMETRY SCALE : H/V - 1:1000	SHEET SIZE - A3
FROM CH: 5750 M TO CH: 6000 M	SHEET NO. - 24
Patch Length :- 250 m	DATE:

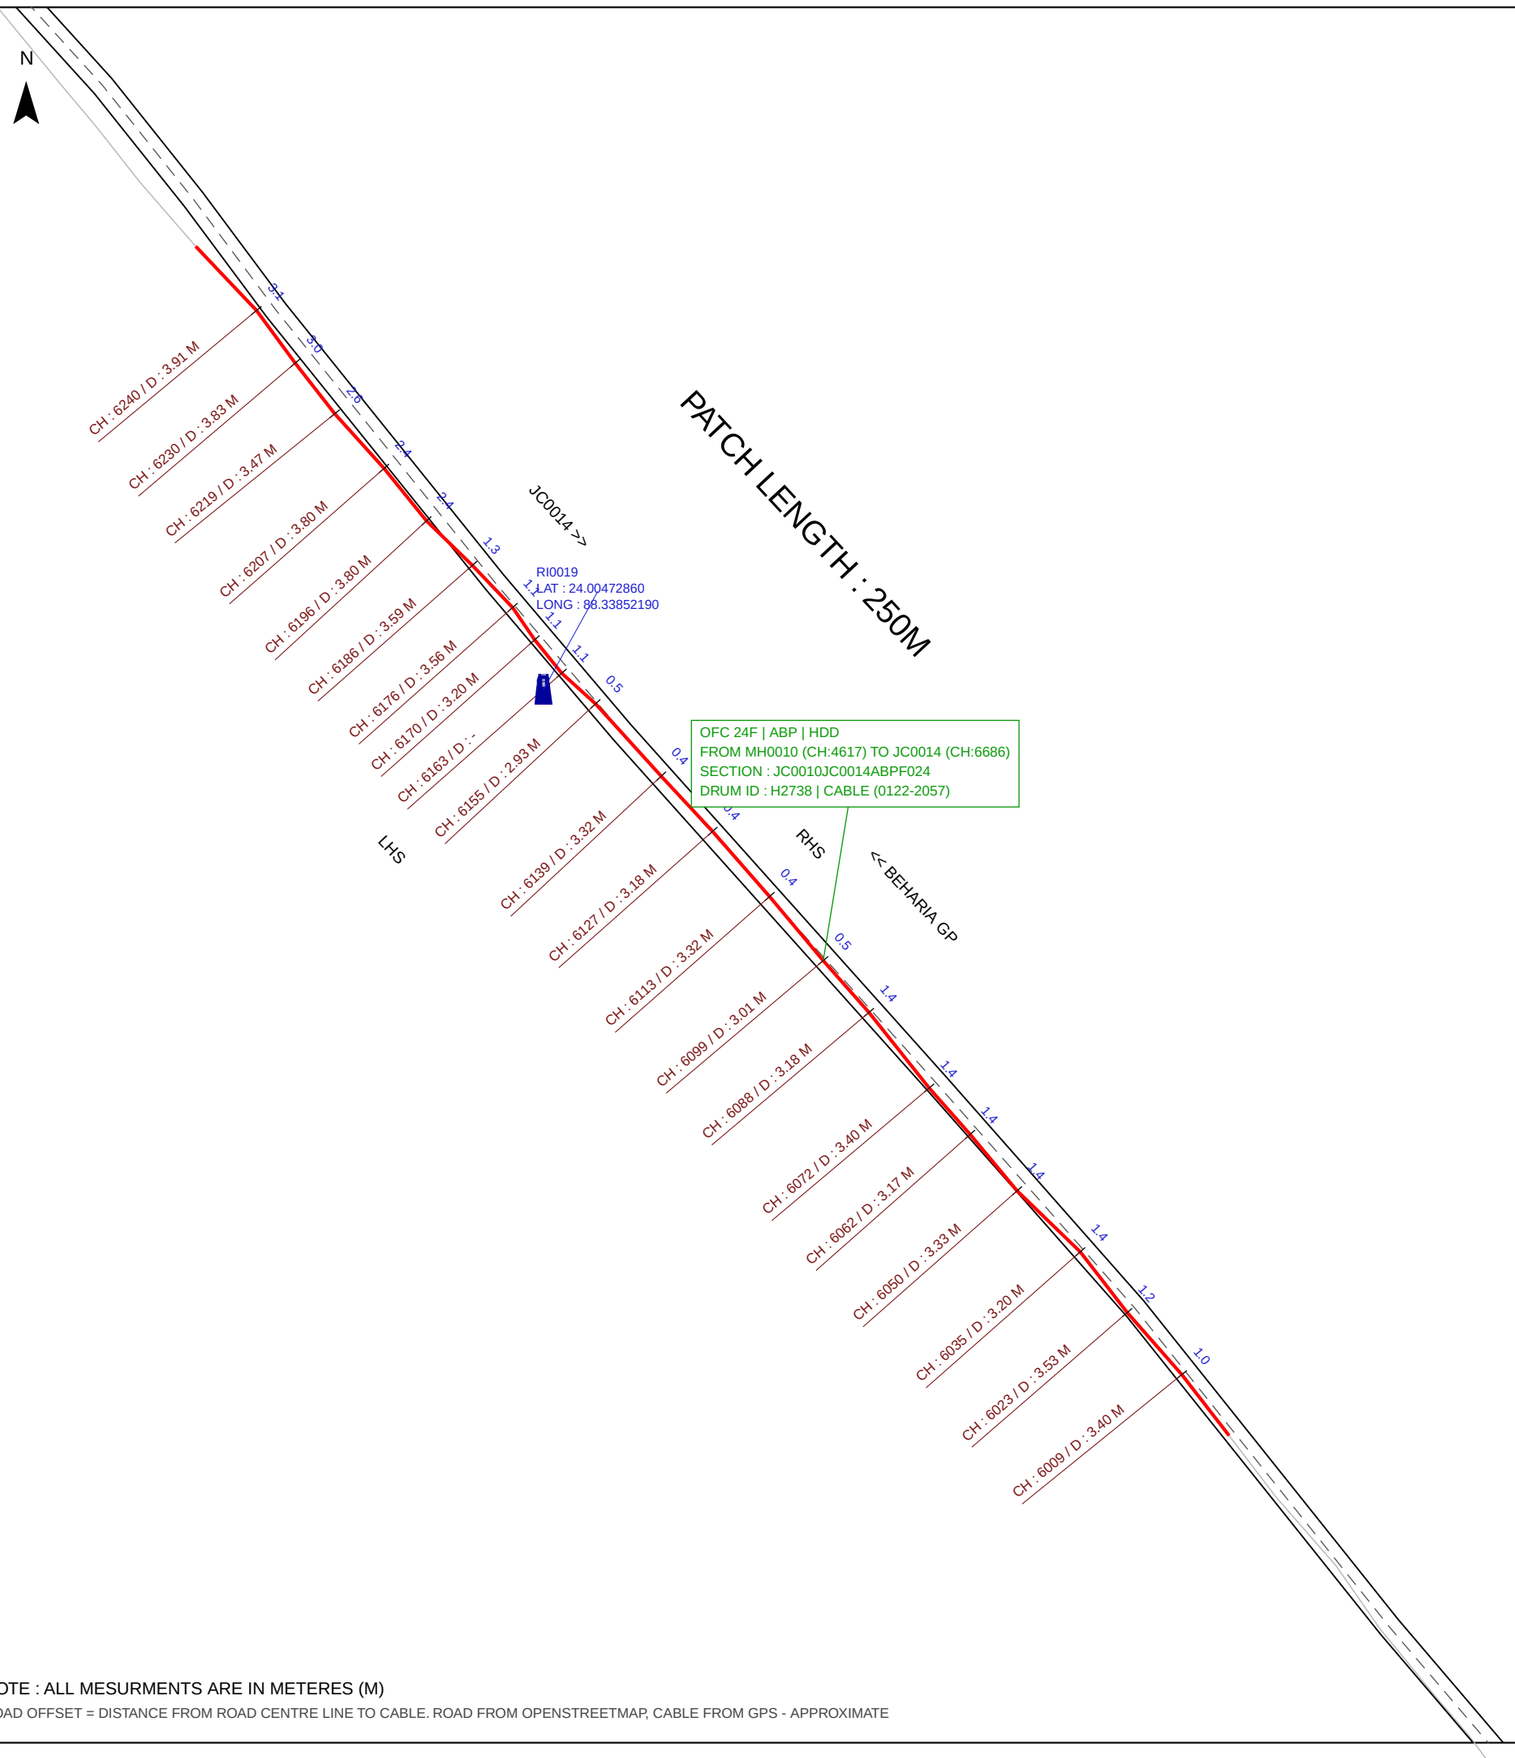

NOTE : ALL MESURMENTS ARE IN METERES (M)


ROAD OFFSET = DISTANCE FROM ROAD CENTRE LINE TO CABLE. ROAD FROM OPENSTREETMAP, CABLE FROM GPS - APPROXIMATE

Amended Bharatnet Program Phase - III

PACKAGE - 9/ WEST BENGAL	PIA - Tera Software
JOB	AS BUILT DRAWING
BLOCK NAME :	HARIHARPARA
SPAN :	BEHARIA GP TO JC0014
FROM GP: BEHARIA GP	TO GP: JC0014

PIA	IE	BSNL

PLANIMETRY SCALE : H/V - 1:1000	SHEET SIZE - A3
FROM CH: 6000 M TO CH: 6250 M	SHEET NO. - 25
Patch Length :- 250 m	DATE:

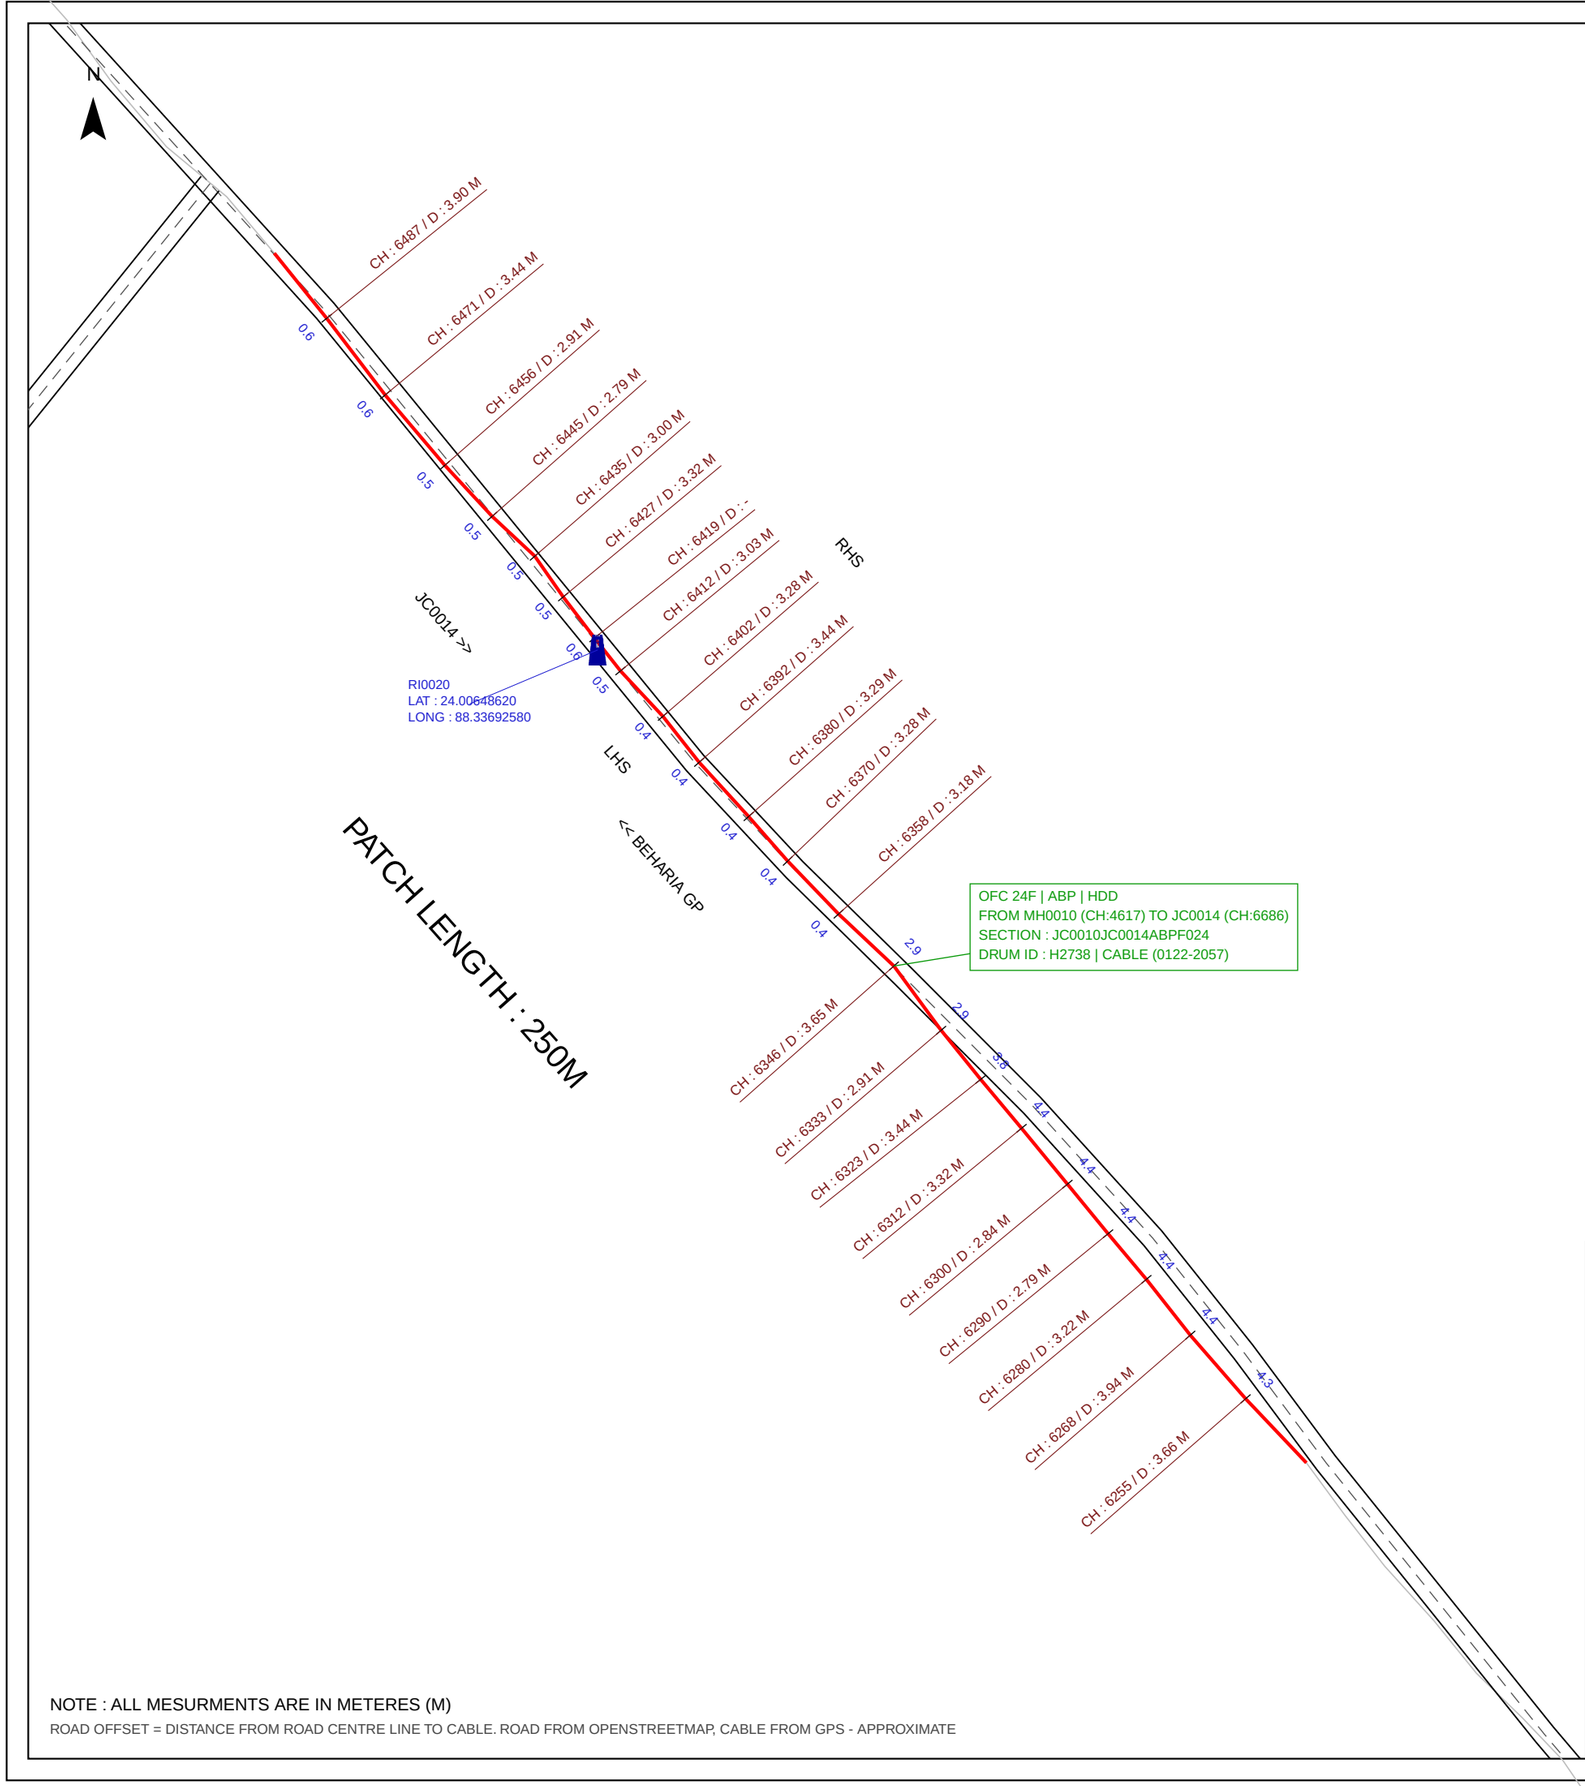

NOTE : ALL MESURMENTS ARE IN METERES (M)


ROAD OFFSET = DISTANCE FROM ROAD CENTRE LINE TO CABLE. ROAD FROM OPENSTREETMAP, CABLE FROM GPS - APPROXIMATE

Amended Bharatnet Program Phase - III

PACKAGE - 9/ WEST BENGAL	PIA - Tera Software
JOB	AS BUILT DRAWING
BLOCK NAME :	HARIHARPARA
SPAN :	BEHARIA GP TO JC0014
FROM GP: BEHARIA GP TO GP: JC0014	

PIA	IE	BSNL

PLANIMETRY SCALE : H/V - 1:1000	SHEET SIZE - A3
FROM CH: 6250 M TO CH: 6500 M	SHEET NO. - 26
Patch Length :- 250 m	DATE:

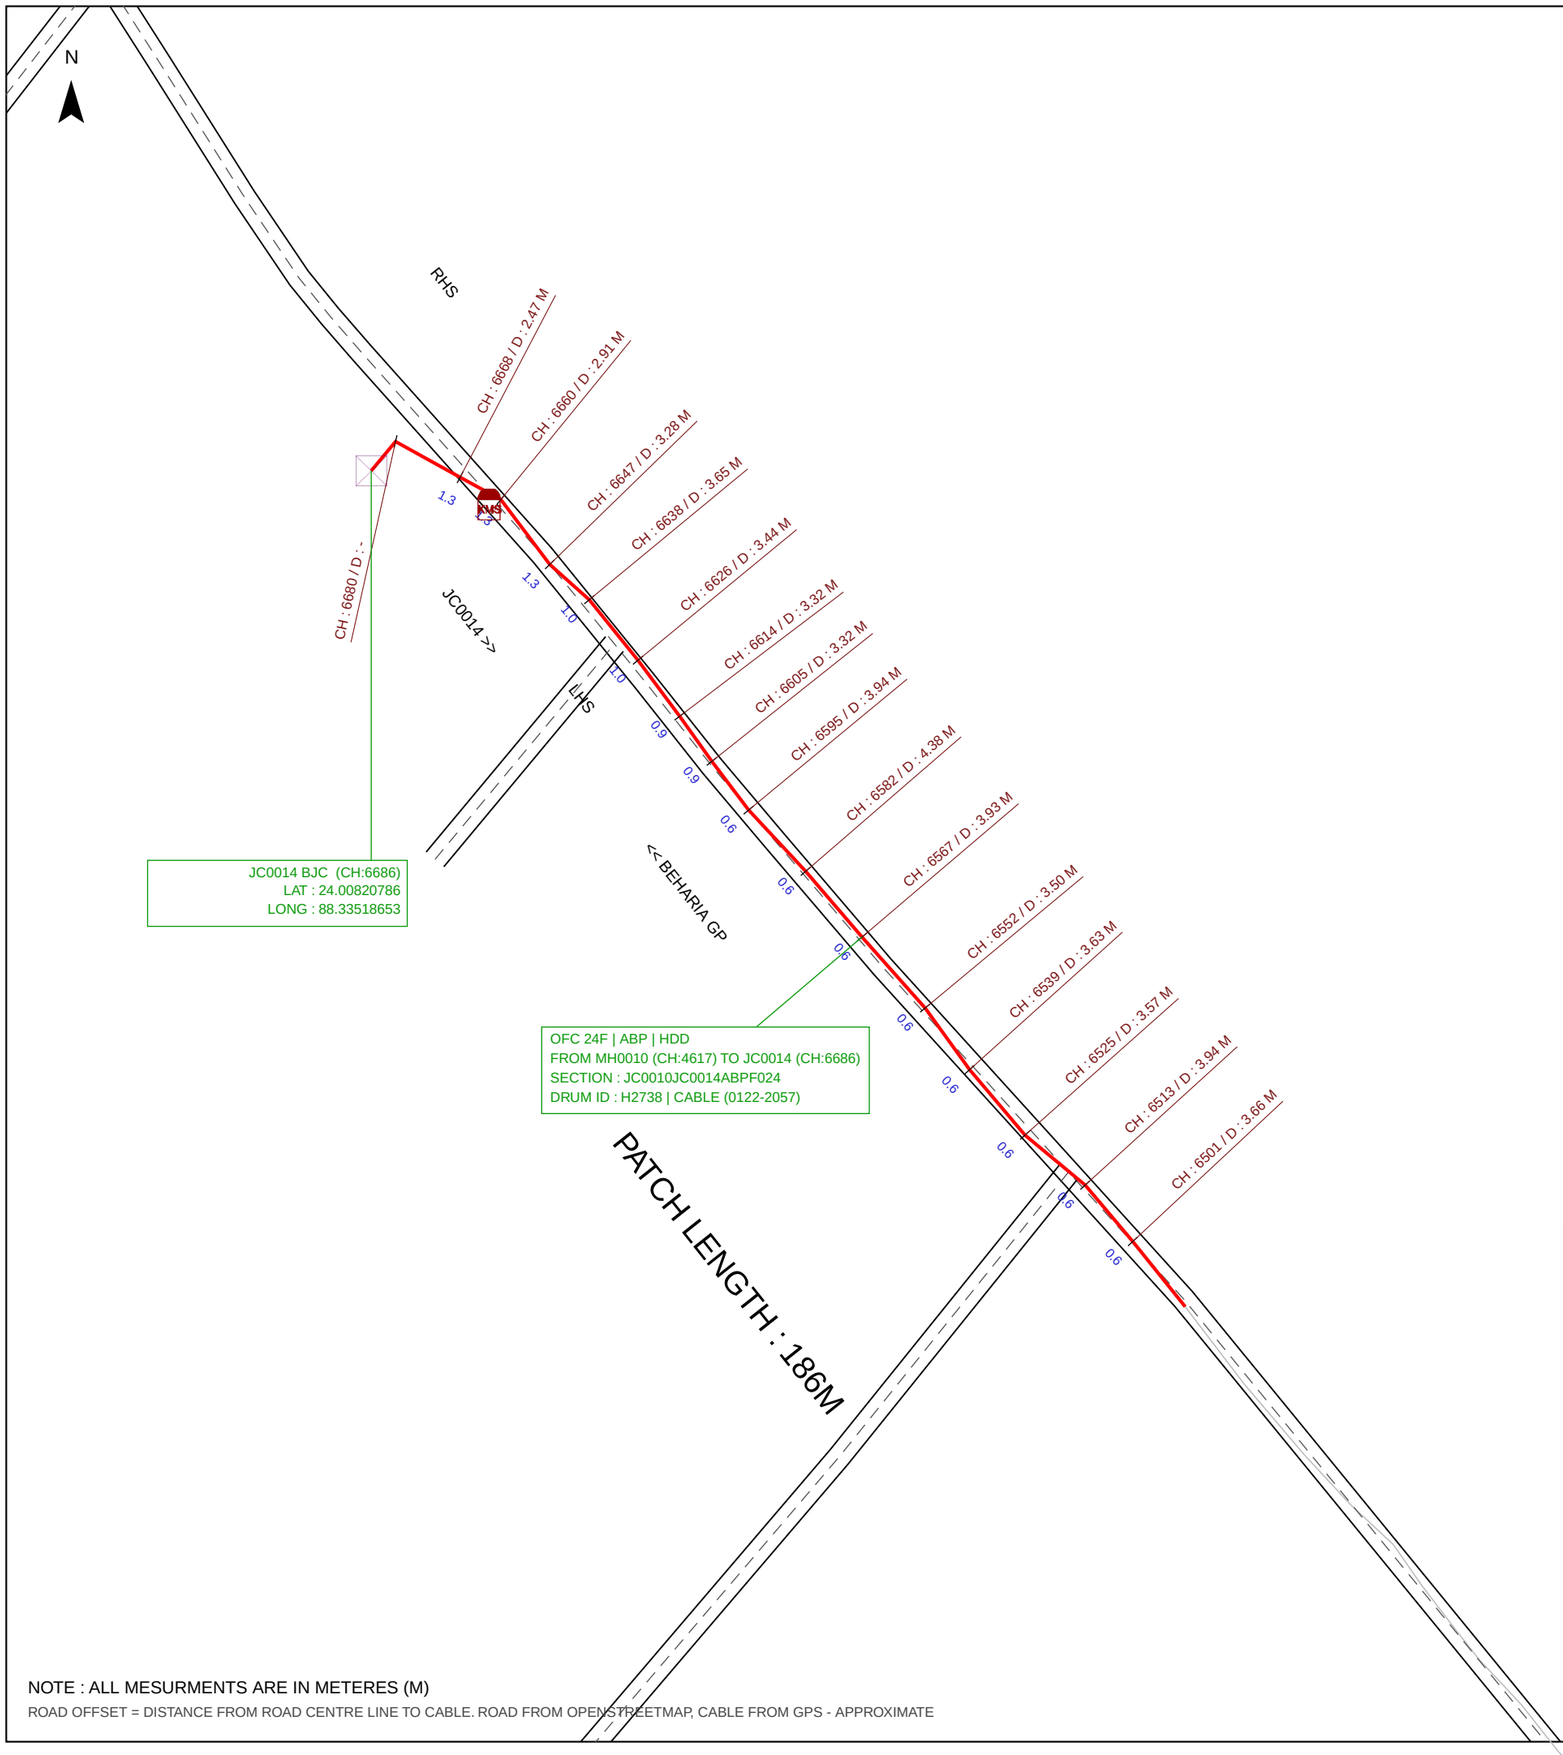

NOTE : ALL MESURMENTS ARE IN METERES (M)

ROAD OFFSET = DISTANCE FROM ROAD CENTRE LINE TO CABLE. ROAD FROM OPENSTREETMAP, CABLE FROM GPS - APPROXIMATE

Amended Bharatnet Program Phase - III

PACKAGE - 9/ WEST BENGAL	PIA - Tera Software
JOB	AS BUILT DRAWING
BLOCK NAME :	HARIHARPARA
SPAN :	BEHARIA GP TO JC0014
FROM GP: BEHARIA GP TO GP: JC0014	

PIA	IE	BSNL

PLANIMETRY SCALE : H/V - 1:1000	SHEET SIZE - A3
FROM CH: 6500 M TO CH: 6686 M	SHEET NO. - 27
Patch Length :- 186 m	DATE: