
LEGEND

BHARAT SANCHAR NIGAM LIMITED

- Existing OFC Route
- Proposed OFC HDD
- Proposed OFC Aerial Route
- Moling
- Block Router
- GP Router
- Bharatnet HandHole
- Bharatnet Handhole Marker
- Bharatnet Manhole Marker
- G.I Pipe
- PVC Pipe
- DWC Pipe
- PCC
- Road Width
- Road ctr Line
- Kilometer Stone
- Protection
- NHAI/Fly Over
- OT
- Culvert
- Bridge
- Railway Tracks
- Railway Crossing
- Road under Rly. Bridge
- Splitter 1:4
- Splitter 1:2
- Gram Panchayat
- Block
- Buildings
- Gate
- Temple
- Gurudwara
- Church
- School
- Mosque
- Bus Stand
- Railway Station
- Airport
- Fire Station
- Police Station
- Hospital
- College/University
- Hotel
- Petrol Bunk
- Theatre
- Industry
- Post Office
- Shopping Mall
- Gas Pipeline Crossing
- High Tension Line
- Transformer
- Tree
- Electrical Pole
- Traffic Signal Pole
- HT Tower
- OFC Stone Others
- DOT Exch
- BSNL BTS
- Telephone Pole
- Proposed Pole
- Existing Pole
- Manhole
- Zero Manhole
- Coupler

AS BUILT DIAGRAM

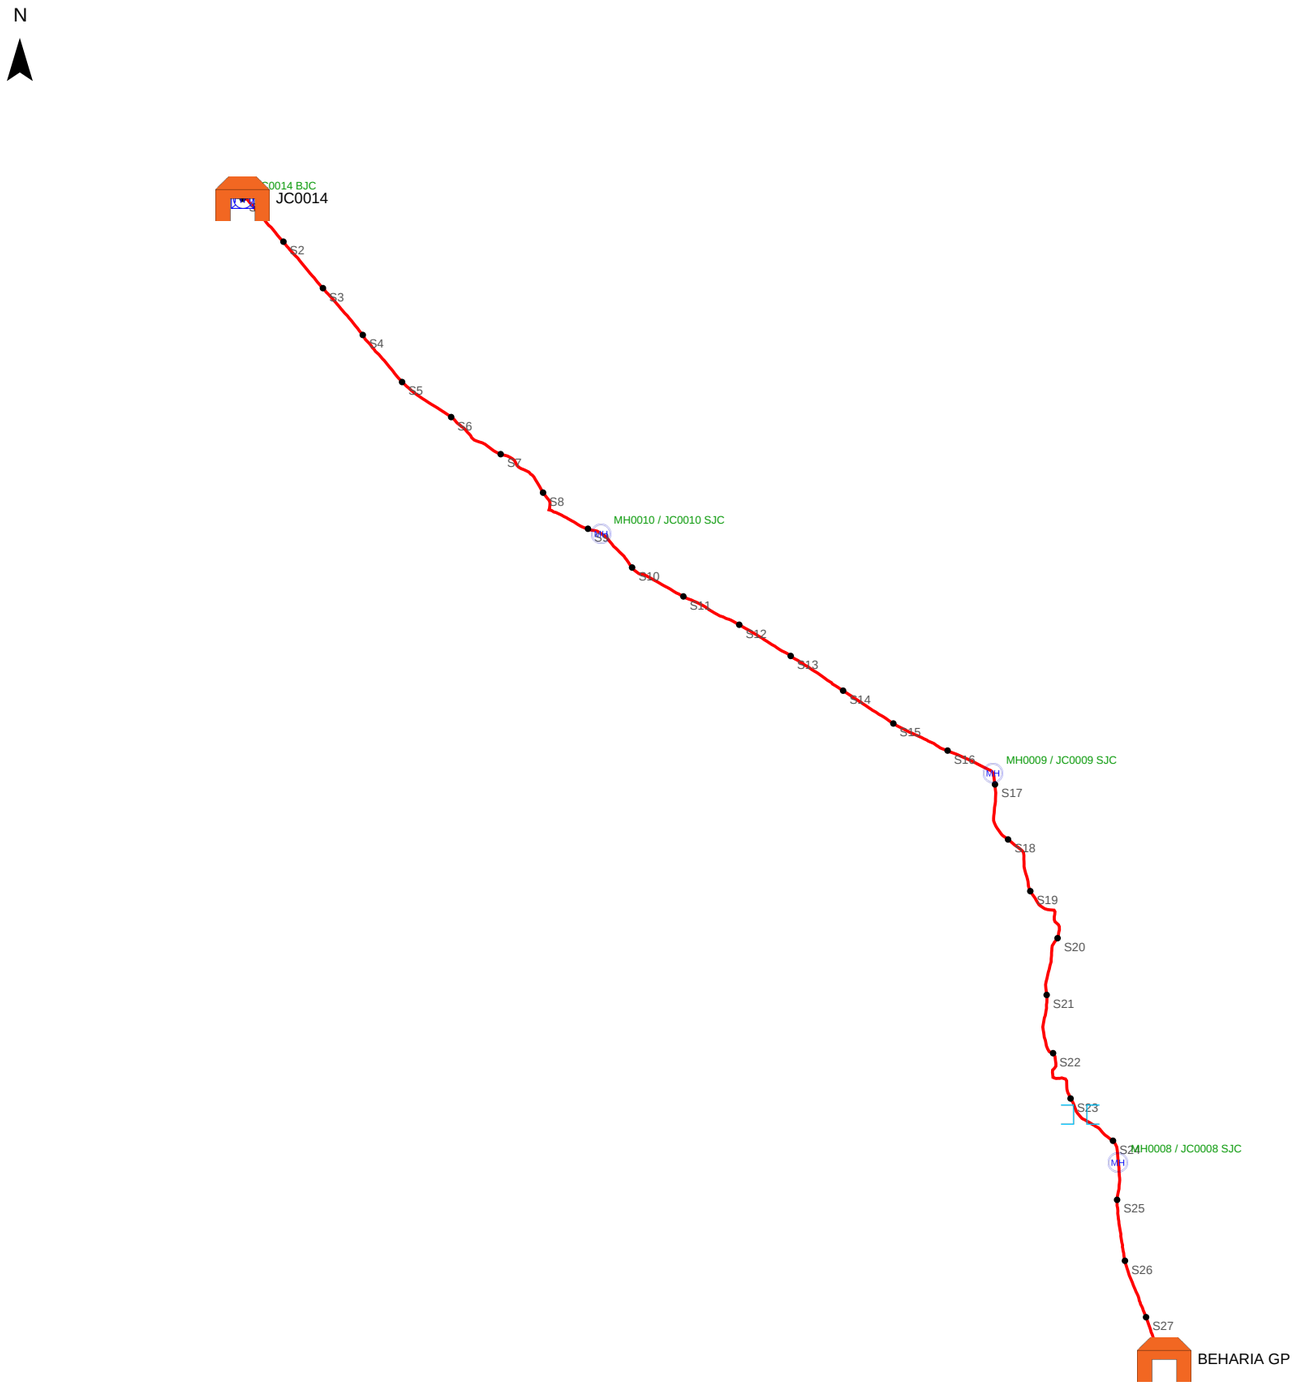

PACKAGE 9/ WEST BENGAL - (ST) - (DT) - (BL)

ÿý ROUTE LENGTH (M) : 6686

ÿý NEW LENGTH (M) : 6686

ÿý HDD LENGTH (M) : 6686

ÿý OT LENGTH (M) : 0

ÿý SURVEYED PIECES : 0

ÿý COUPLERS : 0

ÿý JOINT CHAMBERS / MANHOLES : 4

ÿý ROUTE INDICATORS : 20

ÿý KM STONES : 2

ÿý NO OF CULVERTS : 1

ÿý NO OF BRIDGES : 0

ÿý LANDMARKS : 2

ÿý NOT SURVEYED GAPS (M) : 0

ÿý ROUTE : JC0014 > MH0010 > MH0009 > MH0008 > GP110619

NOTE : ALL MESURMENTS ARE IN METERES (M)


ROAD OFFSET = DISTANCE FROM ROAD CENTRE LINE TO CABLE. ROAD FROM OPENSTREETMAP, CABLE FROM GPS - APPROXIMATE

Amended Bharatnet Program Phase - III

PACKAGE - 9/ WEST BENGAL	PIA - Tera Software
JOB	AS BUILT DRAWING
BLOCK NAME :	
SPAN :	JC0014 TO BEHARIA GP
FROM GP: JC0014 TO GP: BEHARIA GP	

PIA	IE	BSNL

PLANIMETRY SCALE : H/V - 1:25000	SHEET SIZE - A3
FROM CH: 0 M TO CH: 6686 M	SHEET NO. - 00
Span Length :- 6.686 KM	DATE:

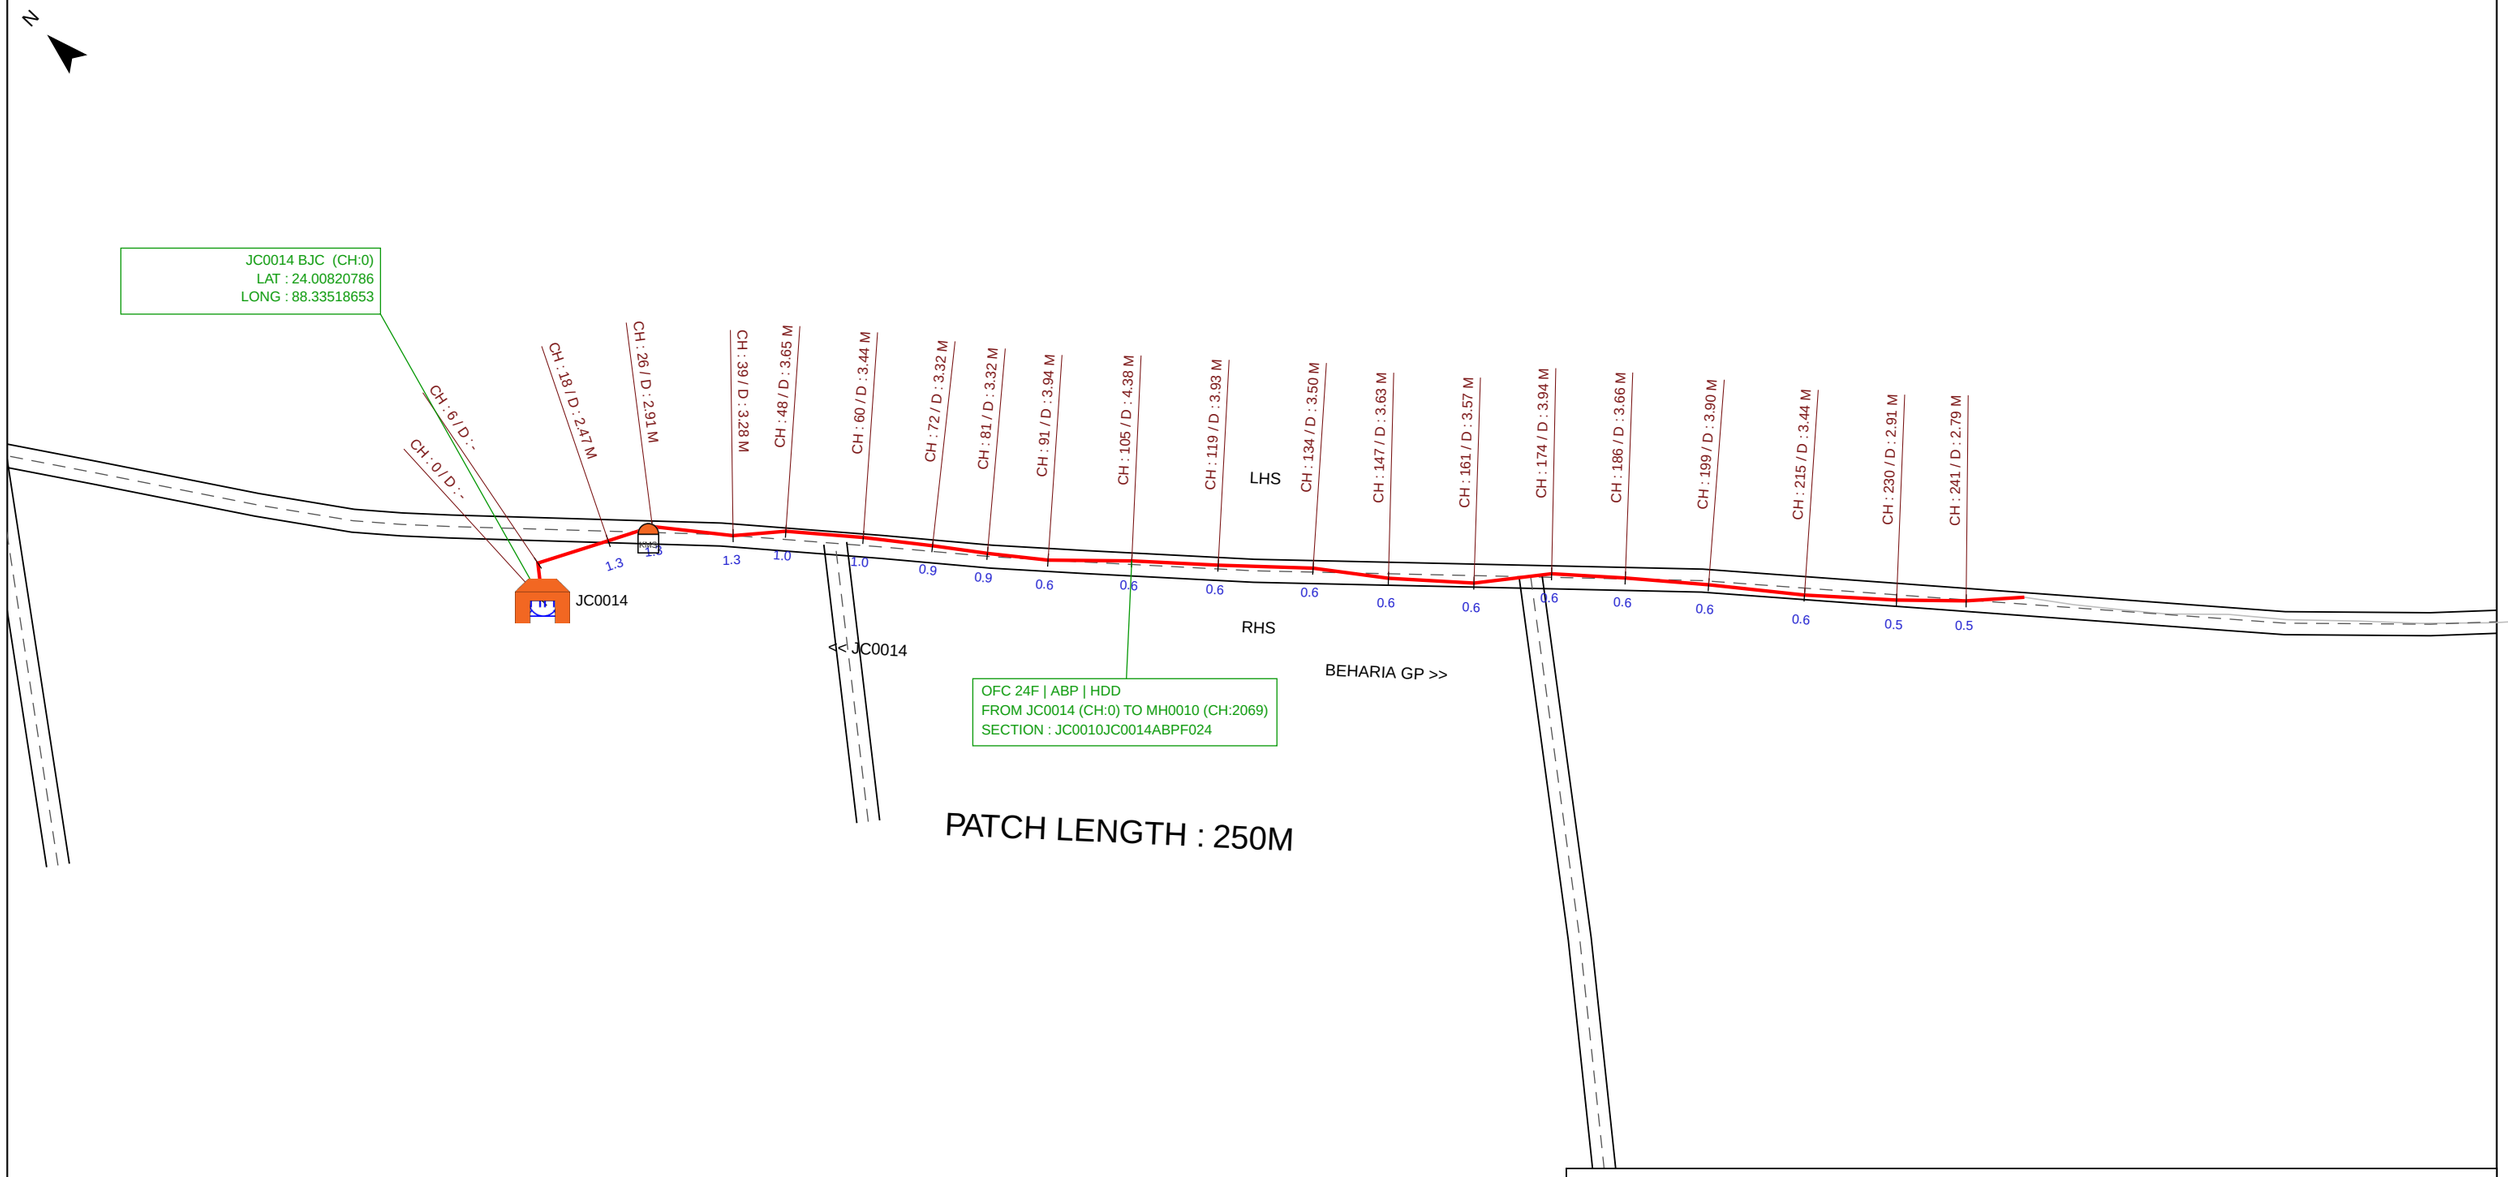

NOTE : ALL MESURMENTS ARE IN METERES (M)

ROAD OFFSET = DISTANCE FROM ROAD CENTRE LINE TO CABLE. ROAD FROM OPENSTREETMAP, CABLE FROM GPS - APPROXIMATE

Amended Bharatnet Program Phase - III


PACKAGE - 9/ WEST BENGAL	PIA - Tera Software
JOB	AS BUILT DRAWING
BLOCK NAME :	
SPAN :	JC0014 TO BEHARIA GP
FROM GP: JC0014 TO GP: BEHARIA GP	

PIA	IE	BSNL

PLANIMETRY SCALE : H/V - 1:1000	SHEET SIZE - A3
FROM CH: 0 M TO CH: 250 M	SHEET NO. - 1
Patch Length :- 250 m	DATE:

N

PATCH LENGTH : 250M

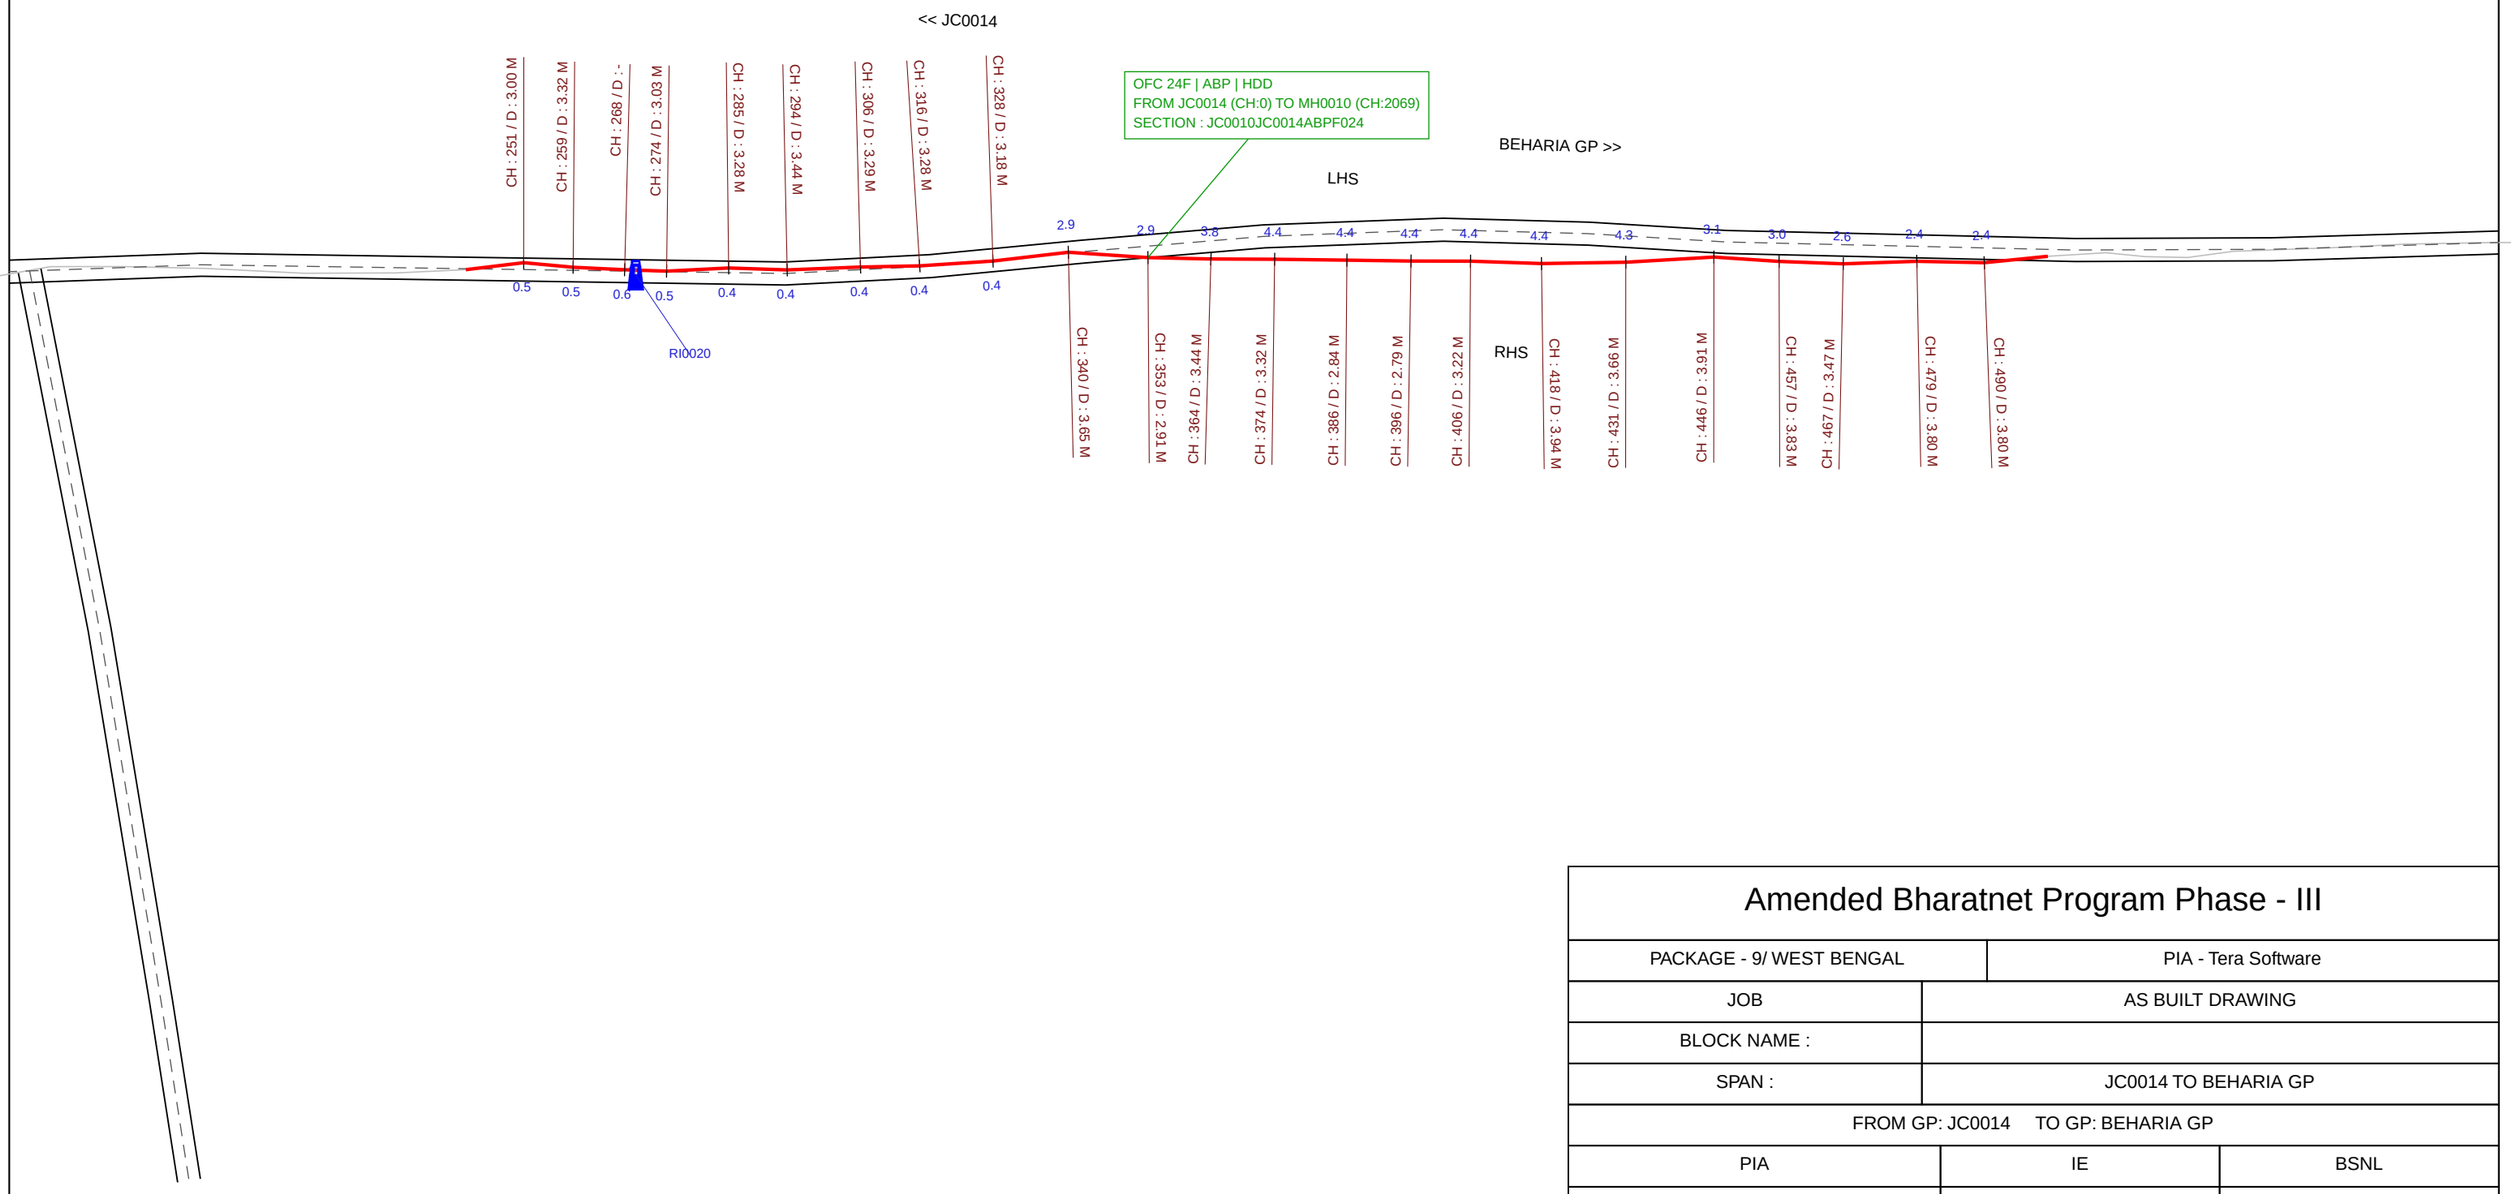

NOTE : ALL MESURMENTS ARE IN METERES (M)


ROAD OFFSET = DISTANCE FROM ROAD CENTRE LINE TO CABLE. ROAD FROM OPENSTREETMAP, CABLE FROM GPS - APPROXIMATE

Amended Bharatnet Program Phase - III

PACKAGE - 9/ WEST BENGAL	PIA - Tera Software	
JOB	AS BUILT DRAWING	
BLOCK NAME :		
SPAN :	JC0014 TO BEHARIA GP	
FROM GP: JC0014 TO GP: BEHARIA GP		
PIA	IE	BSNL
PLANIMETRY SCALE : H/V - 1:1000	SHEET SIZE - A3	
FROM CH: 250 M TO CH: 500 M	SHEET NO. - 2	
Patch Length :- 250 m	DATE:	

N

PATCH LENGTH : 250M

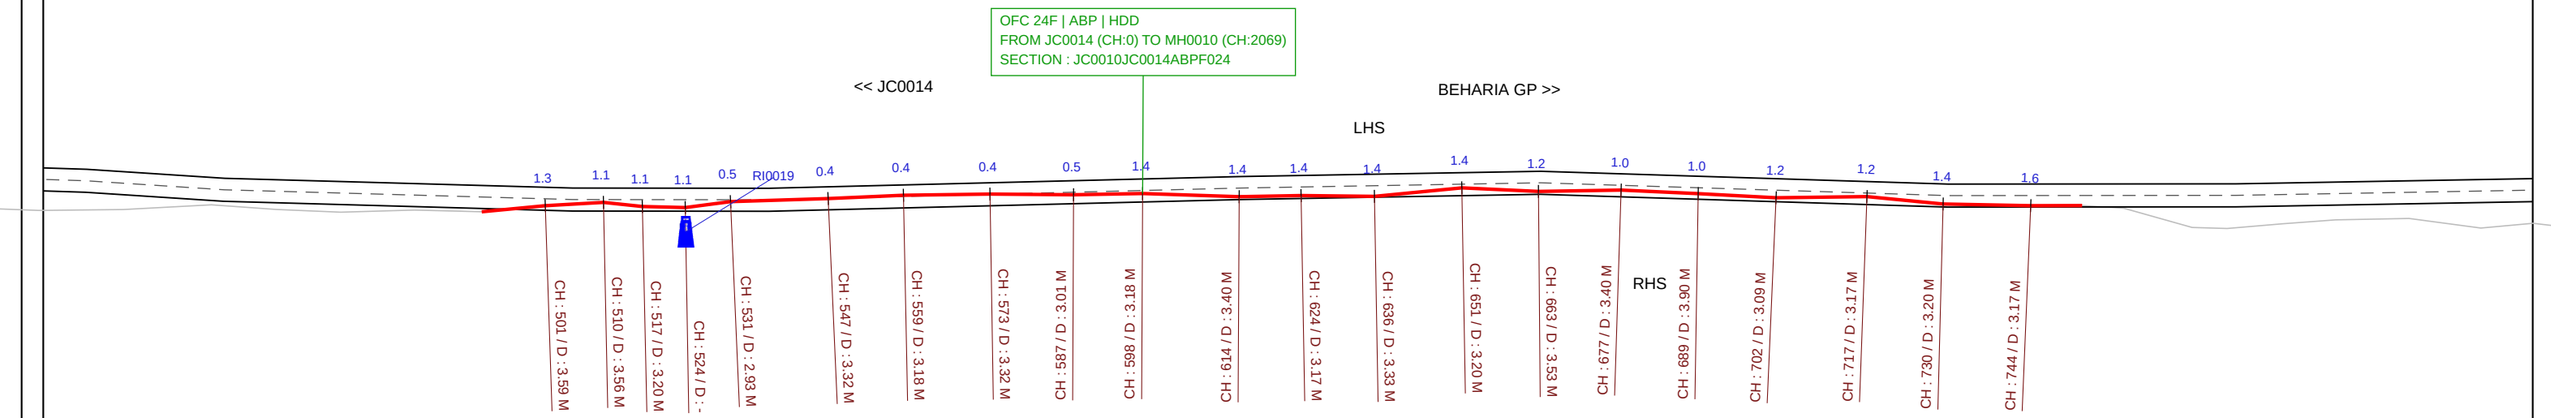

NOTE : ALL MESURMENTS ARE IN METERES (M)


ROAD OFFSET = DISTANCE FROM ROAD CENTRE LINE TO CABLE. ROAD FROM OPENSTREETMAP, CABLE FROM GPS - APPROXIMATE

Amended Bharatnet Program Phase - III

PACKAGE - 9/ WEST BENGAL	PIA - Tera Software
JOB	AS BUILT DRAWING
BLOCK NAME :	
SPAN :	JC0014 TO BEHARIA GP
FROM GP: JC0014 TO GP: BEHARIA GP	

PIA	IE	BSNL

PLANIMETRY SCALE : H/V - 1:1000	SHEET SIZE - A3
FROM CH: 500 M TO CH: 750 M	SHEET NO. - 3
Patch Length :- 250 m	DATE:

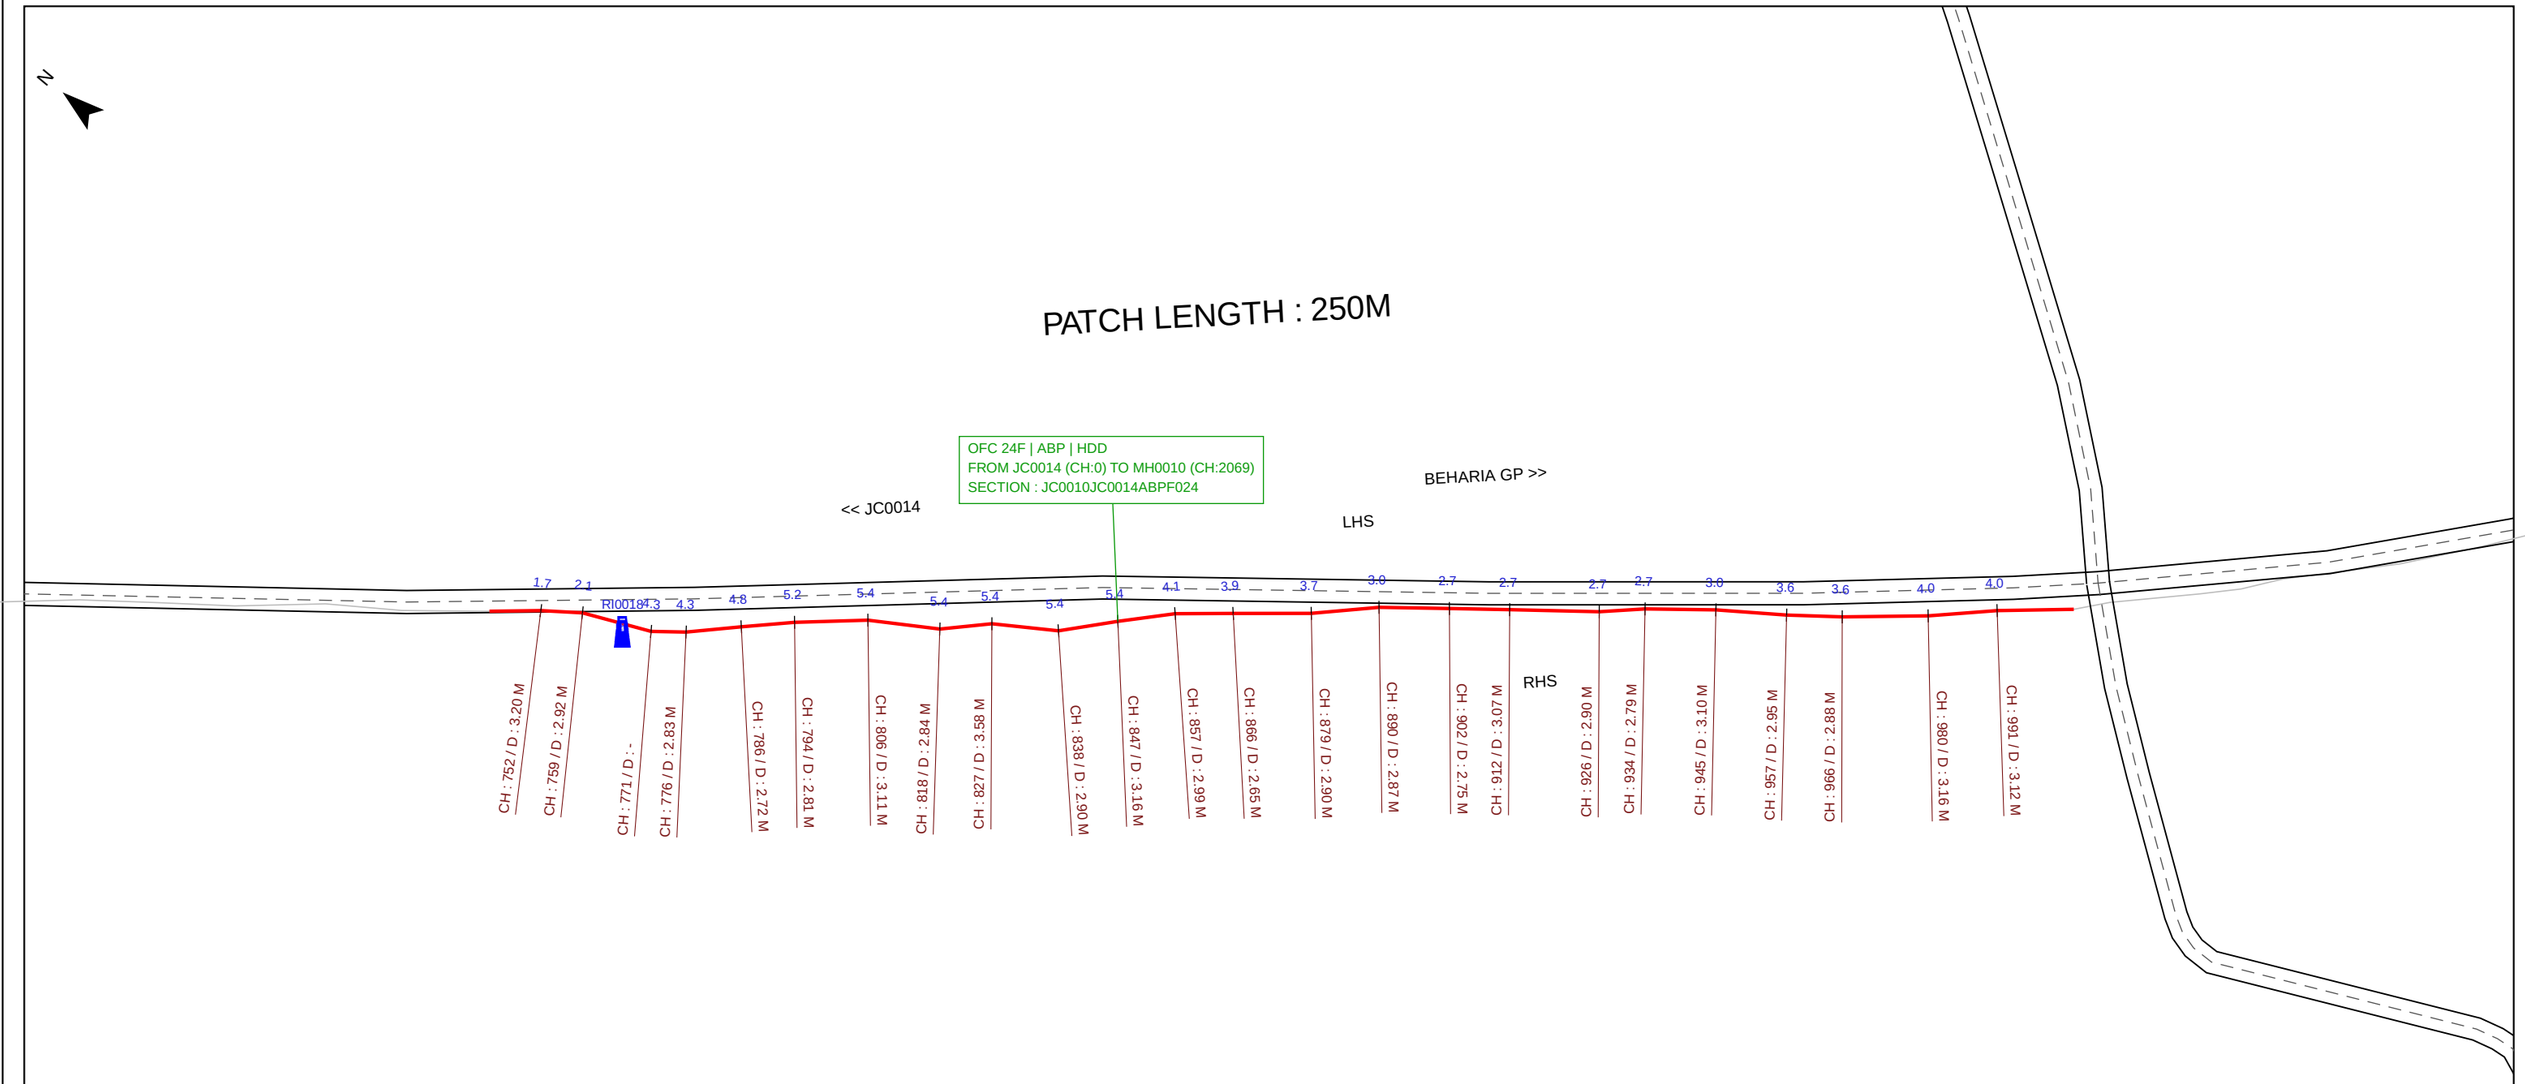

NOTE : ALL MESURMENTS ARE IN METERES (M)


ROAD OFFSET = DISTANCE FROM ROAD CENTRE LINE TO CABLE. ROAD FROM OPENSTREETMAP, CABLE FROM GPS - APPROXIMATE

Amended Bharatnet Program Phase - III

PACKAGE - 9/ WEST BENGAL	PIA - Tera Software
JOB	AS BUILT DRAWING
BLOCK NAME :	
SPAN :	JC0014 TO BEHARIA GP
FROM GP: JC0014 TO GP: BEHARIA GP	

PIA	IE	BSNL

PLANIMETRY SCALE : H/V - 1:1000	SHEET SIZE - A3
FROM CH: 750 M TO CH: 1000 M	SHEET NO. - 4
Patch Length :- 250 m	DATE:

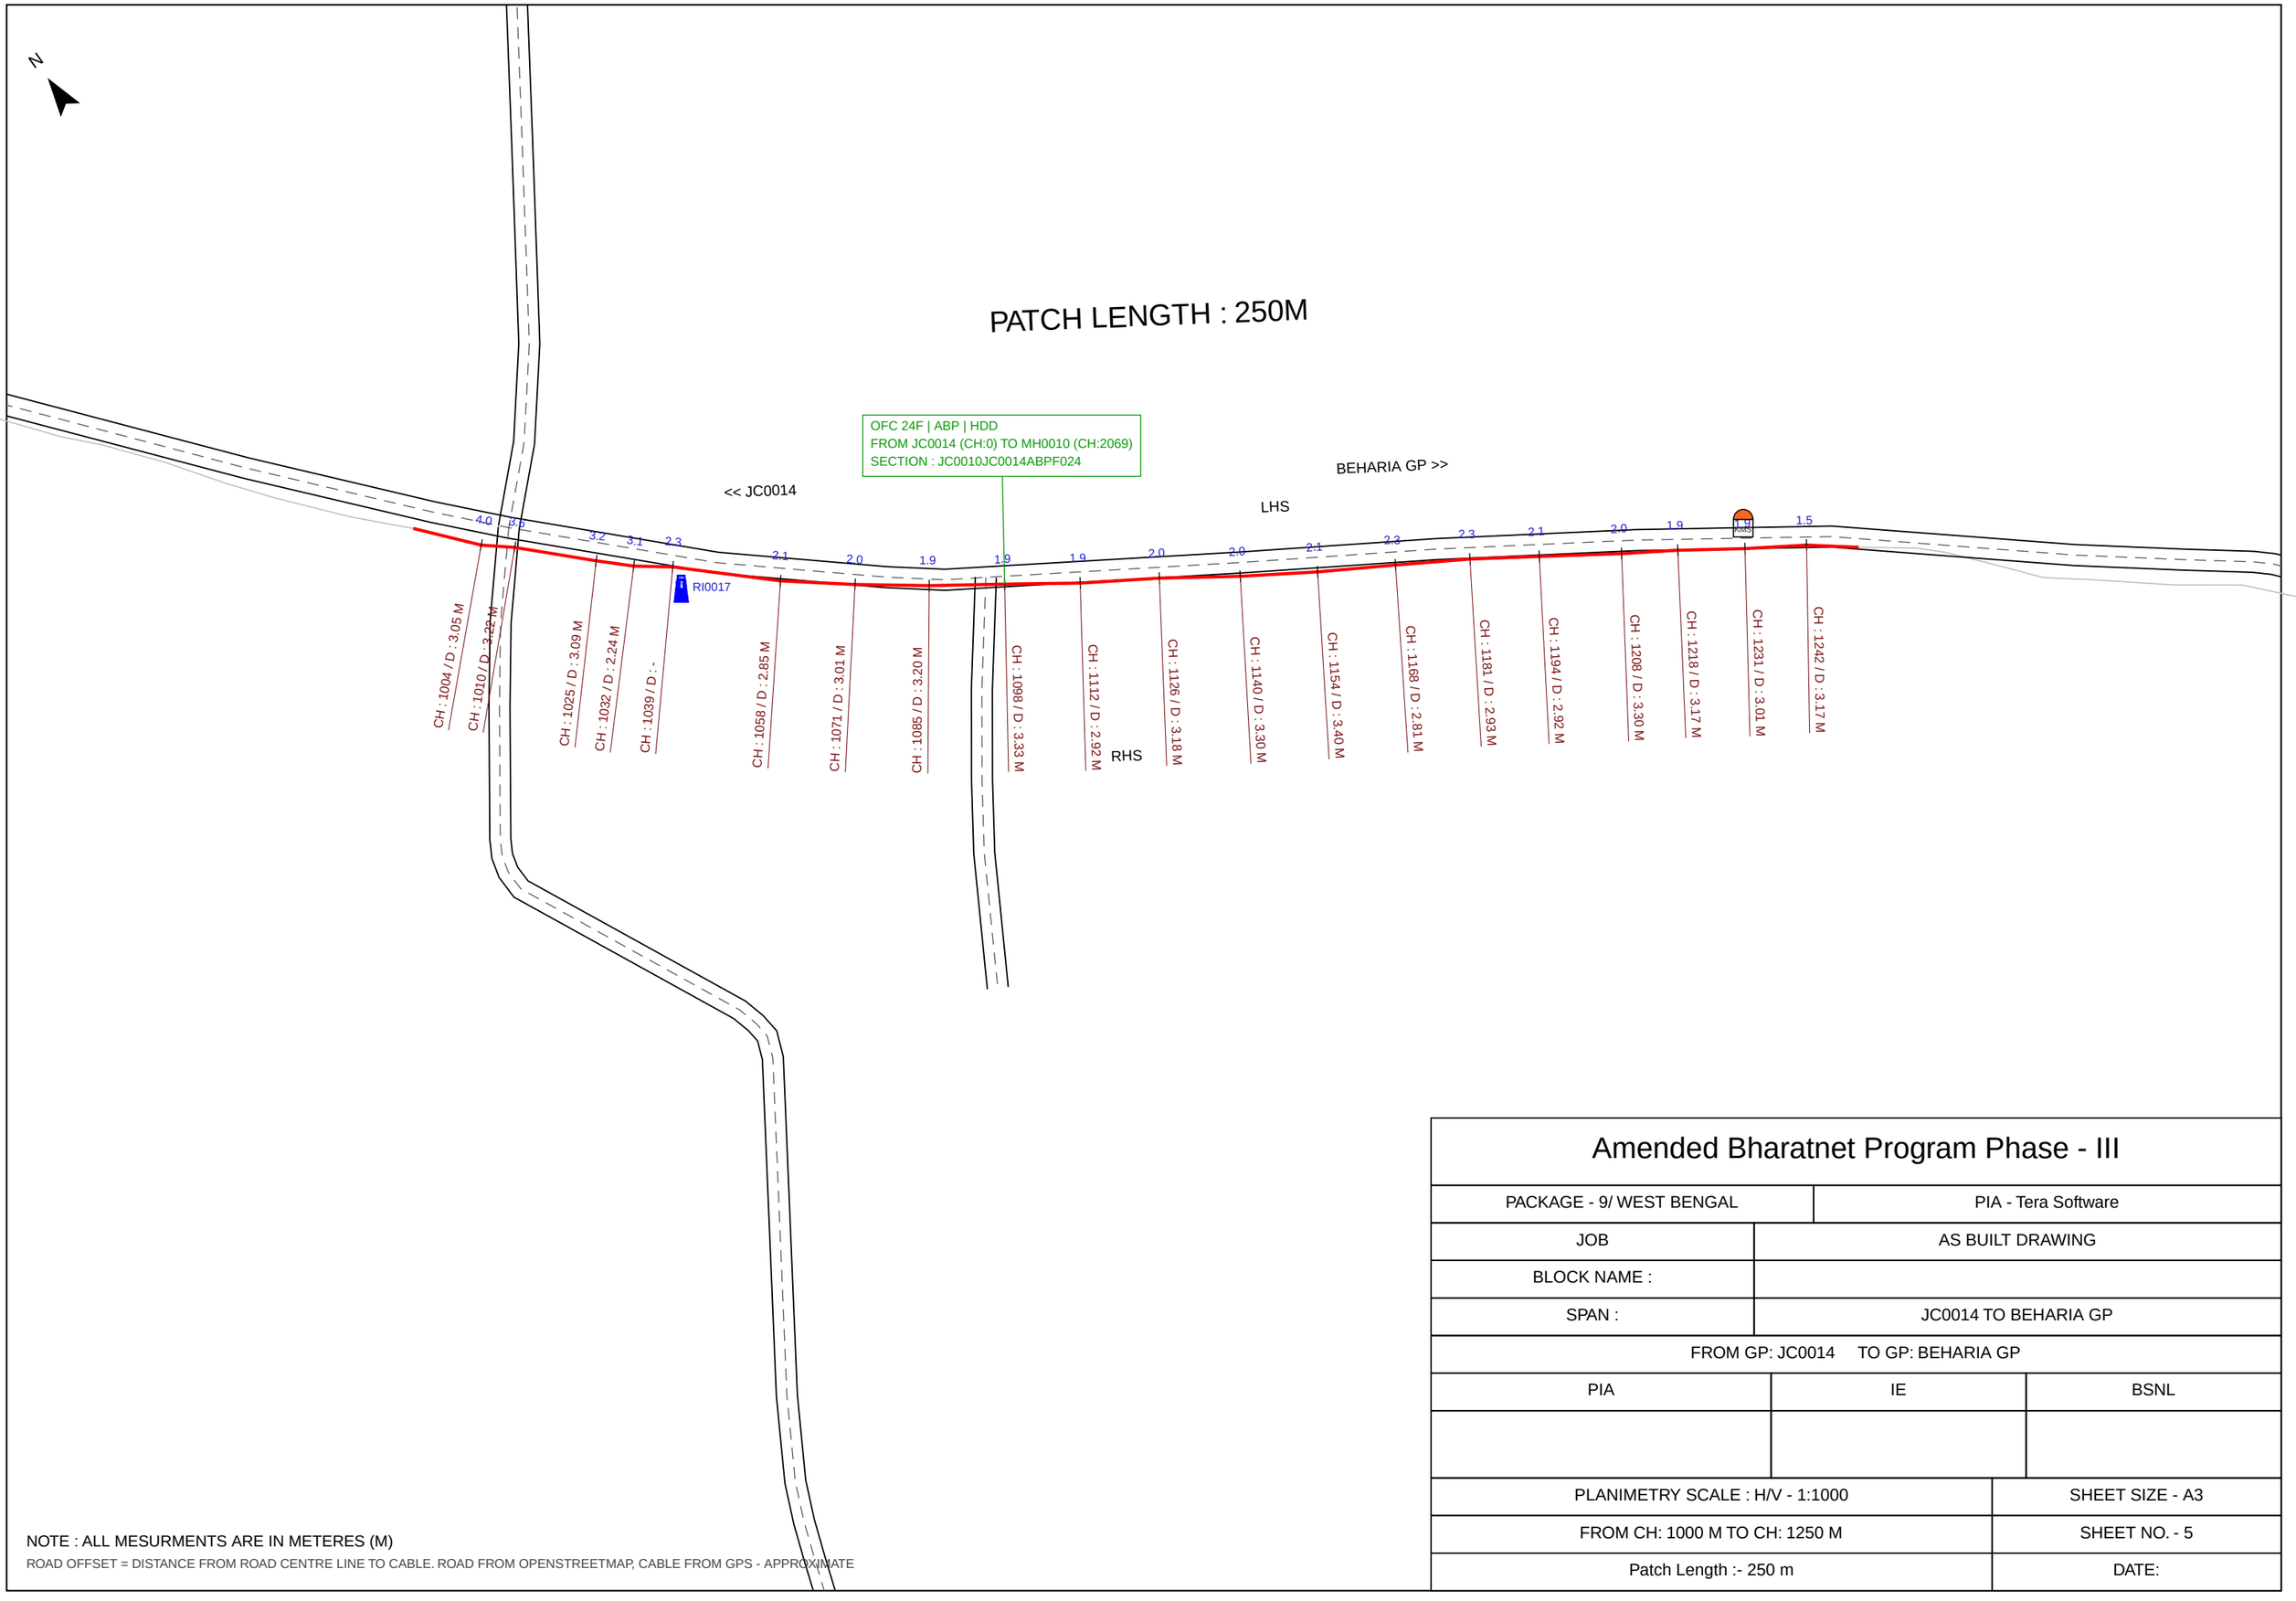

NOTE : ALL MESURMENTS ARE IN METERES (M)

ROAD OFFSET = DISTANCE FROM ROAD CENTRE LINE TO CABLE. ROAD FROM OPENSTREETMAP, CABLE FROM GPS - APPROXIMATE

Amended Bharatnet Program Phase - III


PACKAGE - 9/ WEST BENGAL	PIA - Tera Software
JOB	AS BUILT DRAWING
BLOCK NAME :	
SPAN :	JC0014 TO BEHARIA GP
FROM GP: JC0014 TO GP: BEHARIA GP	

PIA	IE	BSNL

PLANIMETRY SCALE : H/V - 1:1000	SHEET SIZE - A3
FROM CH: 1000 M TO CH: 1250 M	SHEET NO. - 5
Patch Length :- 250 m	DATE:

N

PATCH LENGTH : 250M

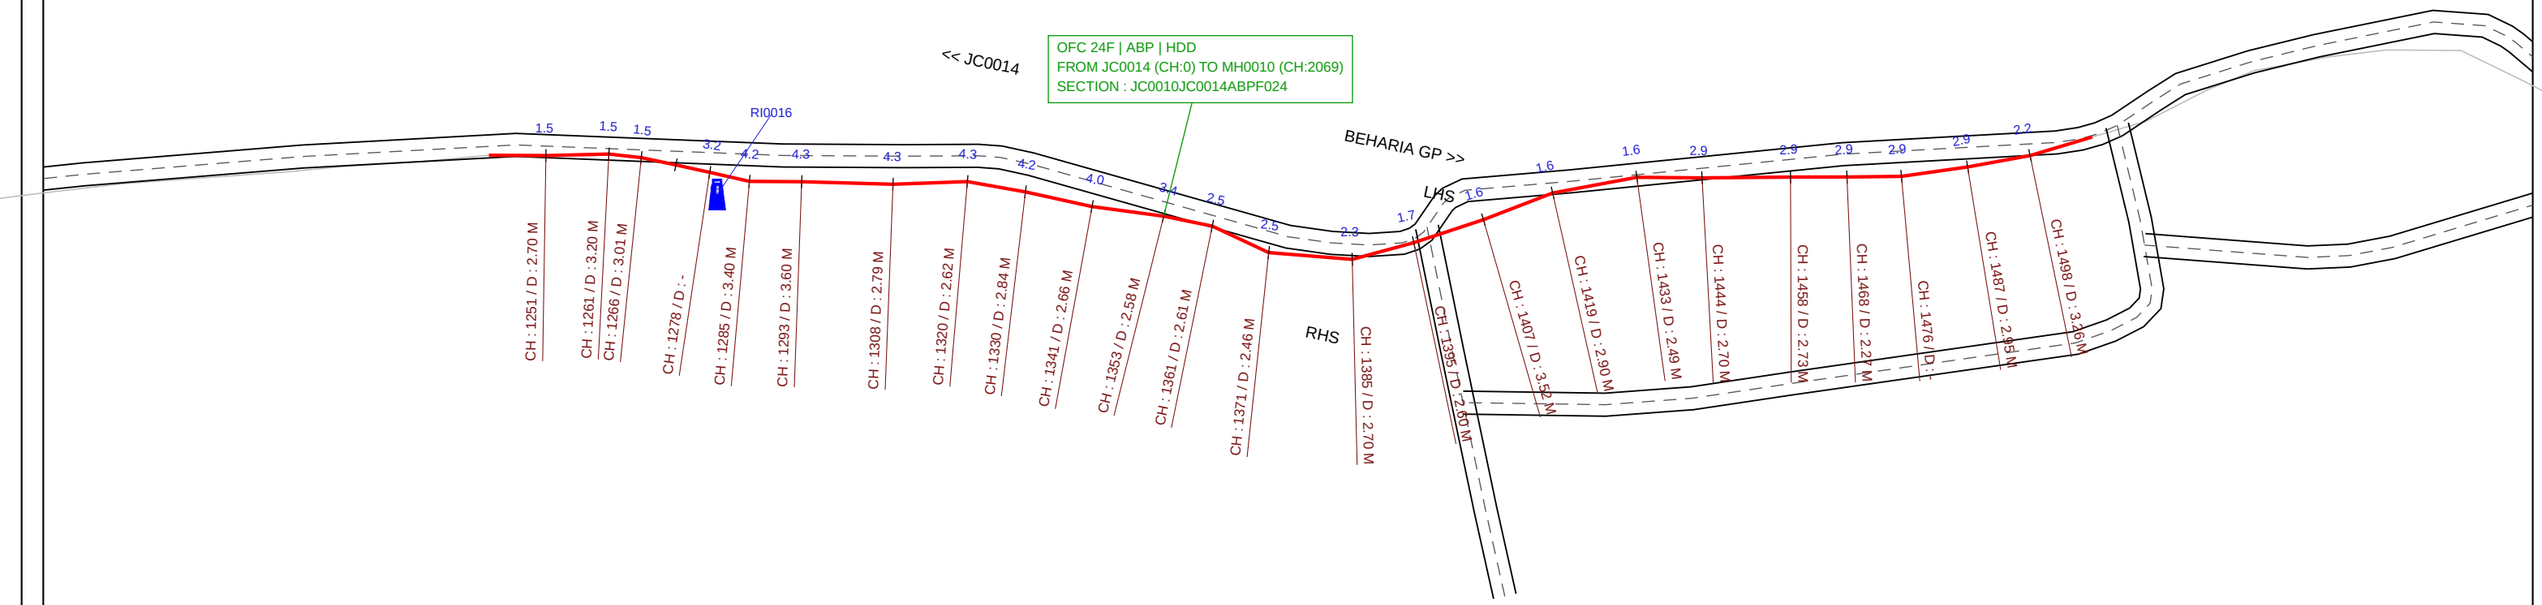


NOTE : ALL MESURMENTS ARE IN METERES (M)

ROAD OFFSET = DISTANCE FROM ROAD CENTRE LINE TO CABLE. ROAD FROM OPENSTREETMAP, CABLE FROM GPS - APPROXIMATE

Amended Bharatnet Program Phase - III

PACKAGE - 9/ WEST BENGAL	PIA - Tera Software	
JOB	AS BUILT DRAWING	
BLOCK NAME :		
SPAN :	JC0014 TO BEHARIA GP	
FROM GP: JC0014 TO GP: BEHARIA GP		
PIA	IE	BSNL
PLANIMETRY SCALE : H/V - 1:1000	SHEET SIZE - A3	
FROM CH: 1250 M TO CH: 1500 M	SHEET NO. - 6	
Patch Length :- 250 m	DATE:	

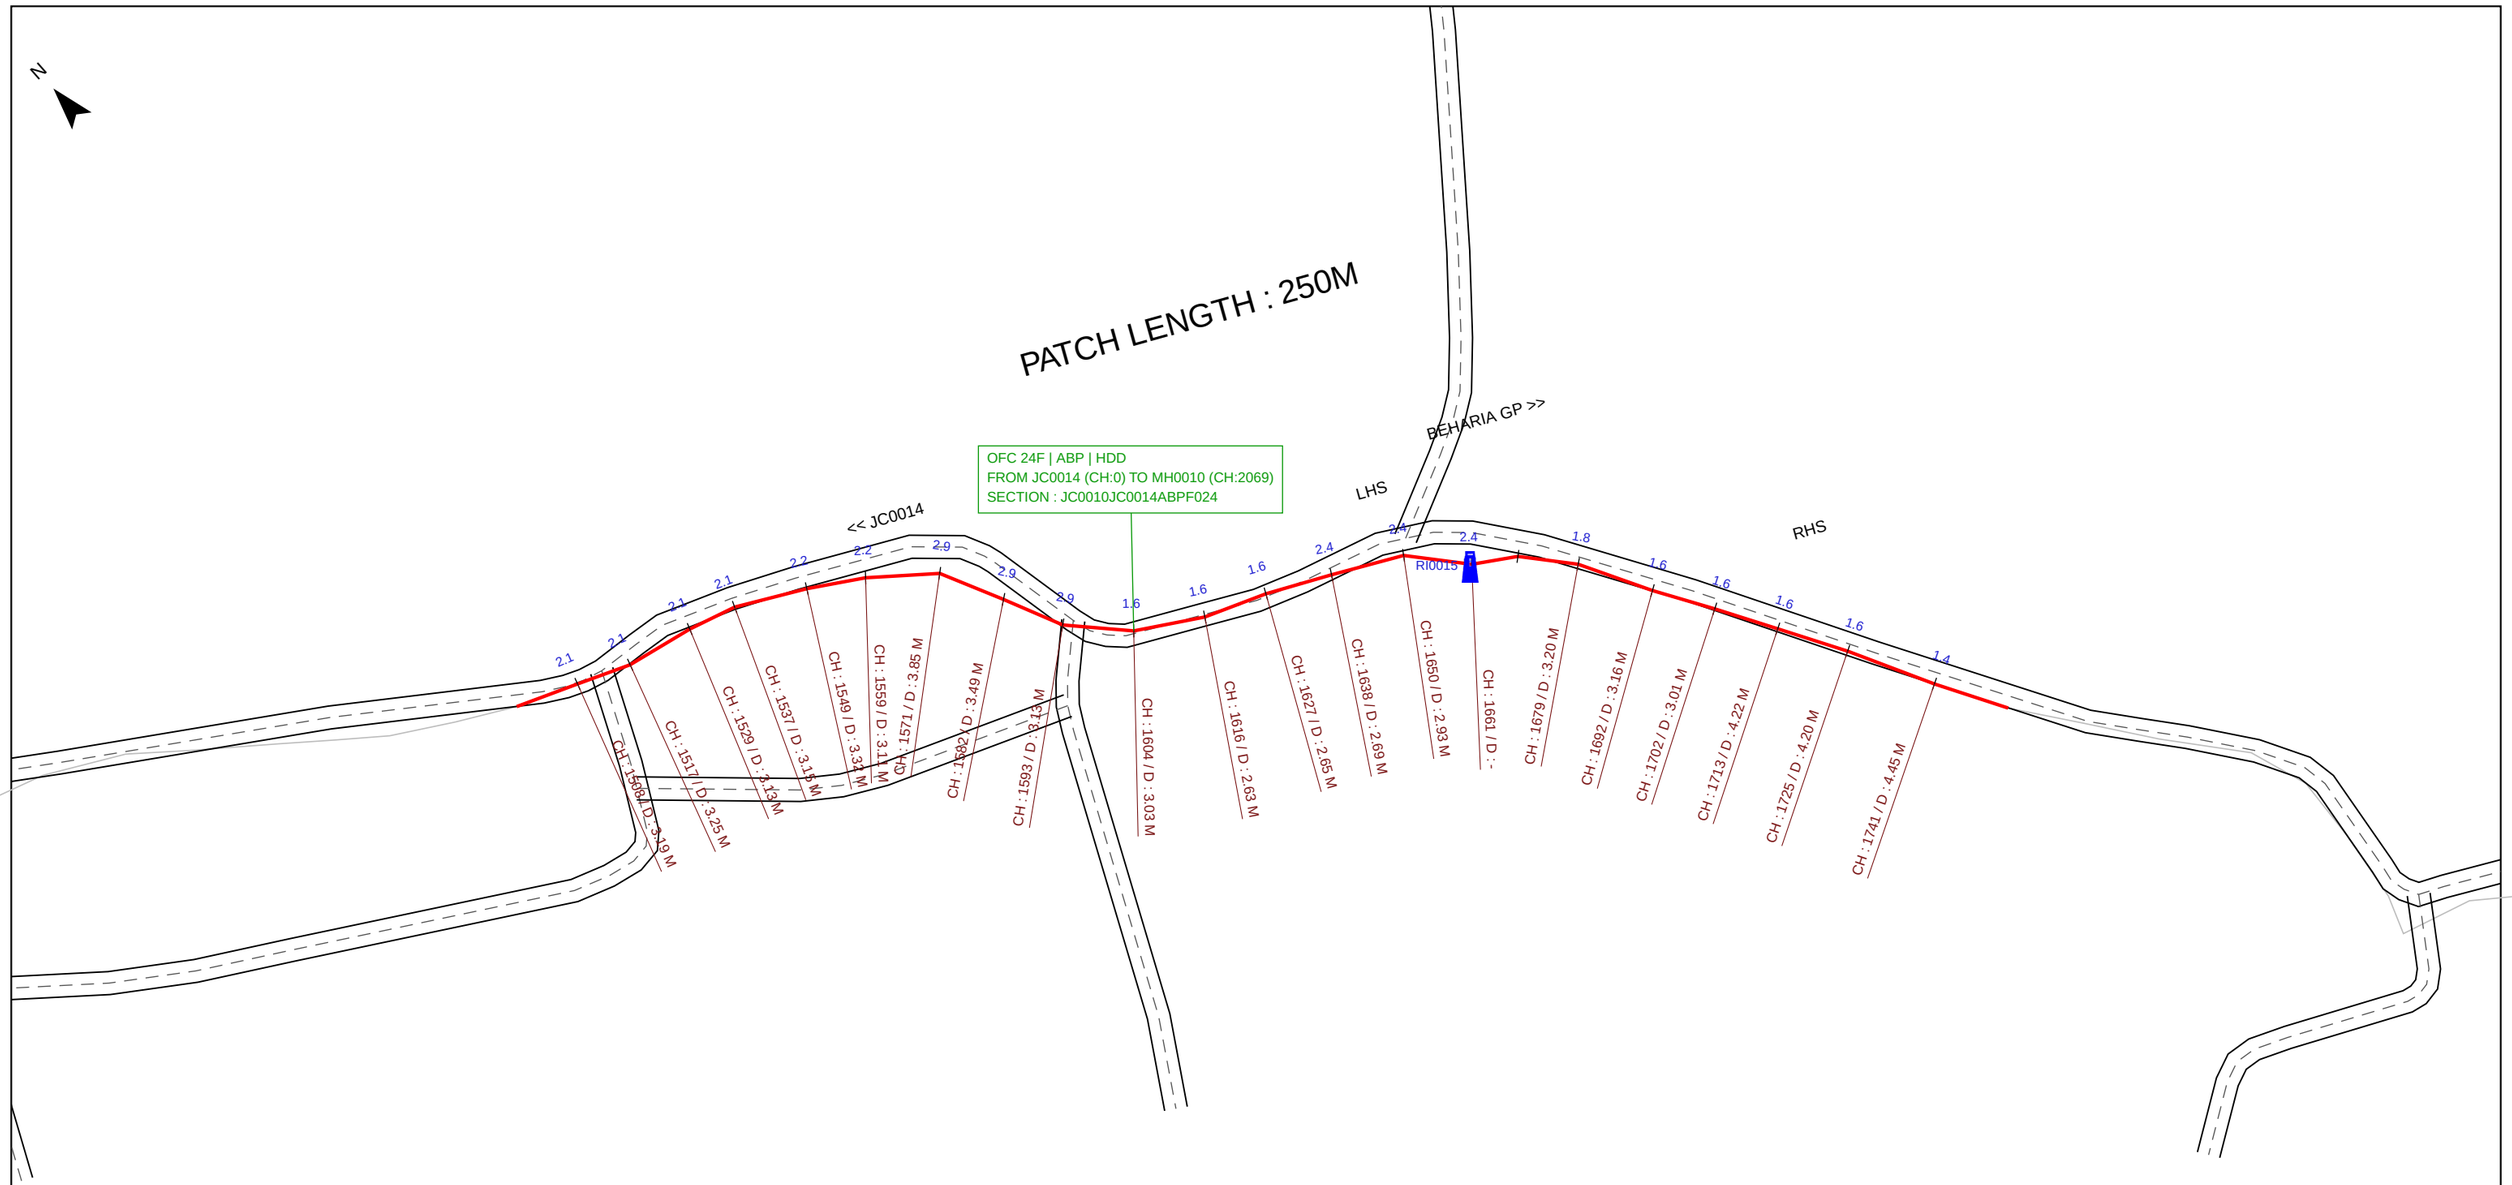

NOTE : ALL MESURMENTS ARE IN METERES (M)


ROAD OFFSET = DISTANCE FROM ROAD CENTRE LINE TO CABLE. ROAD FROM OPENSTREETMAP, CABLE FROM GPS - APPROXIMATE

Amended Bharatnet Program Phase - III

PACKAGE - 9/ WEST BENGAL	PIA - Tera Software
JOB	AS BUILT DRAWING
BLOCK NAME :	
SPAN :	JC0014 TO BEHARIA GP
FROM GP: JC0014 TO GP: BEHARIA GP	

PIA	IE	BSNL

PLANIMETRY SCALE : H/V - 1:1000	SHEET SIZE - A3
FROM CH: 1500 M TO CH: 1750 M	SHEET NO. - 7
Patch Length :- 250 m	DATE:

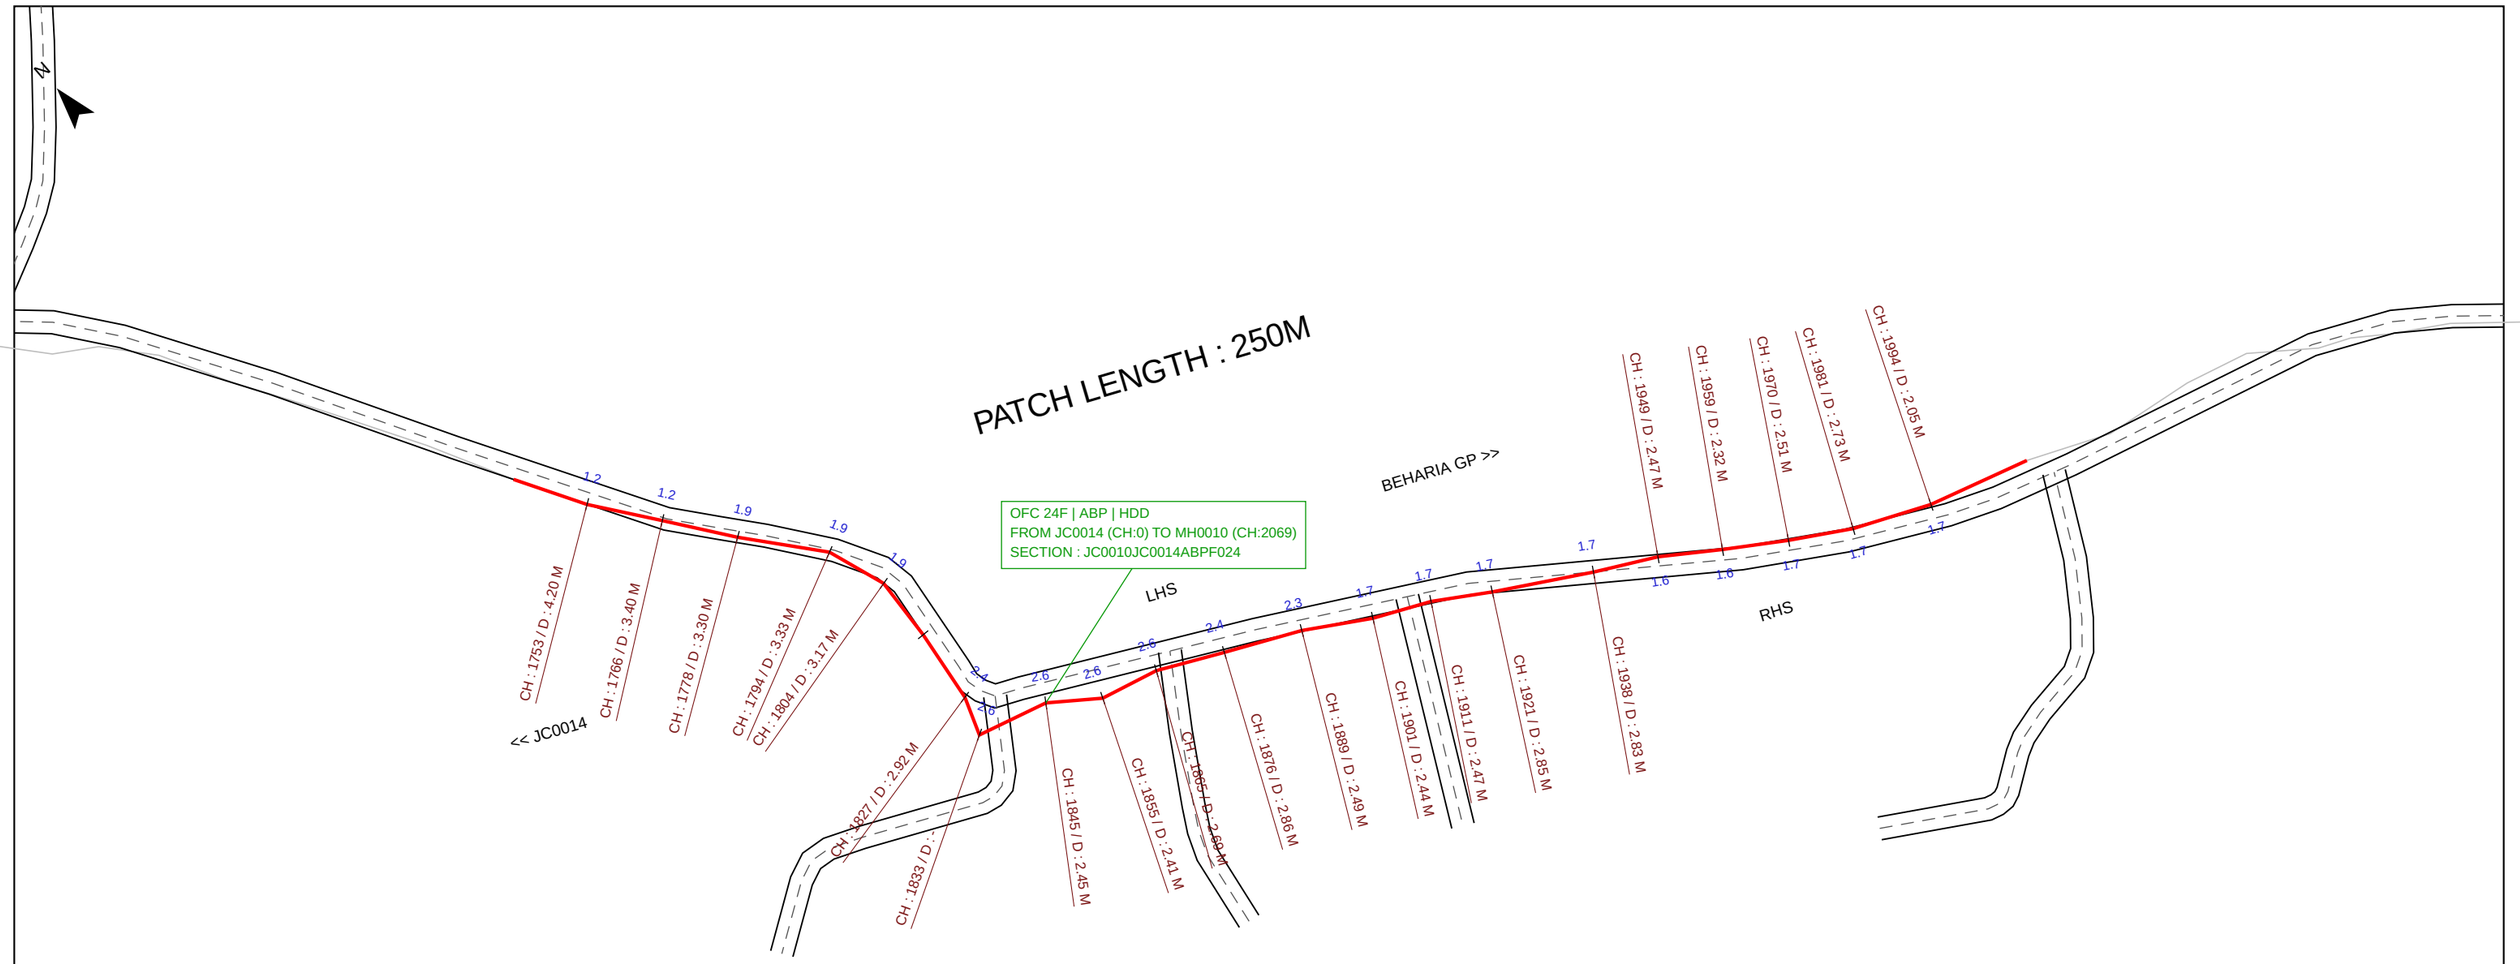


NOTE : ALL MESURMENTS ARE IN METERES (M)

ROAD OFFSET = DISTANCE FROM ROAD CENTRE LINE TO CABLE. ROAD FROM OPENSTREETMAP, CABLE FROM GPS - APPROXIMATE

Amended Bharatnet Program Phase - III

PACKAGE - 9/ WEST BENGAL	PIA - Tera Software	
JOB	AS BUILT DRAWING	
BLOCK NAME :		
SPAN :	JC0014 TO BEHARIA GP	
FROM GP: JC0014 TO GP: BEHARIA GP		
PIA	IE	BSNL
PLANIMETRY SCALE : H/V - 1:1000	SHEET SIZE - A3	
FROM CH: 1750 M TO CH: 2000 M	SHEET NO. - 8	
Patch Length :- 250 m	DATE:	

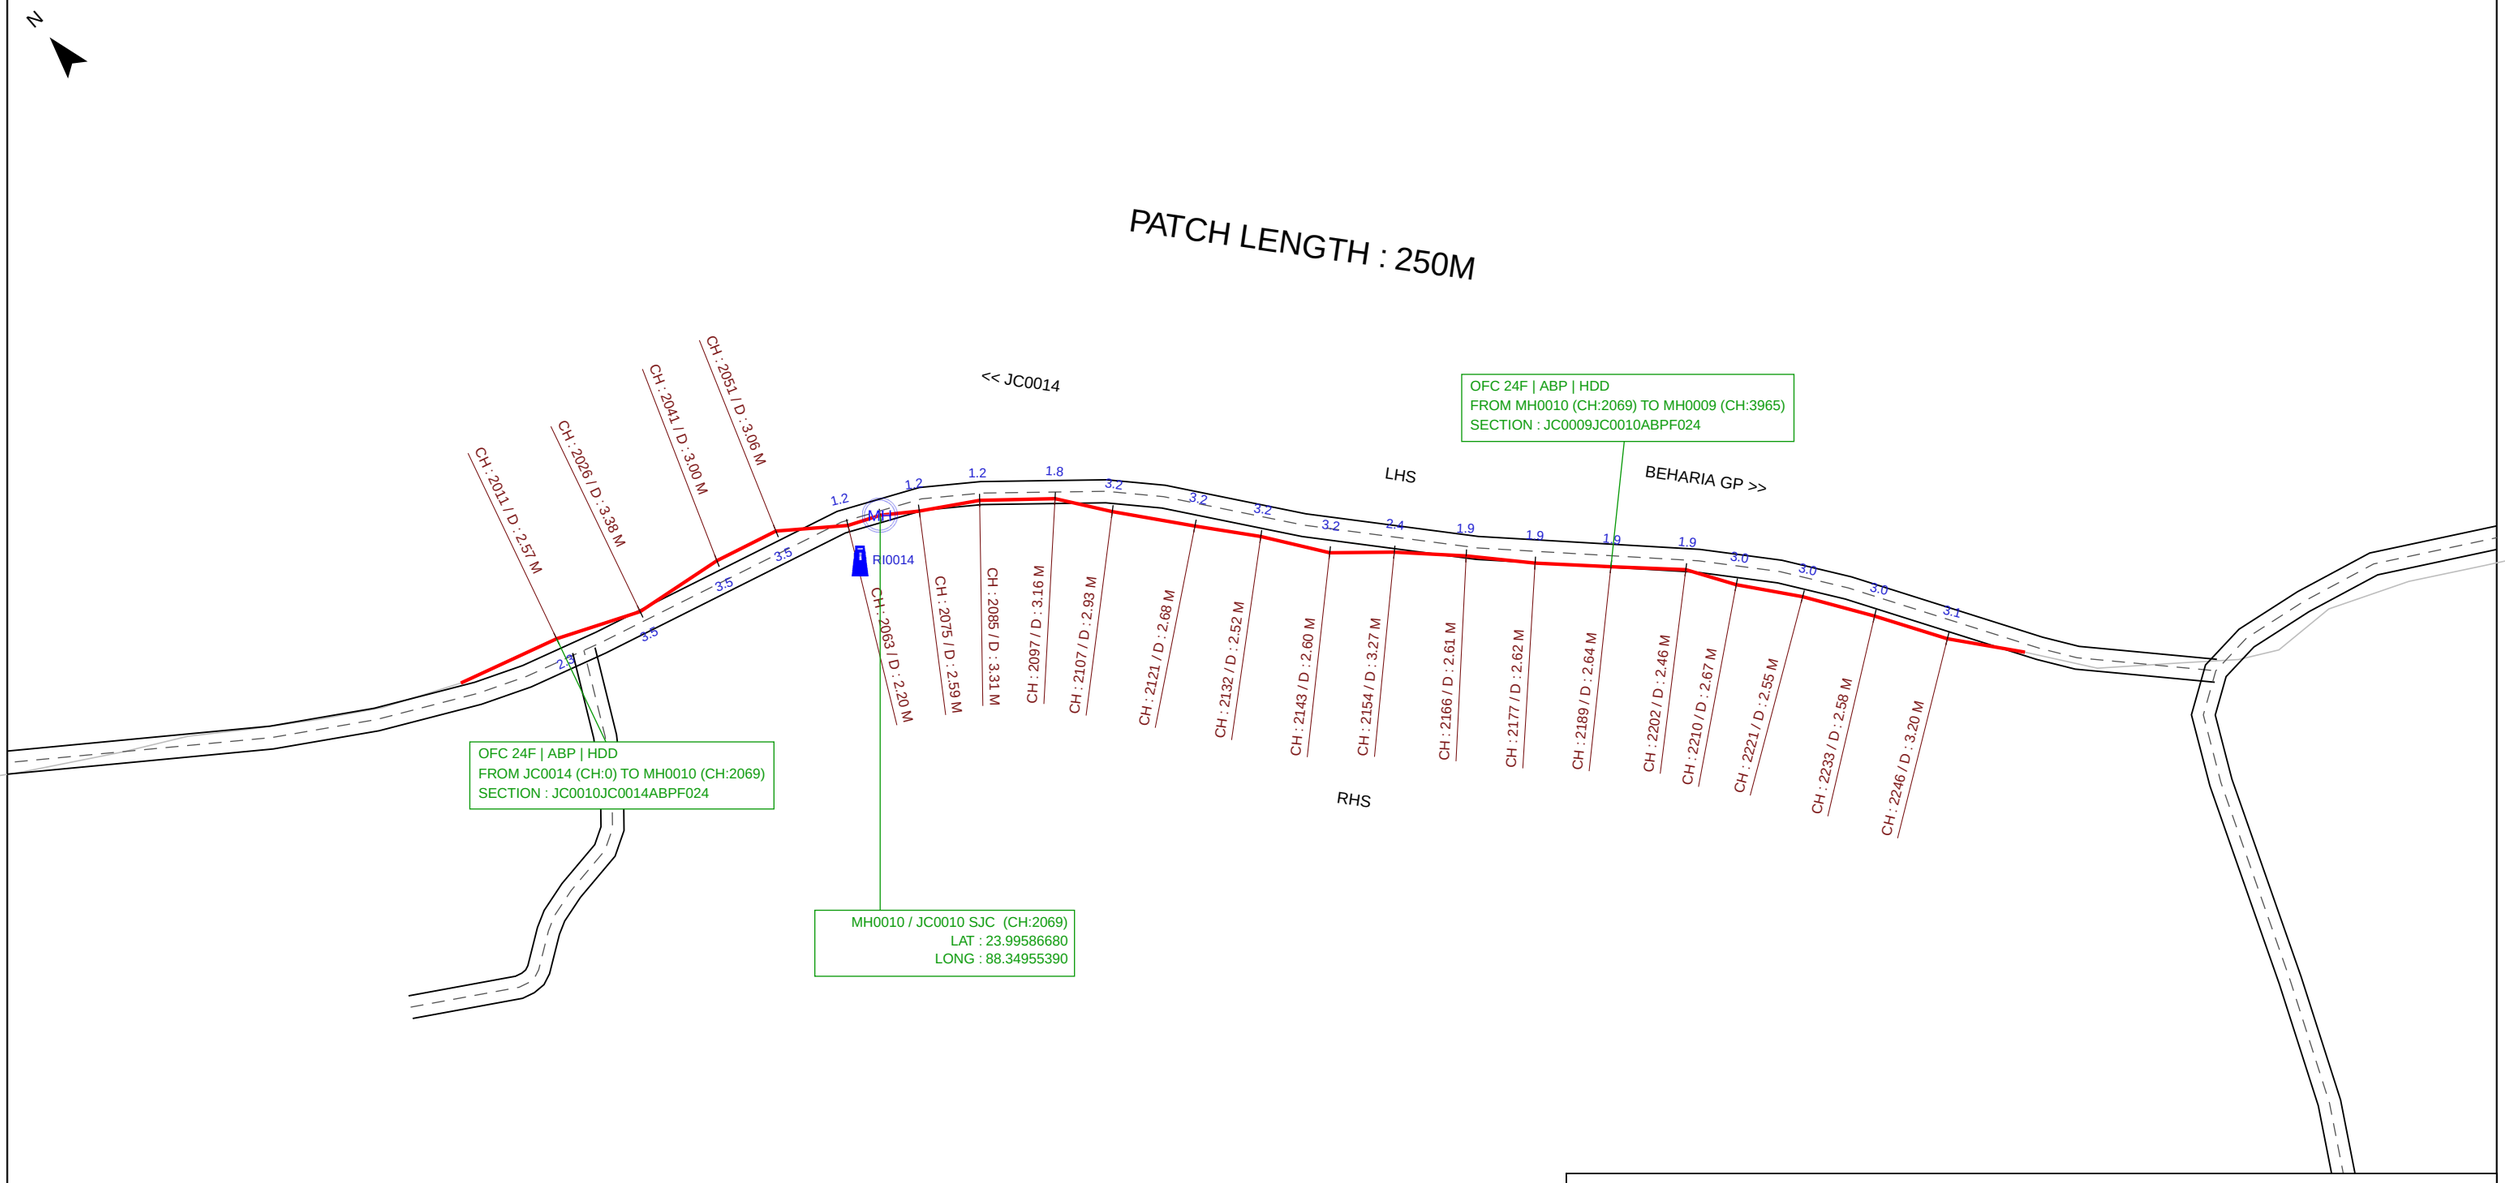

NOTE : ALL MESURMENTS ARE IN METERES (M)

ROAD OFFSET = DISTANCE FROM ROAD CENTRE LINE TO CABLE. ROAD FROM OPENSTREETMAP, CABLE FROM GPS - APPROXIMATE

Amended Bharatnet Program Phase - III


PACKAGE - 9/ WEST BENGAL	PIA - Tera Software
JOB	AS BUILT DRAWING
BLOCK NAME :	
SPAN :	JC0014 TO BEHARIA GP
FROM GP: JC0014 TO GP: BEHARIA GP	

PIA	IE	BSNL

PLANIMETRY SCALE : H/V - 1:1000	SHEET SIZE - A3
FROM CH: 2000 M TO CH: 2250 M	SHEET NO. - 9
Patch Length :- 250 m	DATE:

N

PATCH LENGTH : 250M

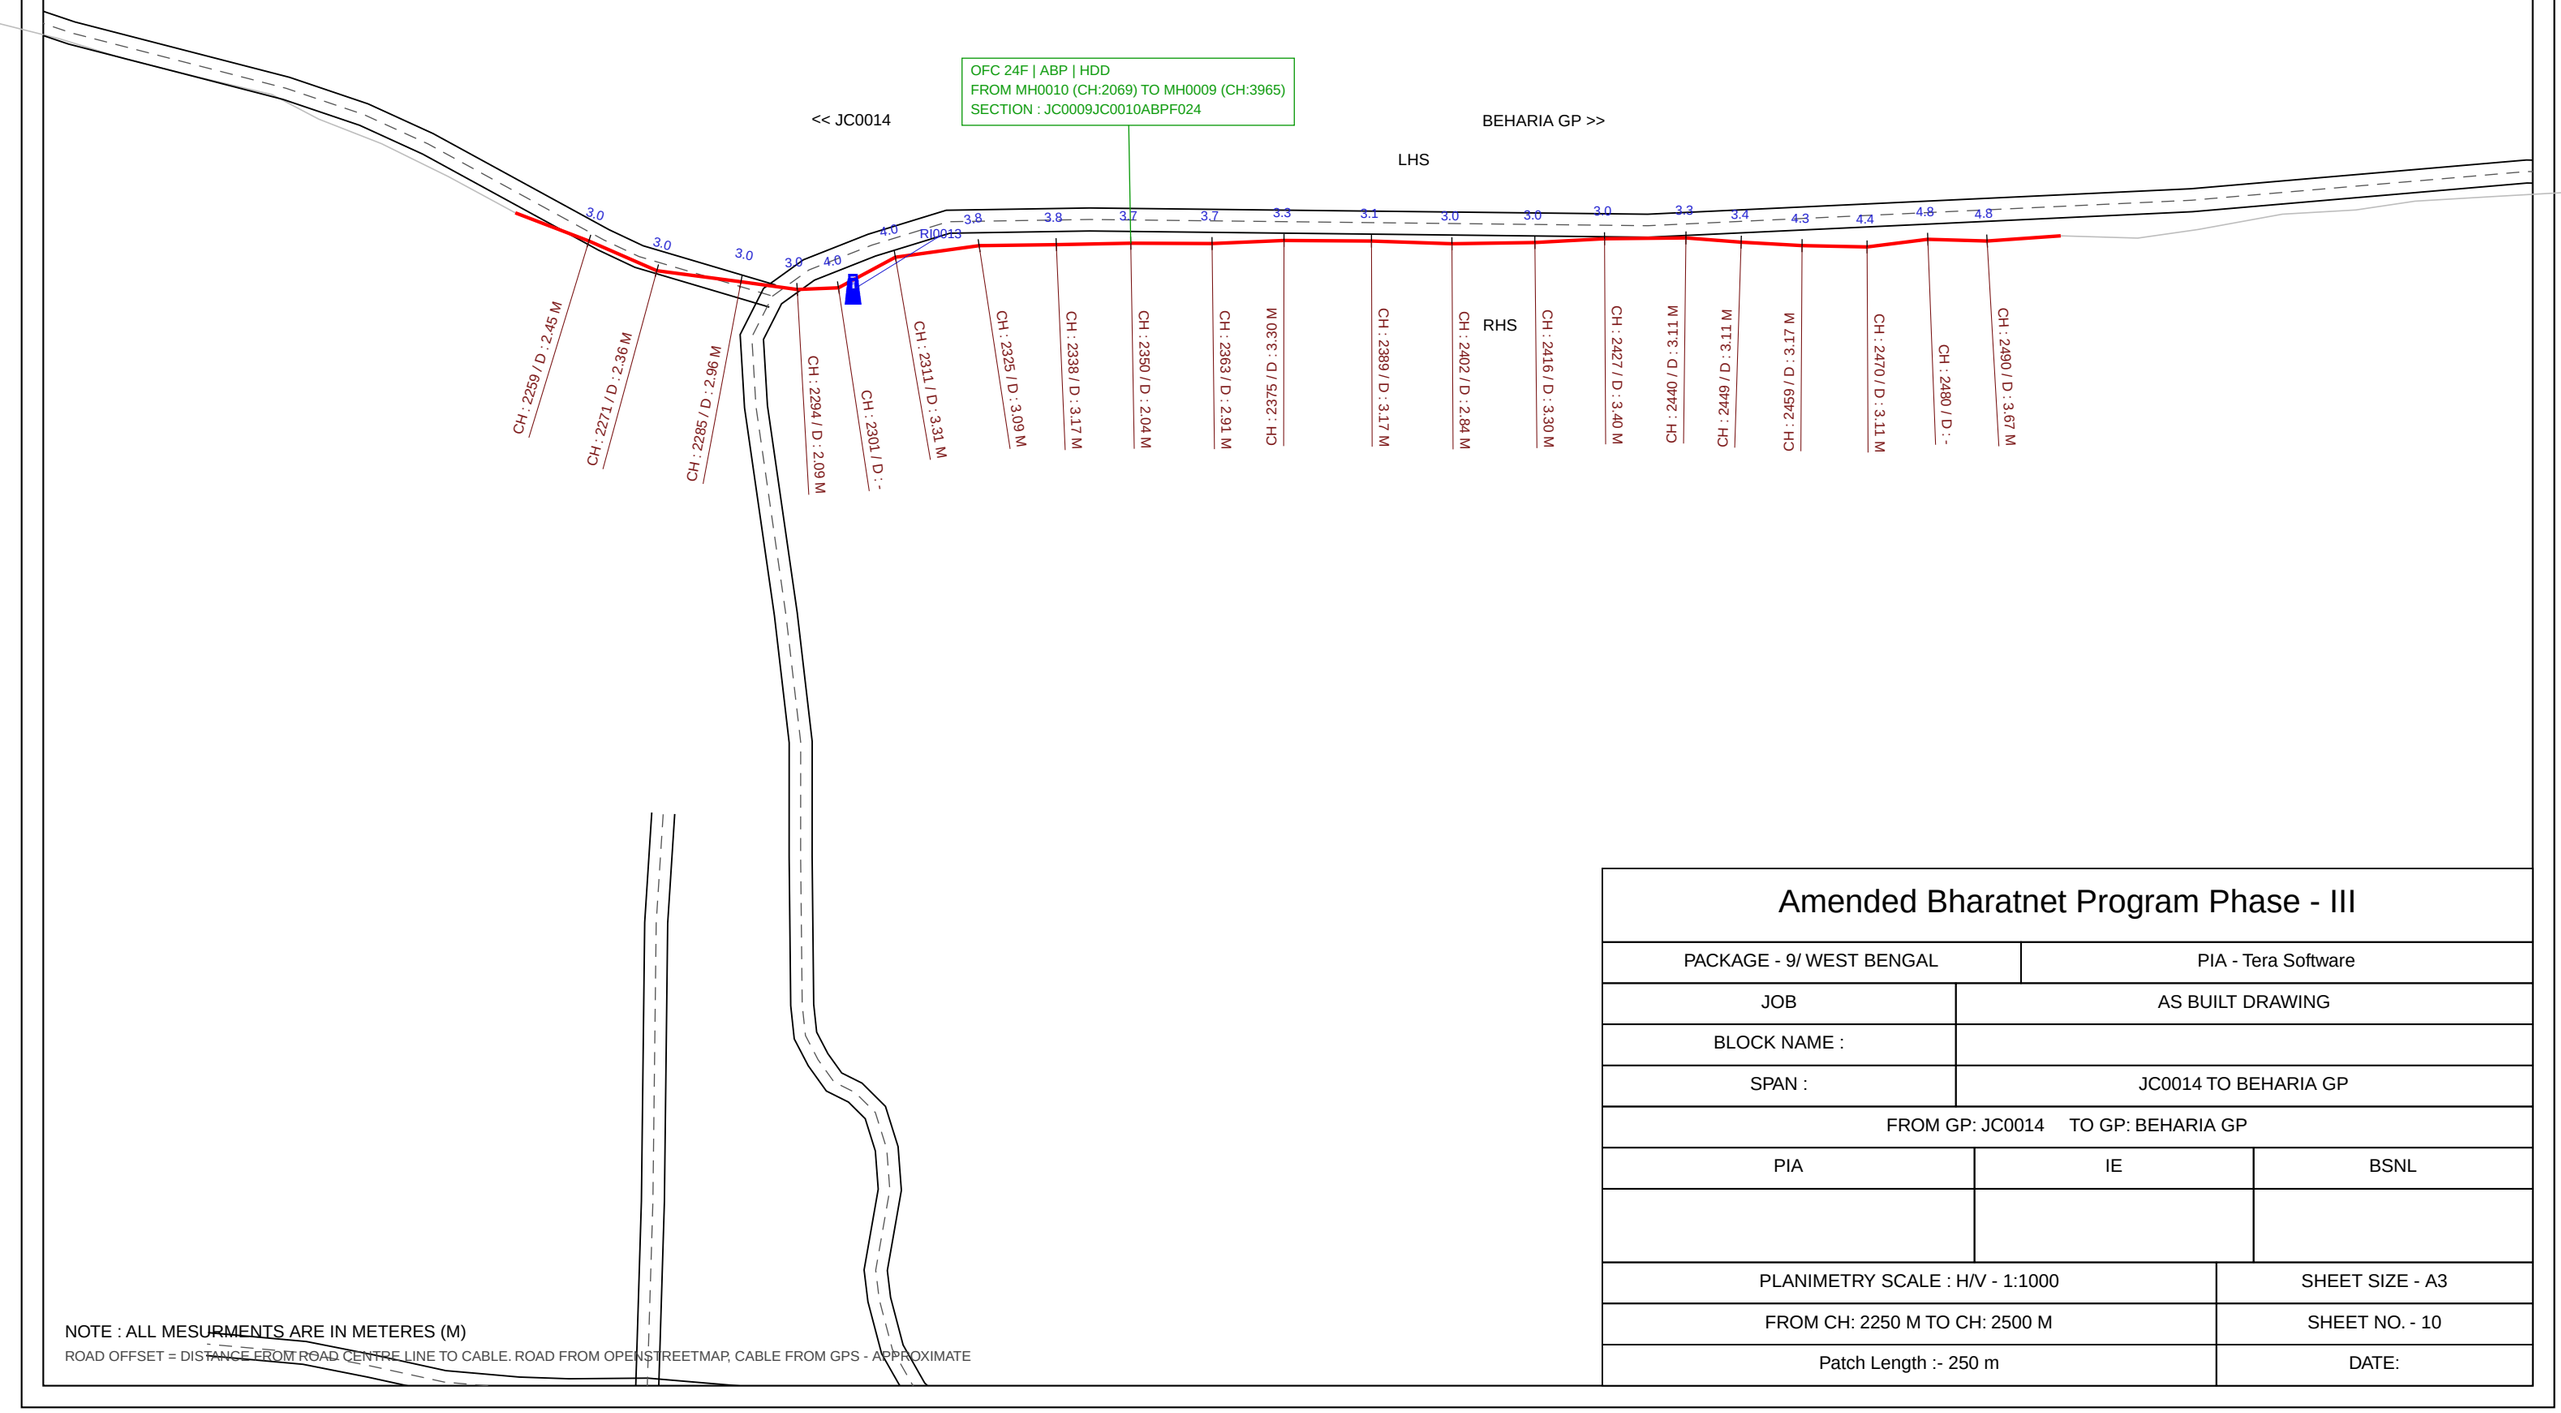


NOTE : ALL MESURMENTS ARE IN METERES (M)

ROAD OFFSET = DISTANCE FROM ROAD CENTRE LINE TO CABLE. ROAD FROM OPENSTREETMAP, CABLE FROM GPS - APPROXIMATE

Amended Bharatnet Program Phase - III

PACKAGE - 9/ WEST BENGAL	PIA - Tera Software	
JOB	AS BUILT DRAWING	
BLOCK NAME :		
SPAN :	JC0014 TO BEHARIA GP	
FROM GP: JC0014 TO GP: BEHARIA GP		
PIA	IE	BSNL
PLANIMETRY SCALE : H/V - 1:1000	SHEET SIZE - A3	
FROM CH: 2250 M TO CH: 2500 M	SHEET NO. - 10	
Patch Length :- 250 m	DATE:	

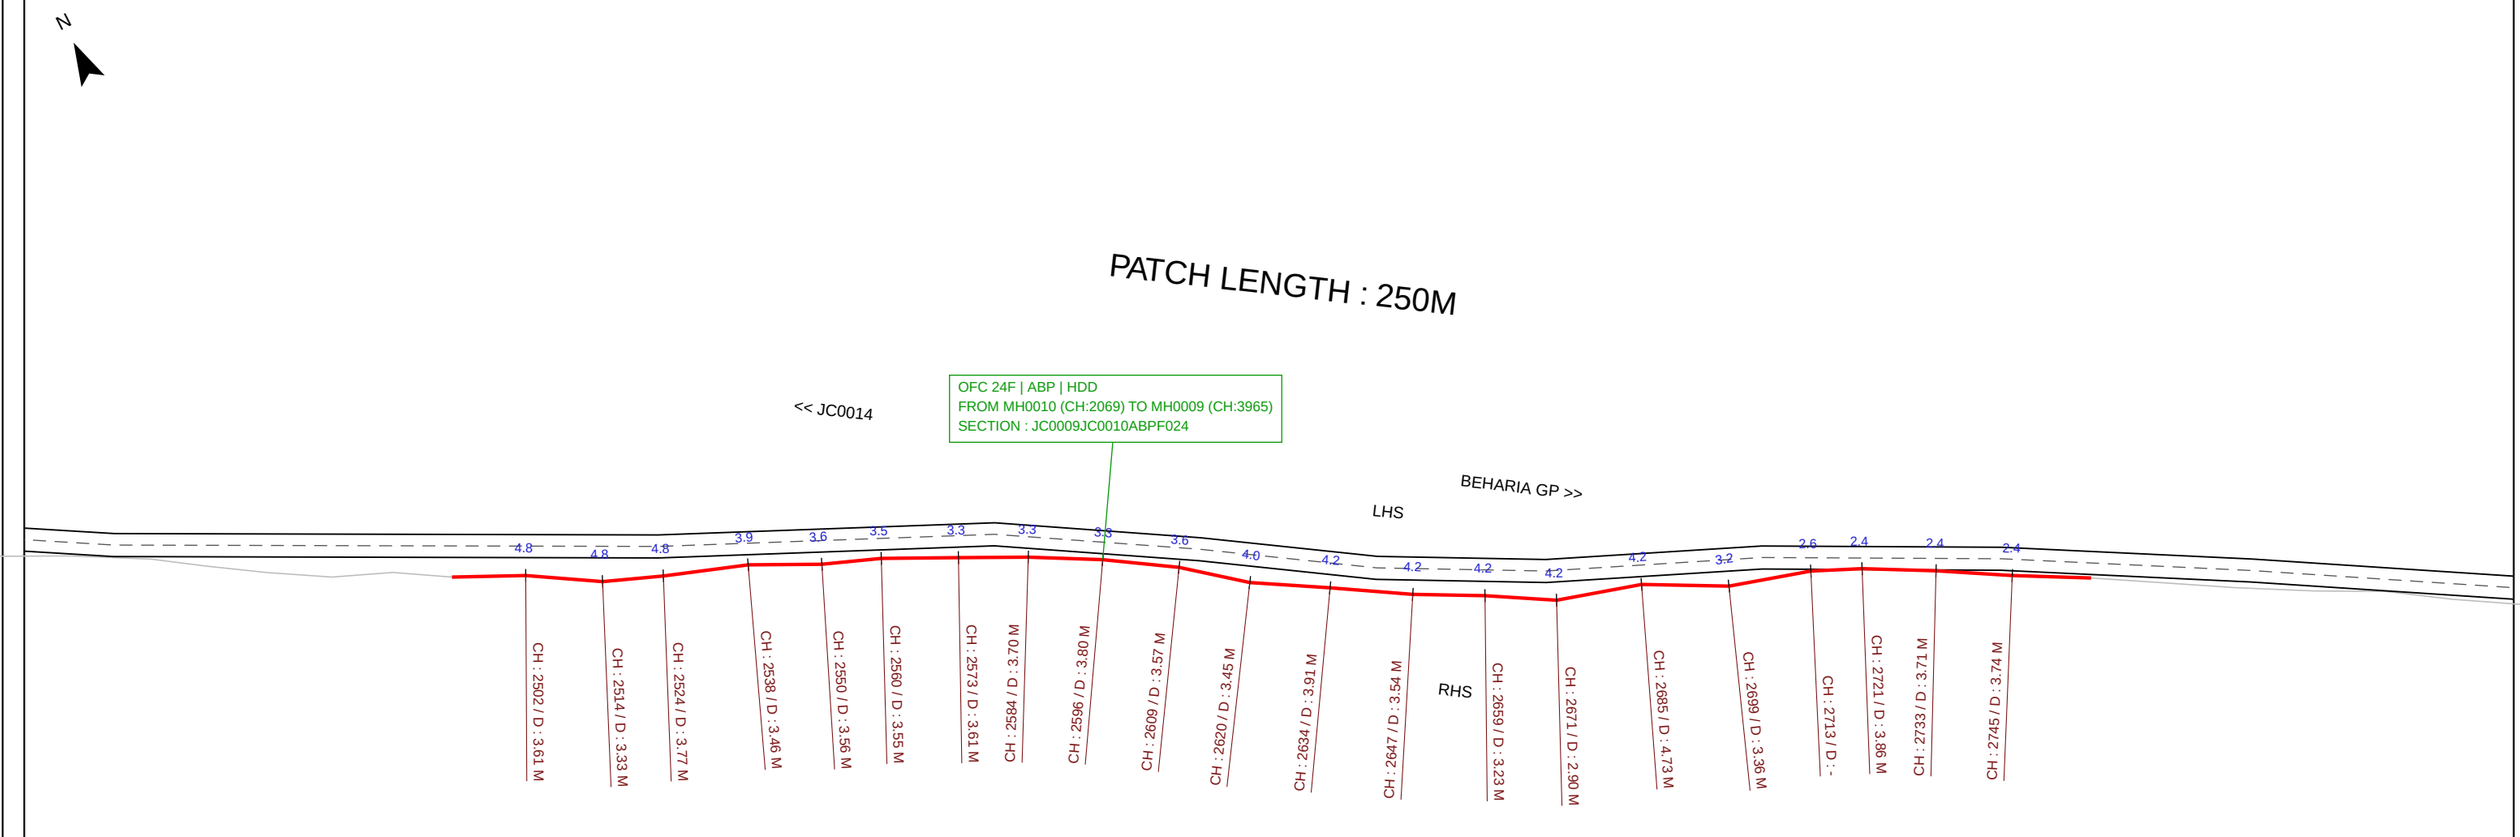

NOTE : ALL MESURMENTS ARE IN METERES (M)

ROAD OFFSET = DISTANCE FROM ROAD CENTRE LINE TO CABLE. ROAD FROM OPENSTREETMAP, CABLE FROM GPS - APPROXIMATE

Amended Bharatnet Program Phase - III


PACKAGE - 9/ WEST BENGAL	PIA - Tera Software
JOB	AS BUILT DRAWING
BLOCK NAME :	
SPAN :	JC0014 TO BEHARIA GP
FROM GP: JC0014 TO GP: BEHARIA GP	

PIA	IE	BSNL

PLANIMETRY SCALE : H/V - 1:1000	SHEET SIZE - A3
FROM CH: 2500 M TO CH: 2750 M	SHEET NO. - 11
Patch Length :- 250 m	DATE:

N

PATCH LENGTH : 250M

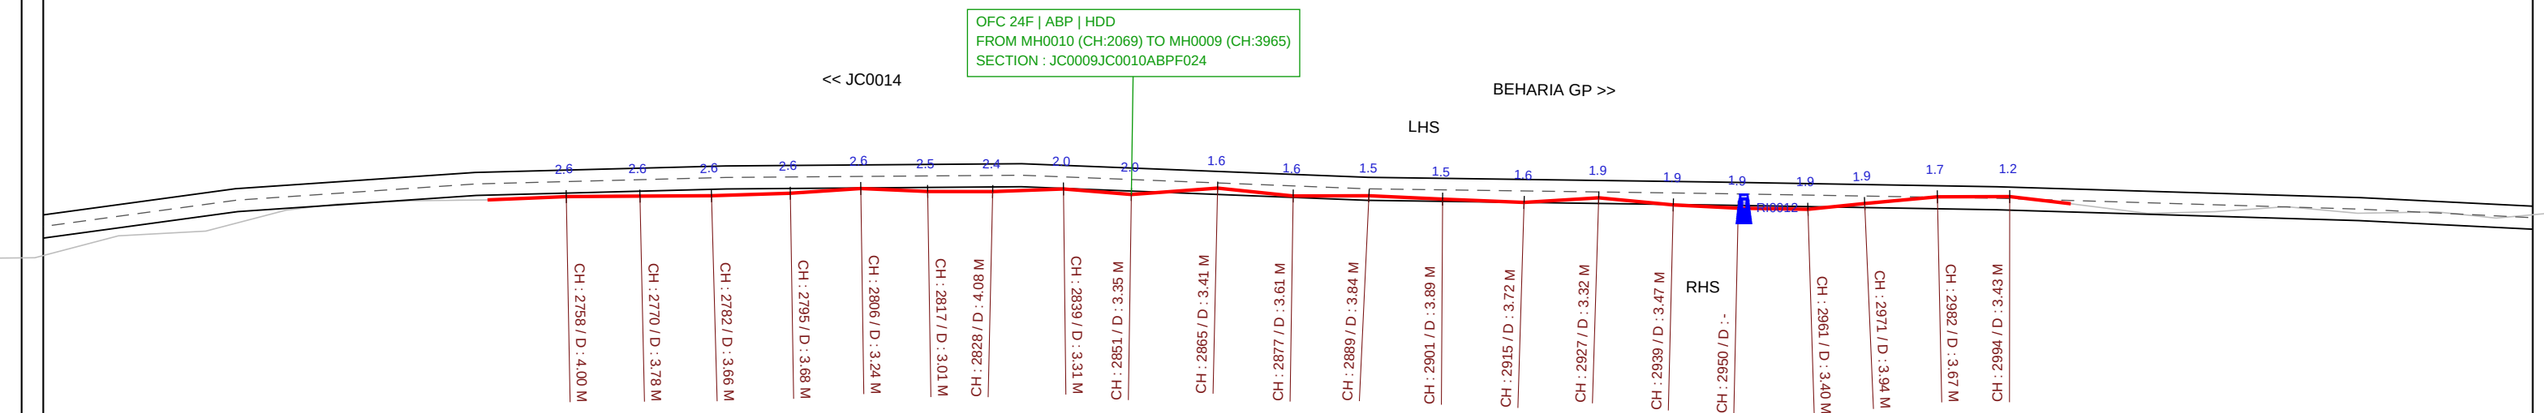

NOTE : ALL MESURMENTS ARE IN METERES (M)


ROAD OFFSET = DISTANCE FROM ROAD CENTRE LINE TO CABLE. ROAD FROM OPENSTREETMAP, CABLE FROM GPS - APPROXIMATE

Amended Bharatnet Program Phase - III

PACKAGE - 9/ WEST BENGAL	PIA - Tera Software
JOB	AS BUILT DRAWING
BLOCK NAME :	
SPAN :	JC0014 TO BEHARIA GP
FROM GP: JC0014 TO GP: BEHARIA GP	

PIA	IE	BSNL

PLANIMETRY SCALE : H/V - 1:1000	SHEET SIZE - A3
FROM CH: 2750 M TO CH: 3000 M	SHEET NO. - 12
Patch Length :- 250 m	DATE:

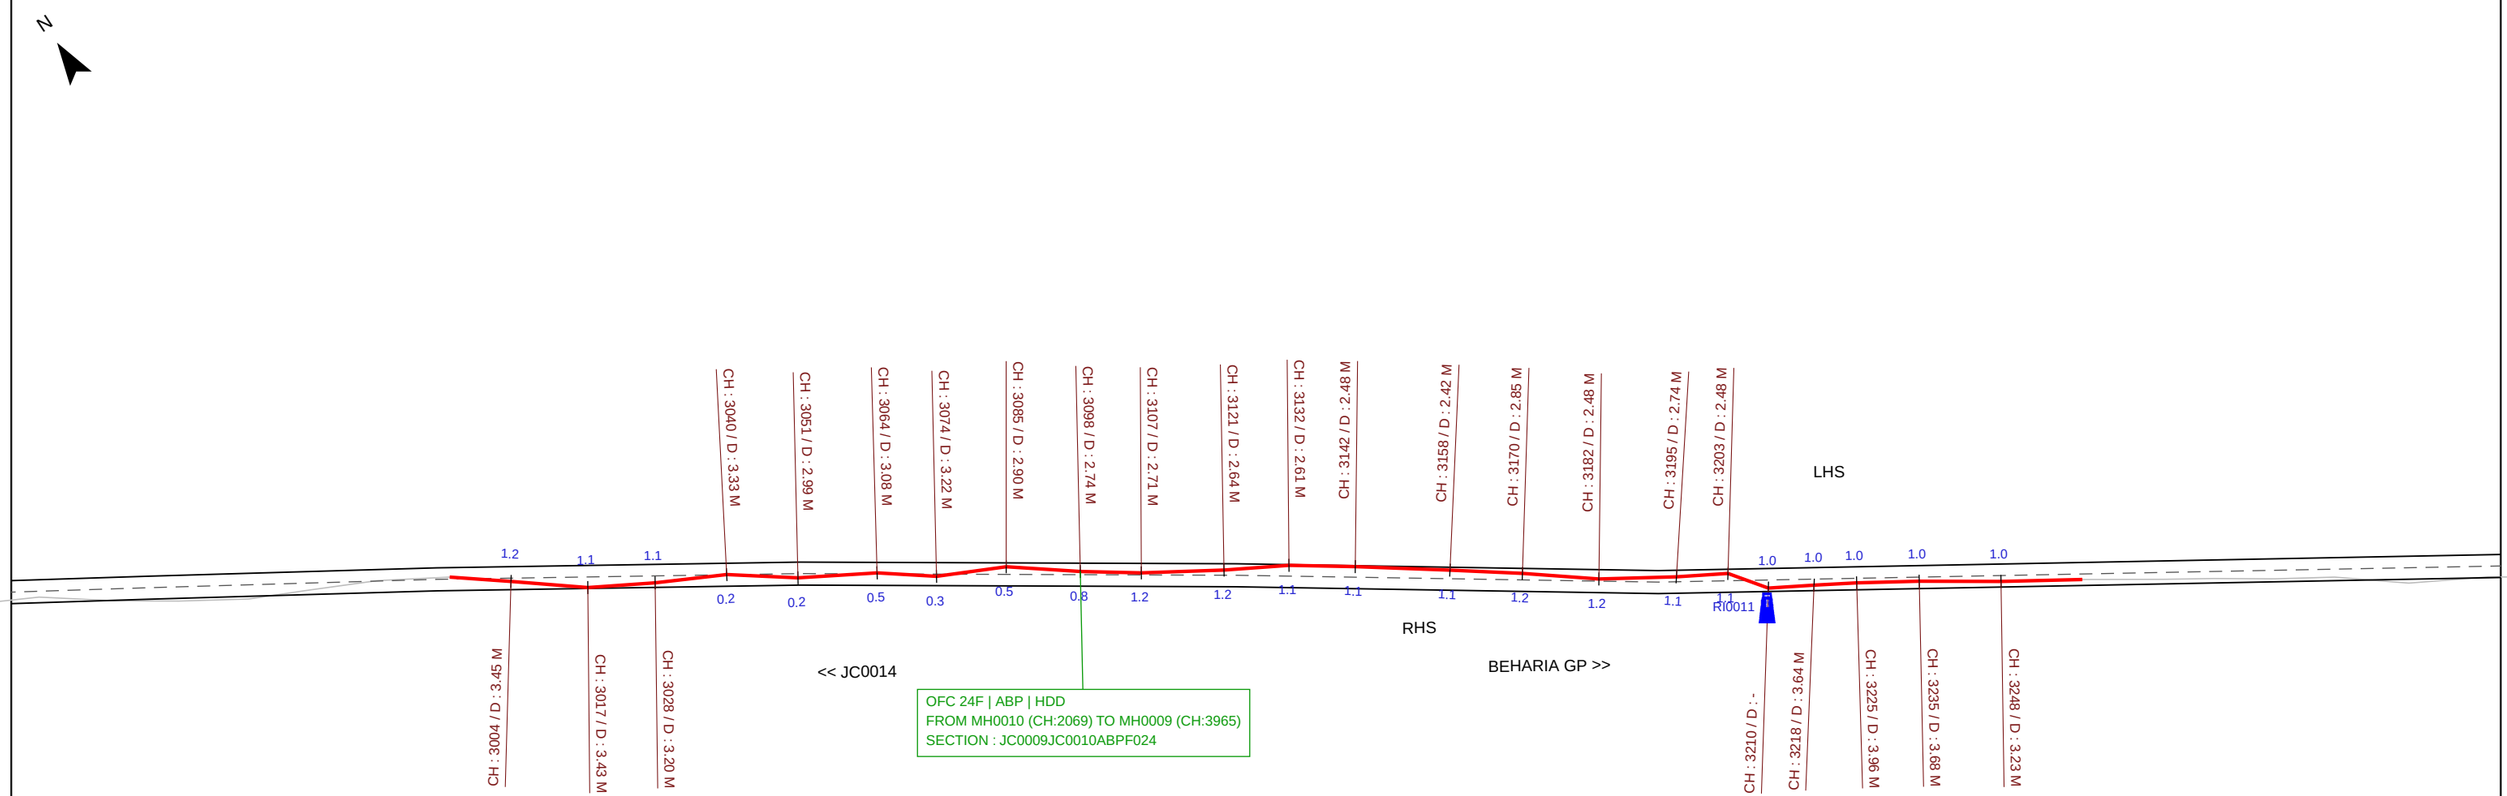

PATCH LENGTH : 250M

NOTE : ALL MESURMENTS ARE IN METERES (M)

ROAD OFFSET = DISTANCE FROM ROAD CENTRE LINE TO CABLE. ROAD FROM OPENSTREETMAP, CABLE FROM GPS - APPROXIMATE

Amended Bharatnet Program Phase - III		
PACKAGE - 9/ WEST BENGAL	PIA - Tera Software	
JOB	AS BUILT DRAWING	
BLOCK NAME :		
SPAN :	JC0014 TO BEHARIA GP	
FROM GP: JC0014 TO GP: BEHARIA GP		
PIA	IE	BSNL
PLANIMETRY SCALE : H/V - 1:1000	SHEET SIZE - A3	
FROM CH: 3000 M TO CH: 3250 M	SHEET NO. - 13	
Patch Length :- 250 m	DATE:	

N

PATCH LENGTH : 250M


OFC 24F | ABP | HDD
FROM MH0010 (CH:2069) TO MH0009 (CH:3965)
SECTION : JC0009JC0010ABPF024

<< JC0014

BEHARIA GP >>

LHS

RHS

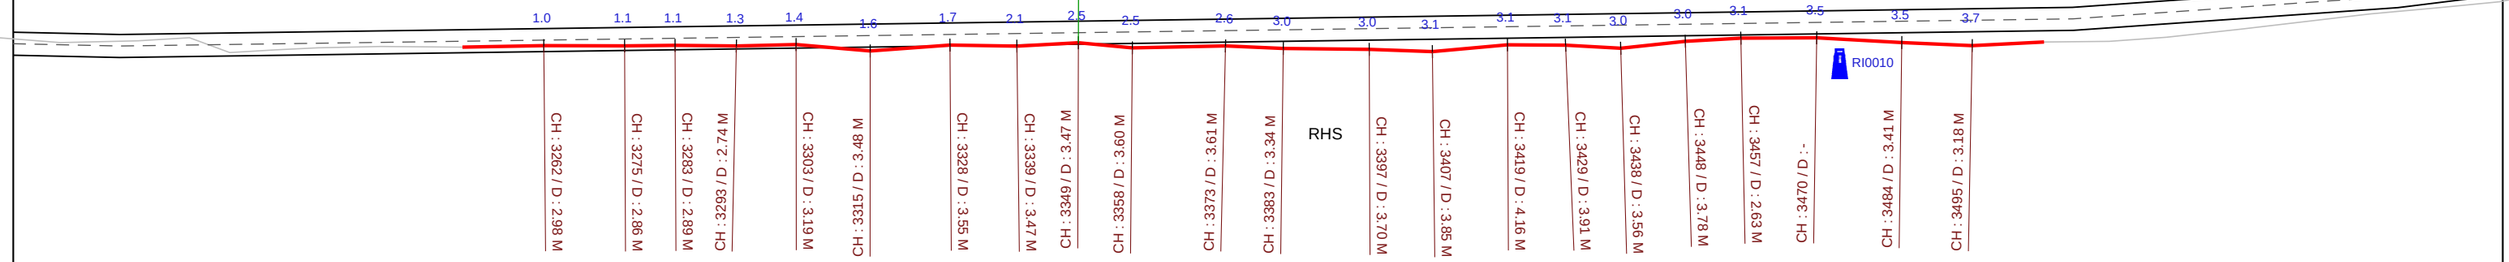

NOTE : ALL MESURMENTS ARE IN METERES (M)

ROAD OFFSET = DISTANCE FROM ROAD CENTRE LINE TO CABLE. ROAD FROM OPENSTREETMAP, CABLE FROM GPS - APPROXIMATE

Amended Bharatnet Program Phase - III


PACKAGE - 9/ WEST BENGAL	PIA - Tera Software
JOB	AS BUILT DRAWING
BLOCK NAME :	
SPAN :	JC0014 TO BEHARIA GP
FROM GP: JC0014 TO GP: BEHARIA GP	

PIA	IE	BSNL

PLANIMETRY SCALE : H/V - 1:1000	SHEET SIZE - A3
FROM CH: 3250 M TO CH: 3500 M	SHEET NO. - 14
Patch Length :- 250 m	DATE:

N

PATCH LENGTH : 250M

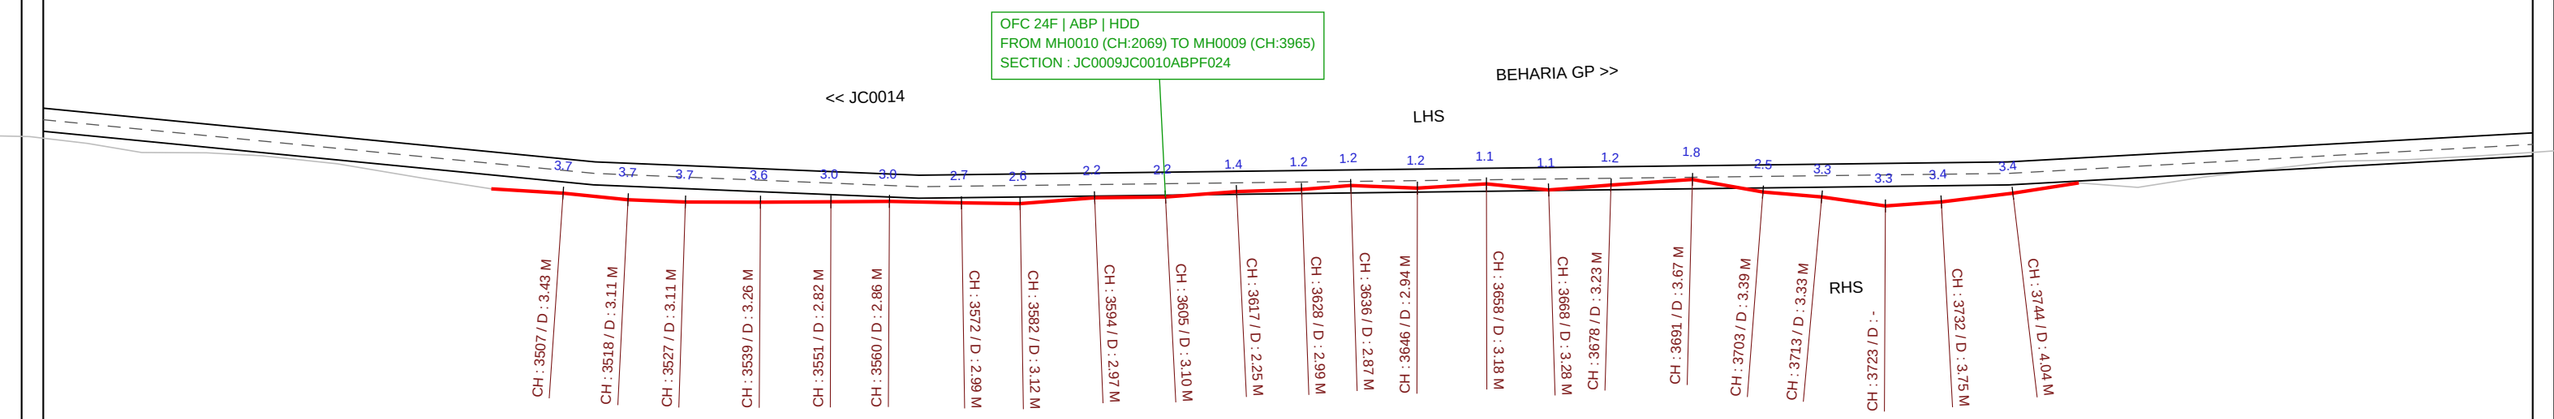

NOTE : ALL MESURMENTS ARE IN METERES (M)


ROAD OFFSET = DISTANCE FROM ROAD CENTRE LINE TO CABLE. ROAD FROM OPENSTREETMAP, CABLE FROM GPS - APPROXIMATE

Amended Bharatnet Program Phase - III

PACKAGE - 9/ WEST BENGAL	PIA - Tera Software
JOB	AS BUILT DRAWING
BLOCK NAME :	
SPAN :	JC0014 TO BEHARIA GP
FROM GP: JC0014 TO GP: BEHARIA GP	

PIA	IE	BSNL

PLANIMETRY SCALE : H/V - 1:1000	SHEET SIZE - A3
FROM CH: 3500 M TO CH: 3750 M	SHEET NO. - 15
Patch Length :- 250 m	DATE:

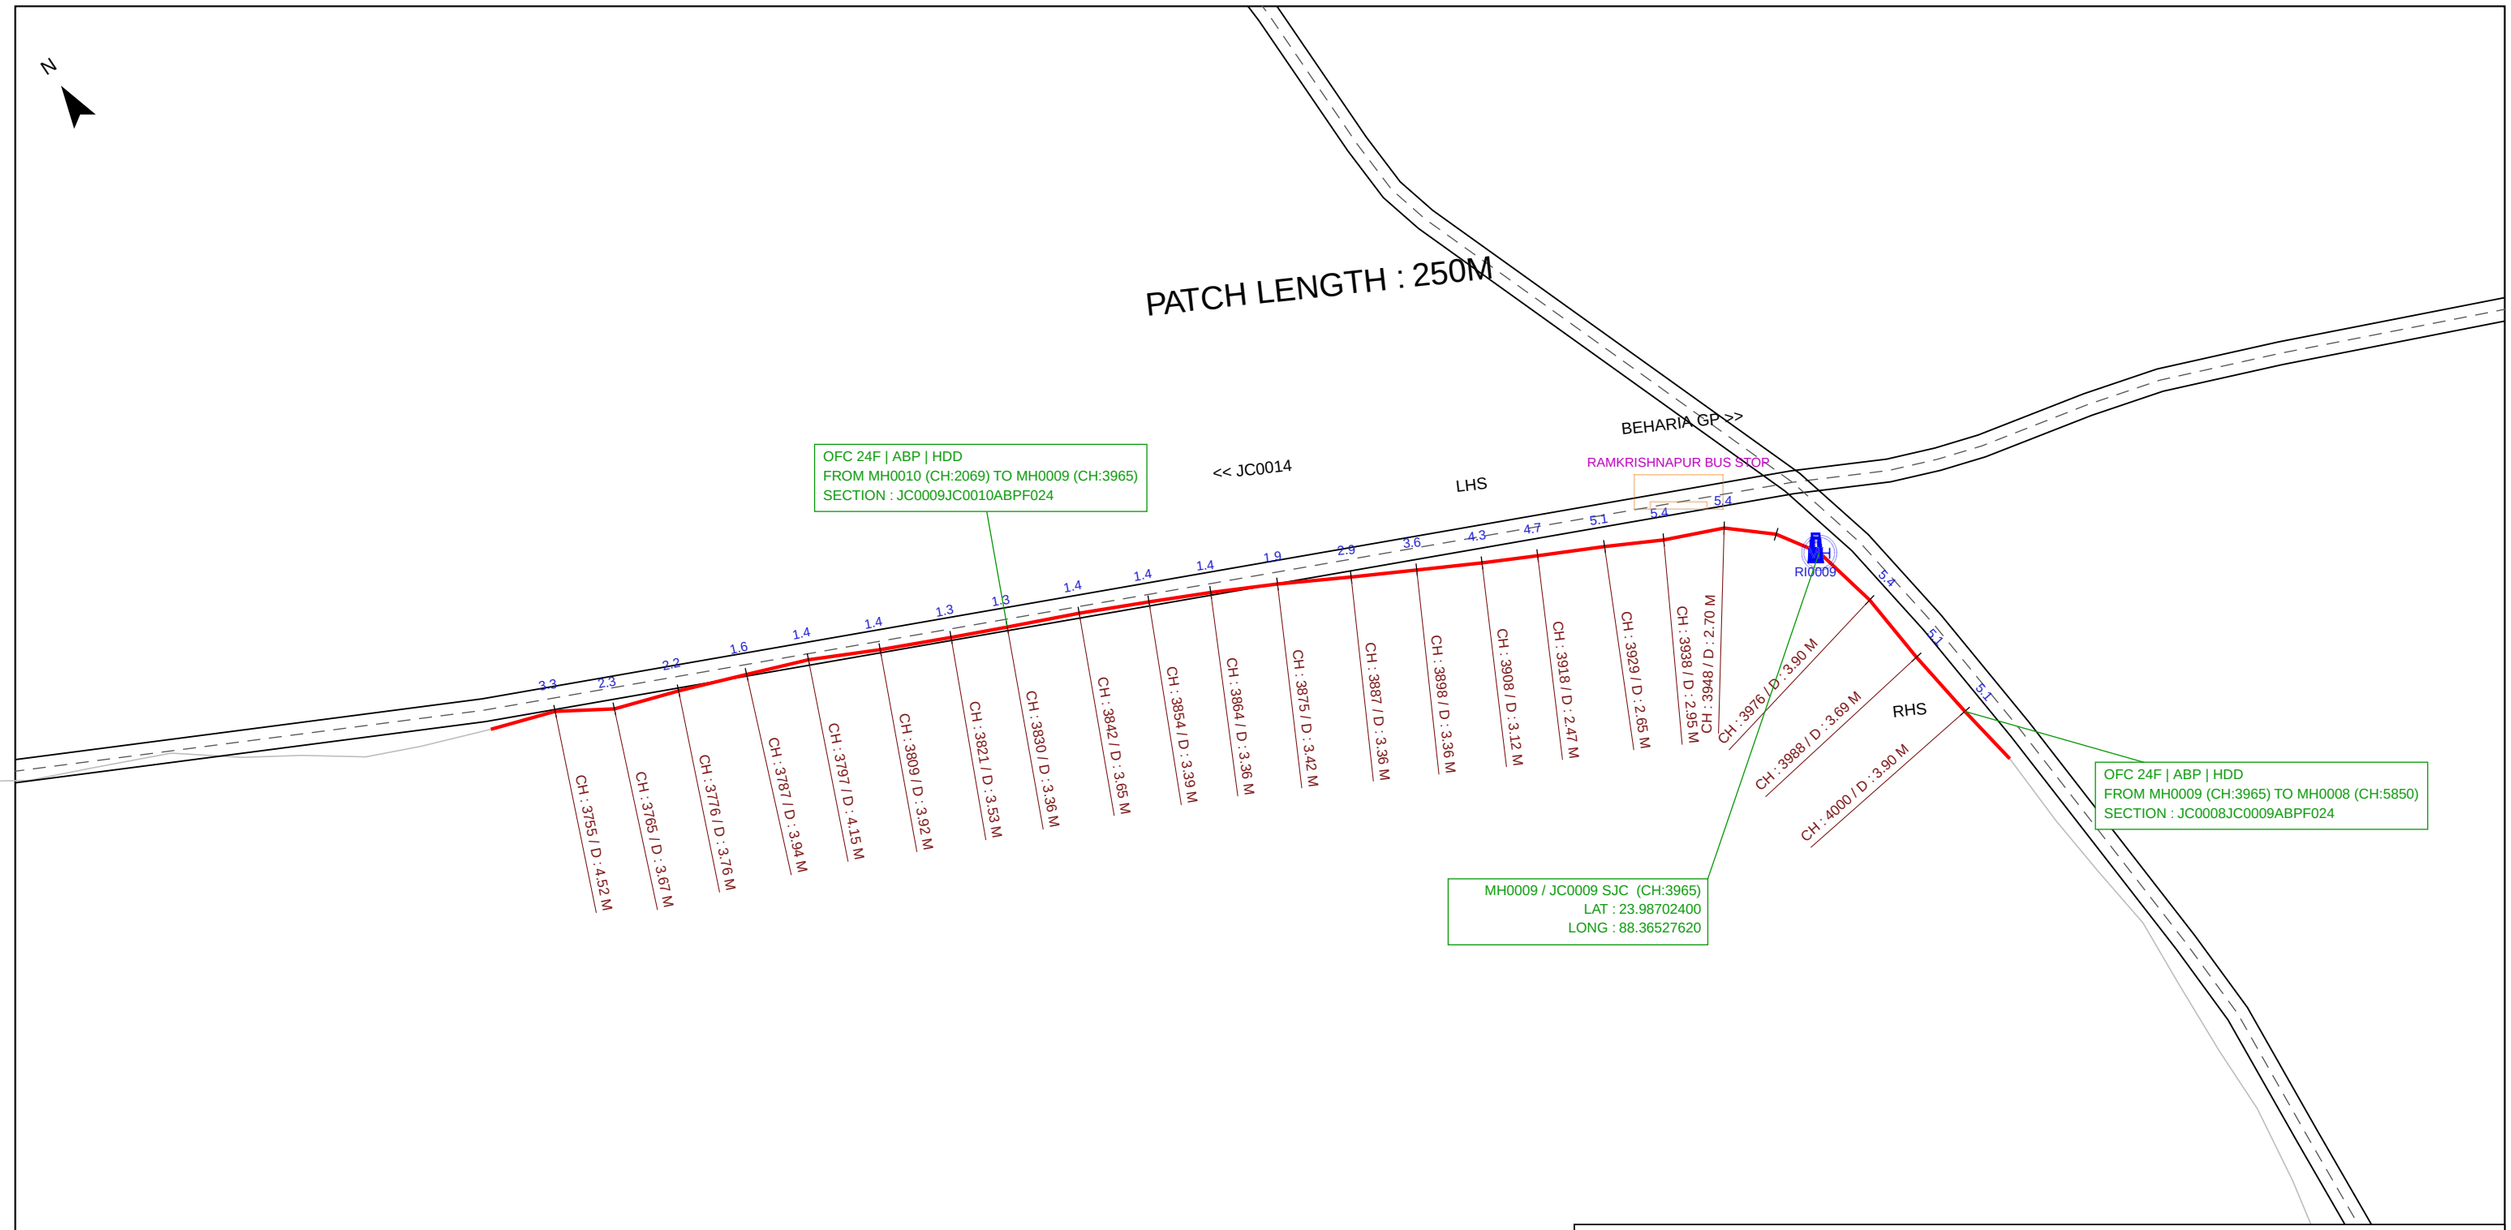


NOTE : ALL MESURMENTS ARE IN METERES (M)

ROAD OFFSET = DISTANCE FROM ROAD CENTRE LINE TO CABLE. ROAD FROM OPENSTREETMAP, CABLE FROM GPS - APPROXIMATE

Amended Bharatnet Program Phase - III

PACKAGE - 9/ WEST BENGAL	PIA - Tera Software	
JOB	AS BUILT DRAWING	
BLOCK NAME :		
SPAN :	JC0014 TO BEHARIA GP	
FROM GP: JC0014 TO GP: BEHARIA GP		
PIA	IE	BSNL
PLANIMETRY SCALE : H/V - 1:1000	SHEET SIZE - A3	
FROM CH: 3750 M TO CH: 4000 M	SHEET NO. - 16	
Patch Length :- 250 m	DATE:	

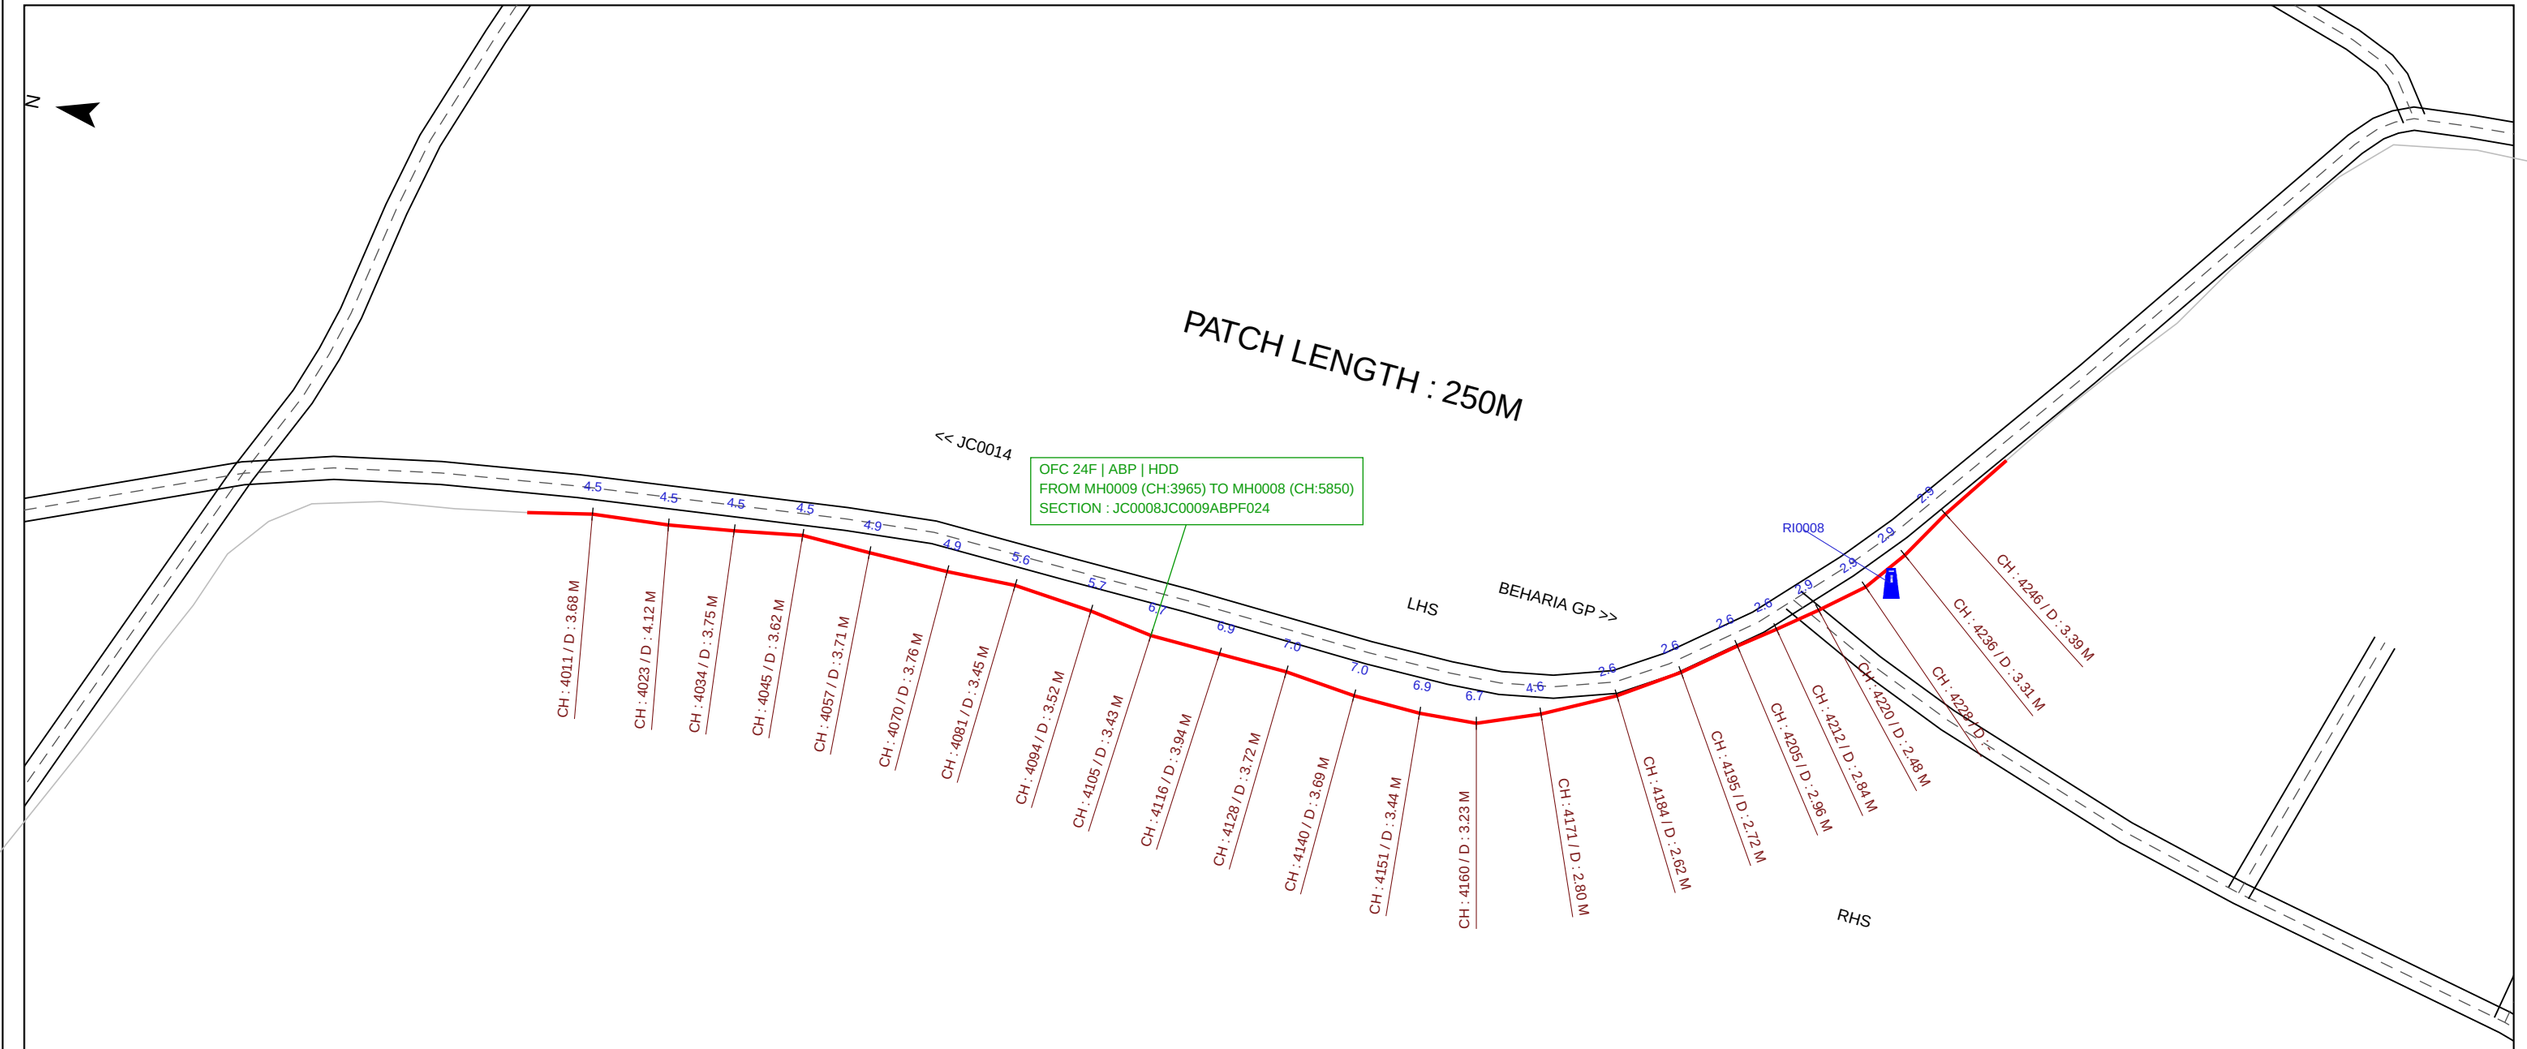

NOTE : ALL MESURMENTS ARE IN METERES (M)


ROAD OFFSET = DISTANCE FROM ROAD CENTRE LINE TO CABLE. ROAD FROM OPENSTREETMAP, CABLE FROM GPS - APPROXIMATE

Amended Bharatnet Program Phase - III

PACKAGE - 9/ WEST BENGAL	PIA - Tera Software
JOB	AS BUILT DRAWING
BLOCK NAME :	
SPAN :	JC0014 TO BEHARIA GP
FROM GP: JC0014 TO GP: BEHARIA GP	

PIA	IE	BSNL

PLANIMETRY SCALE : H/V - 1:1000	SHEET SIZE - A3
FROM CH: 4000 M TO CH: 4250 M	SHEET NO. - 17
Patch Length :- 250 m	DATE:

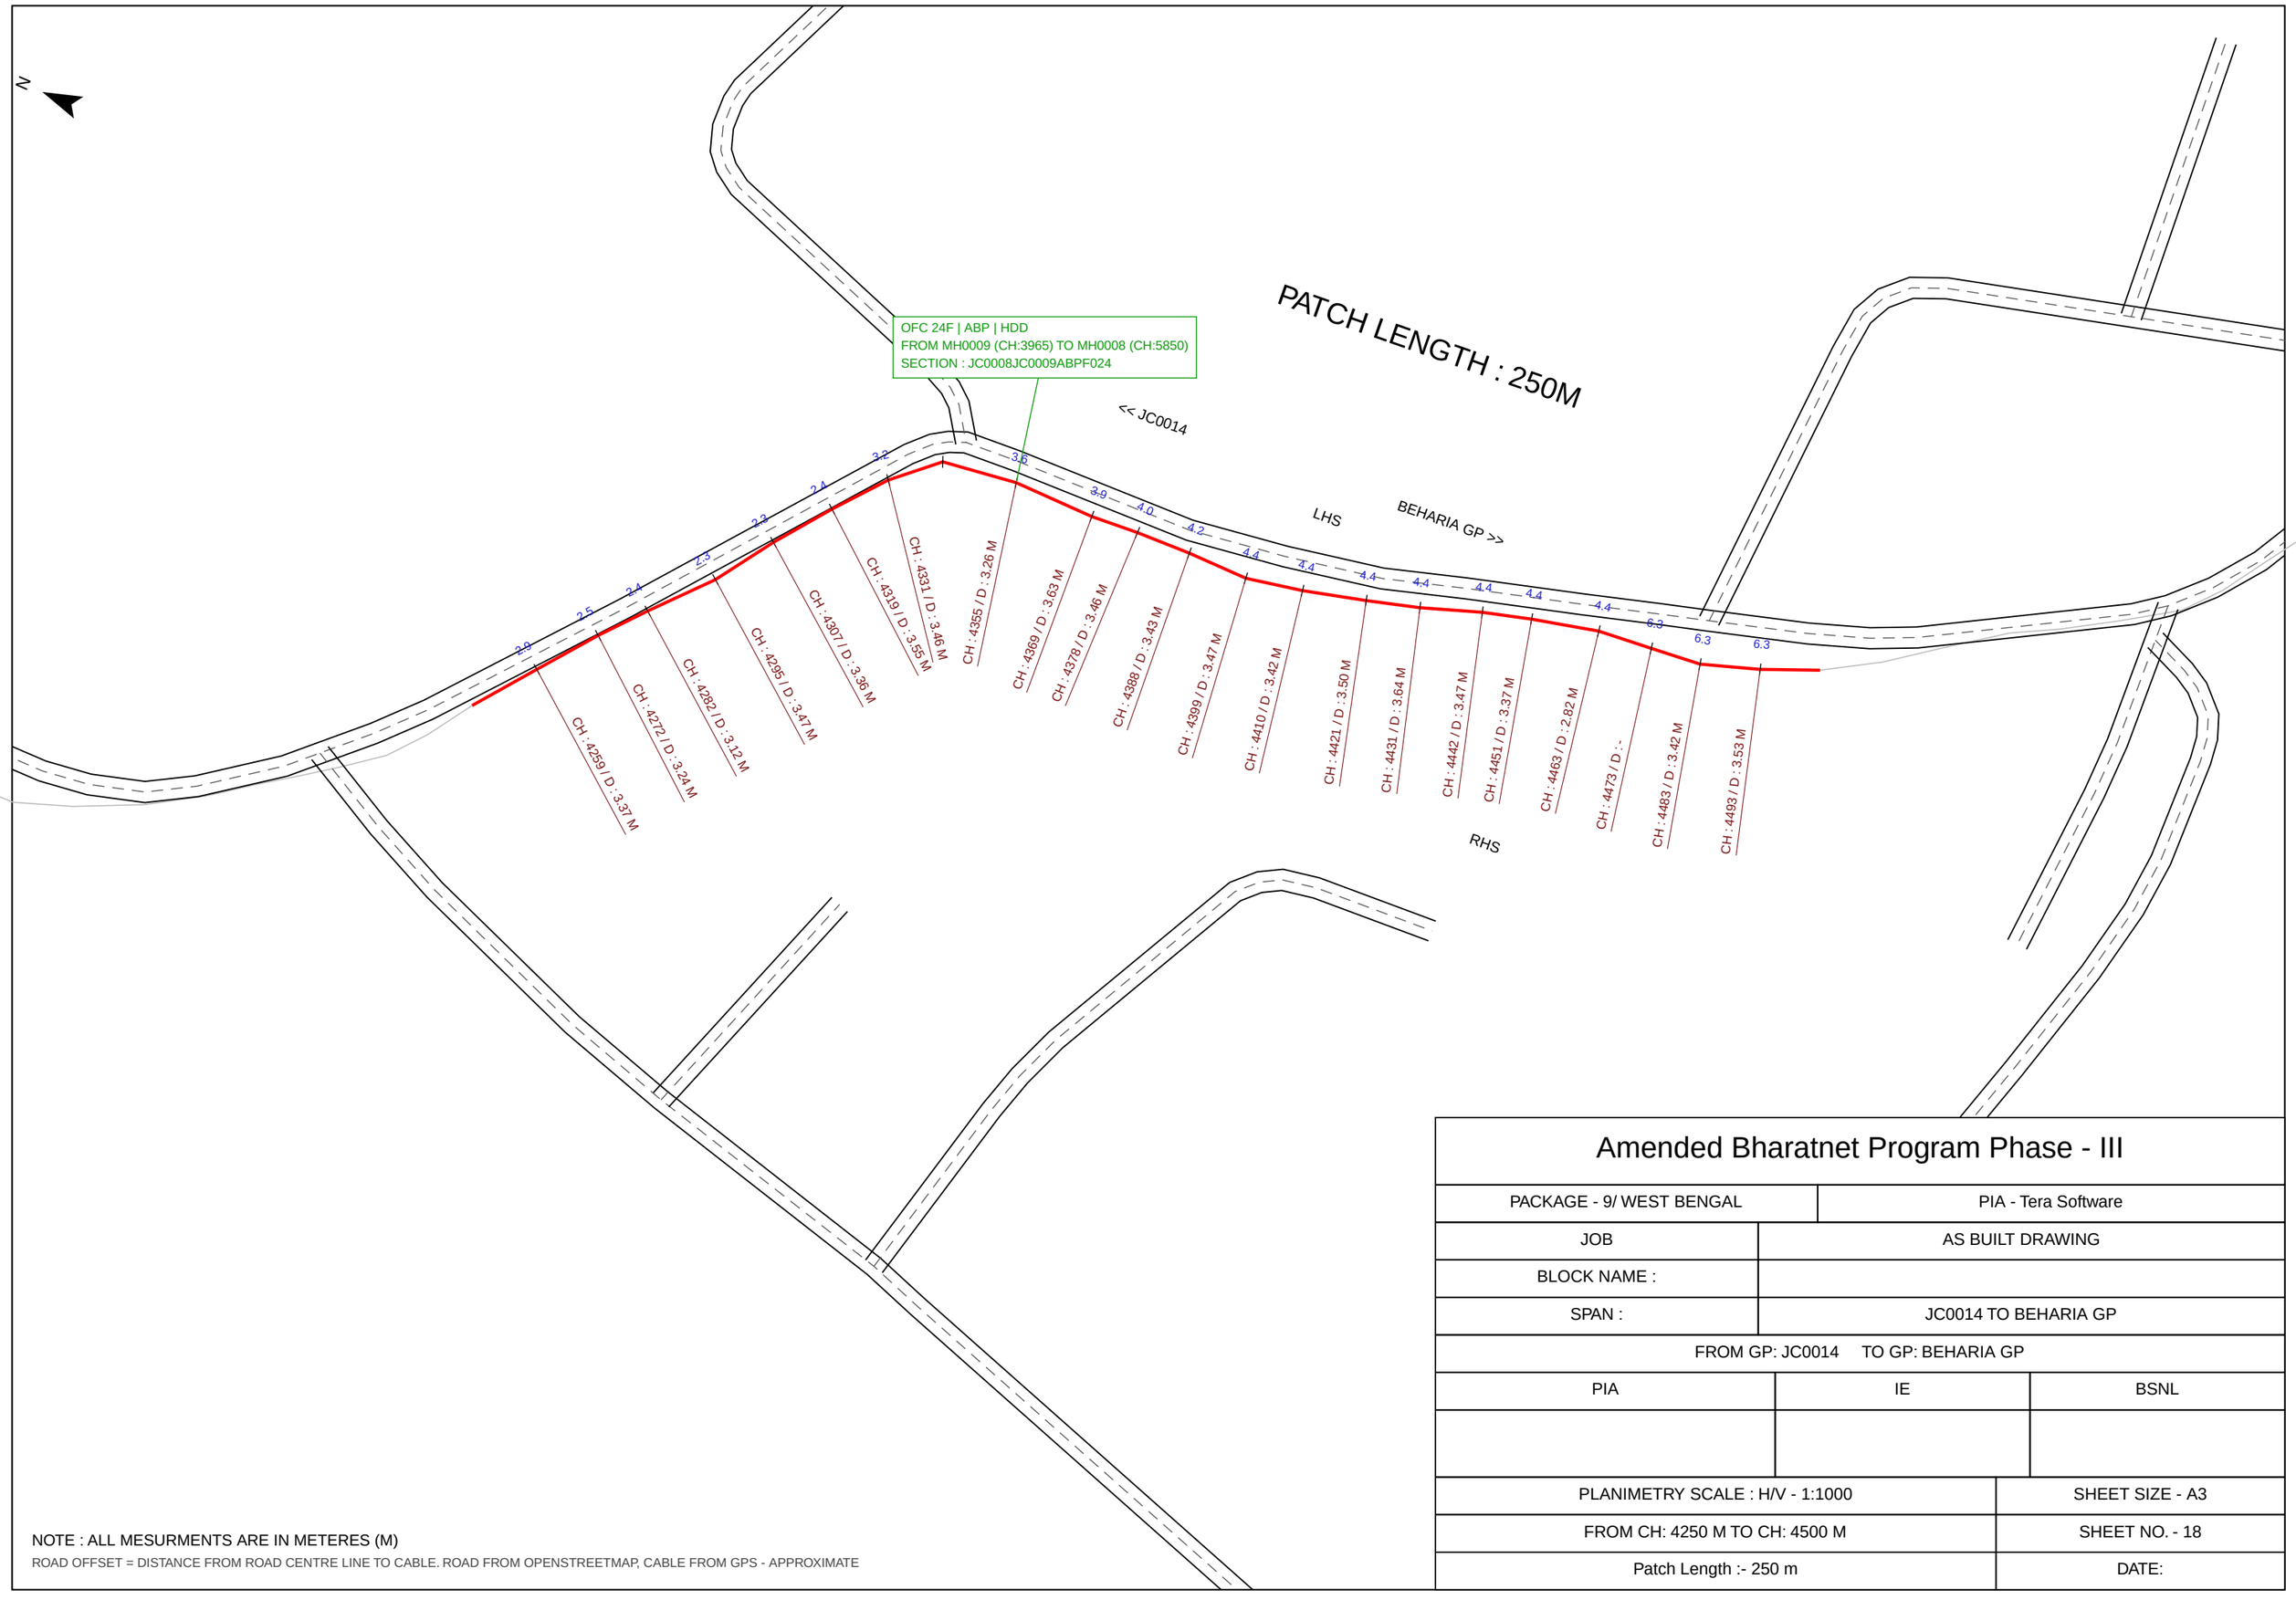

NOTE : ALL MESURMENTS ARE IN METERES (M)


ROAD OFFSET = DISTANCE FROM ROAD CENTRE LINE TO CABLE. ROAD FROM OPENSTREETMAP, CABLE FROM GPS - APPROXIMATE

Amended Bharatnet Program Phase - III

PACKAGE - 9/ WEST BENGAL	PIA - Tera Software
JOB	AS BUILT DRAWING
BLOCK NAME :	
SPAN :	JC0014 TO BEHARIA GP
FROM GP: JC0014 TO GP: BEHARIA GP	

PIA	IE	BSNL

PLANIMETRY SCALE : H/V - 1:1000	SHEET SIZE - A3
FROM CH: 4250 M TO CH: 4500 M	SHEET NO. - 18
Patch Length :- 250 m	DATE:

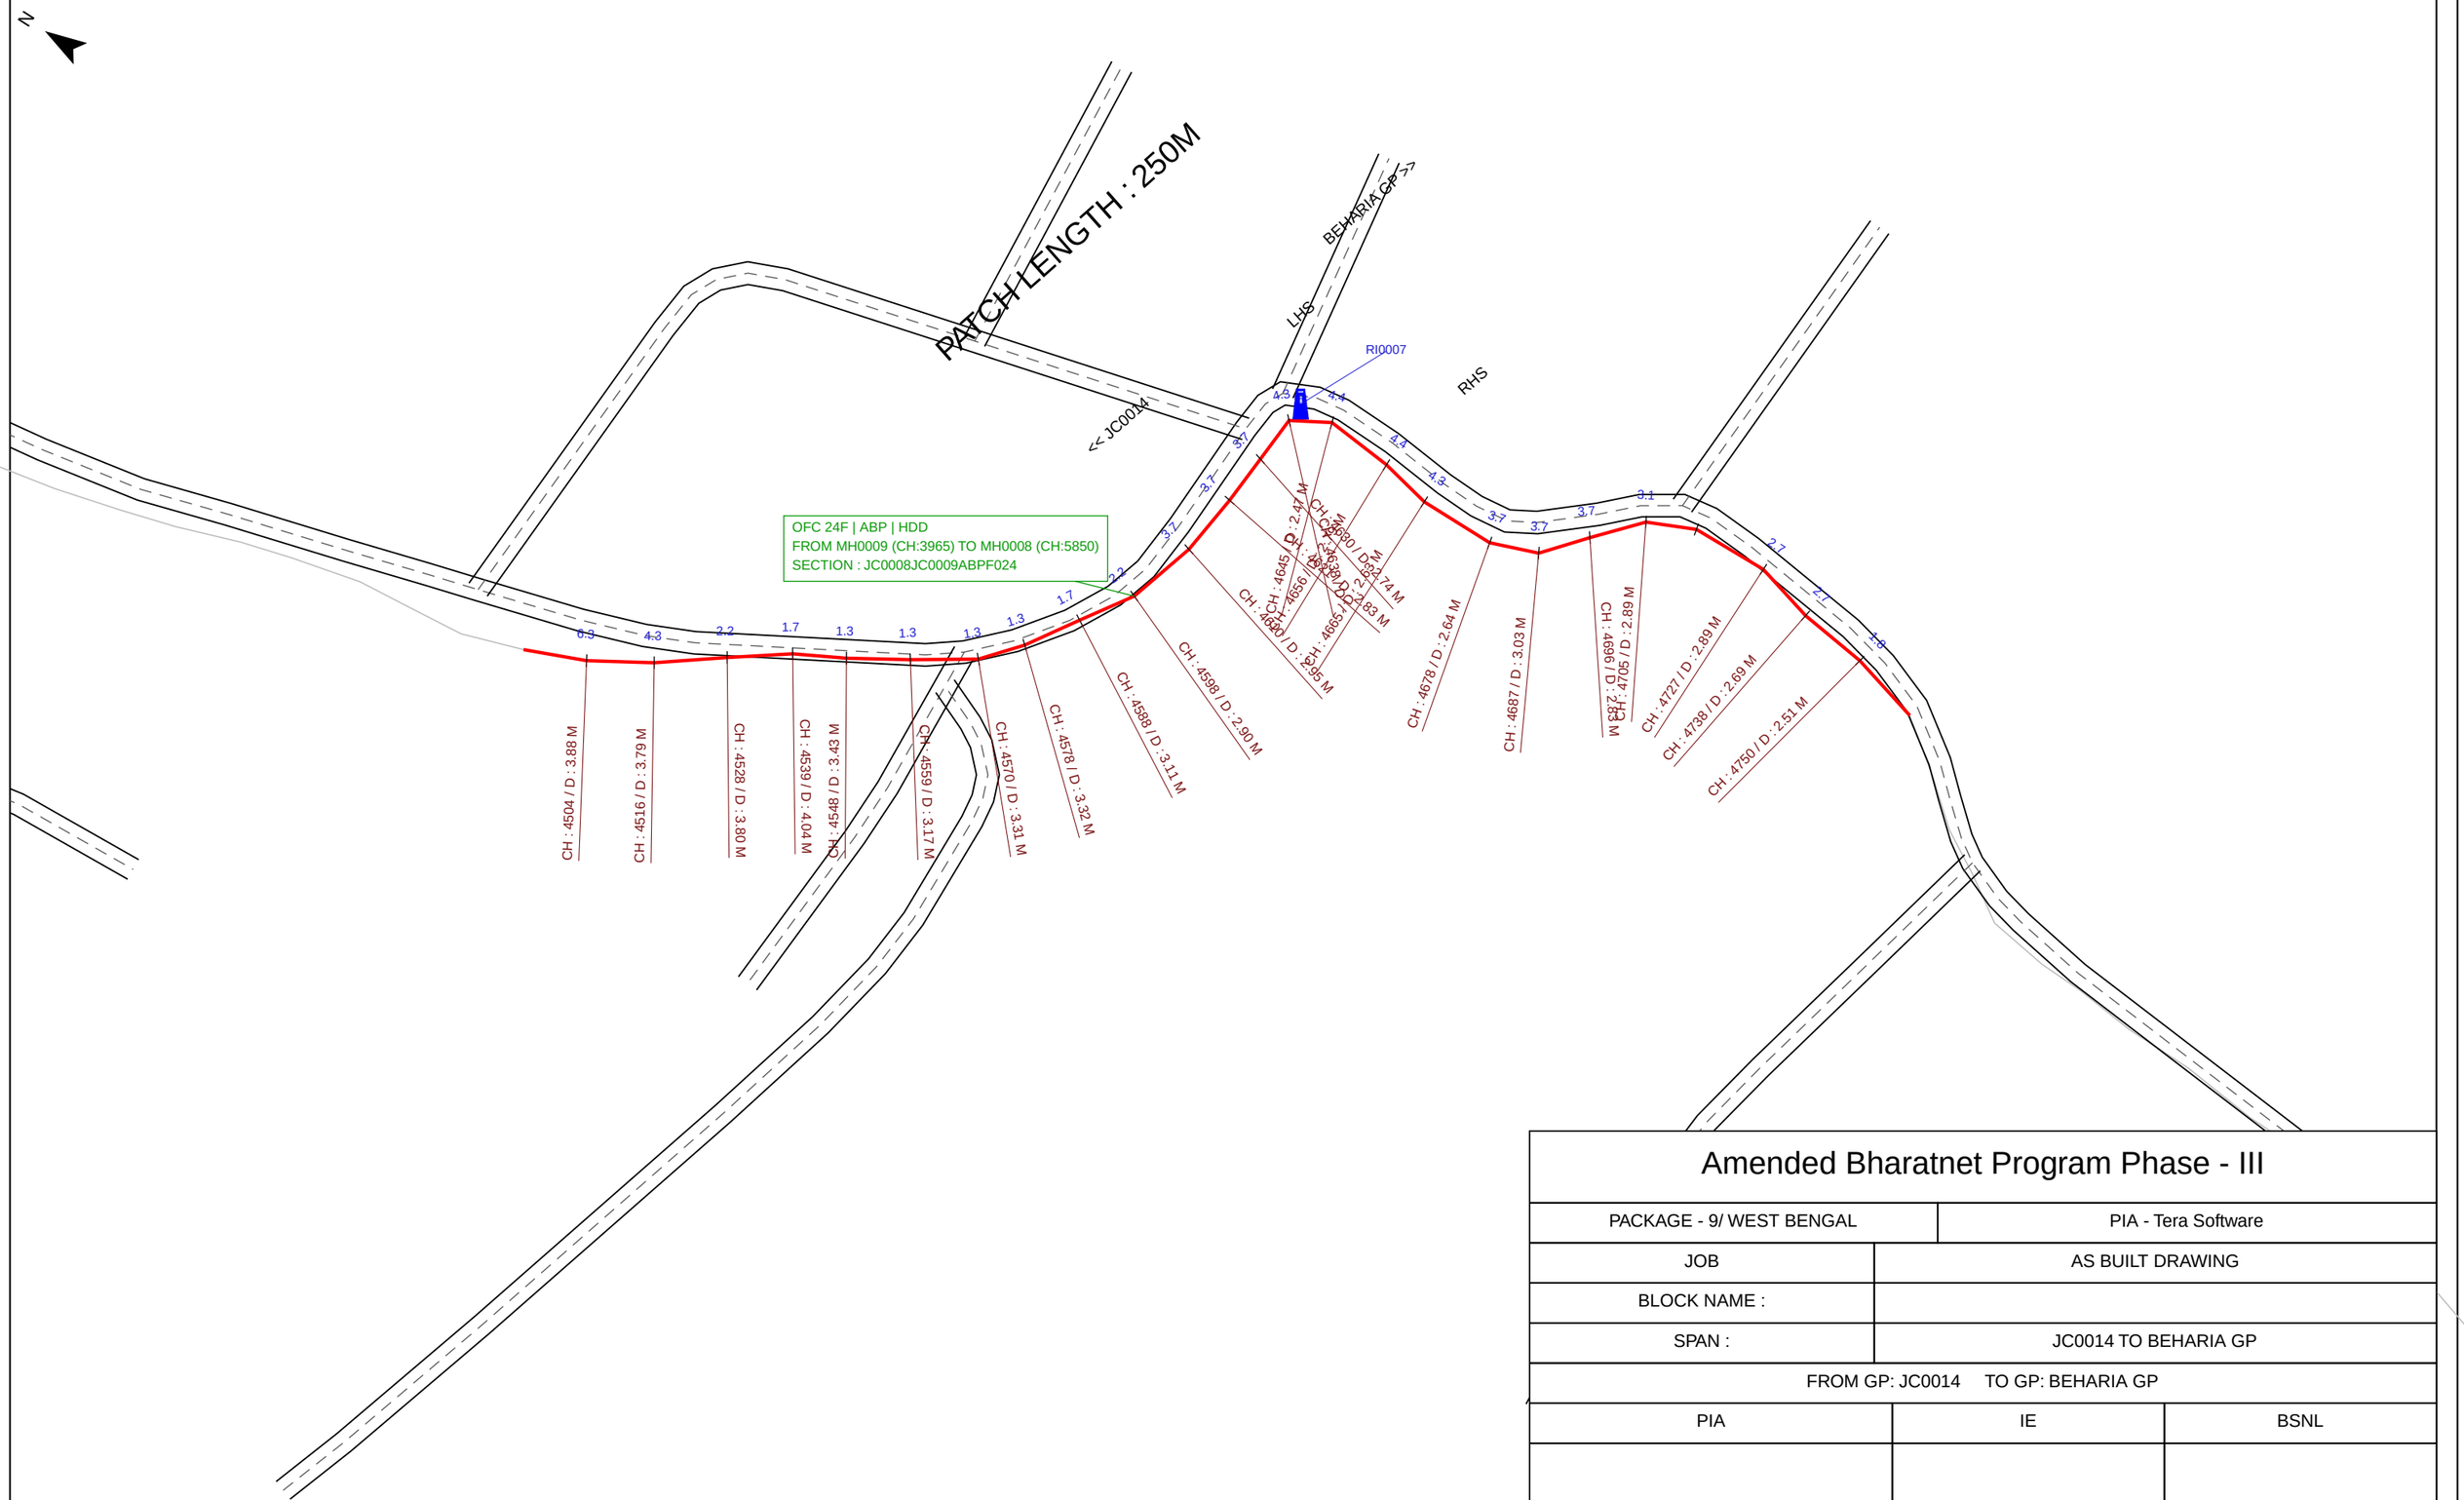

NOTE : ALL MESURMENTS ARE IN METERES (M)

ROAD OFFSET = DISTANCE FROM ROAD CENTRE LINE TO CABLE. ROAD FROM OPENSTREETMAP, CABLE FROM GPS - APPROXIMATE

Amended Bharatnet Program Phase - III

PACKAGE - 9/ WEST BENGAL	PIA - Tera Software
JOB	AS BUILT DRAWING
BLOCK NAME :	
SPAN :	JC0014 TO BEHARIA GP
FROM GP: JC0014 TO GP: BEHARIA GP	

PIA	IE	BSNL

PLANIMETRY SCALE : H/V - 1:1000	SHEET SIZE - A3
FROM CH: 4500 M TO CH: 4750 M	SHEET NO. - 19
Patch Length :- 250 m	DATE:

N

PATCH LENGTH : 250M

OFC 24F | ABP | HDD
FROM MH0009 (CH:3965) TO MH0008 (CH:5850)
SECTION : JC0008JC0009ABPF024

<< JC0014

LHS

RHS

BEHARIA GP >>

CH : 4762 / D : 2.70 M
CH : 4773 / D : 2.62 M
CH : 4782 / D : 2.73 M
CH : 4791 / D : 3.03 M
CH : 4800 / D : 2.72 M
CH : 4810 / D : -
CH : 4818 / D : 2.96 M
CH : 4829 / D : 2.90 M
CH : 4840 / D : 2.87 M
CH : 4854 / D : 2.70 M
CH : 4866 / D : 2.41 M
CH : 4882 / D : 2.10 M
CH : 4897 / D : 2.34 M
CH : 4910 / D : 2.49 M
CH : 4922 / D : 2.30 M
CH : 4937 / D : 2.63 M
CH : 4950 / D : 2.82 M
CH : 4962 / D : 2.44 M
CH : 4975 / D : 2.40 M
CH : 4991 / D : 2.89 M

NOTE : ALL MESURMENTS ARE IN METERES (M)


ROAD OFFSET = DISTANCE FROM ROAD CENTRE LINE TO CABLE. ROAD FROM OPENSTREETMAP, CABLE FROM GPS - APPROXIMATE

Amended Bharatnet Program Phase - III

PACKAGE - 9/ WEST BENGAL	PIA - Tera Software
JOB	AS BUILT DRAWING
BLOCK NAME :	
SPAN :	JC0014 TO BEHARIA GP
FROM GP: JC0014 TO GP: BEHARIA GP	

PIA	IE	BSNL

PLANIMETRY SCALE : H/V - 1:1000	SHEET SIZE - A3
FROM CH: 4750 M TO CH: 5000 M	SHEET NO. - 20
Patch Length :- 250 m	DATE:

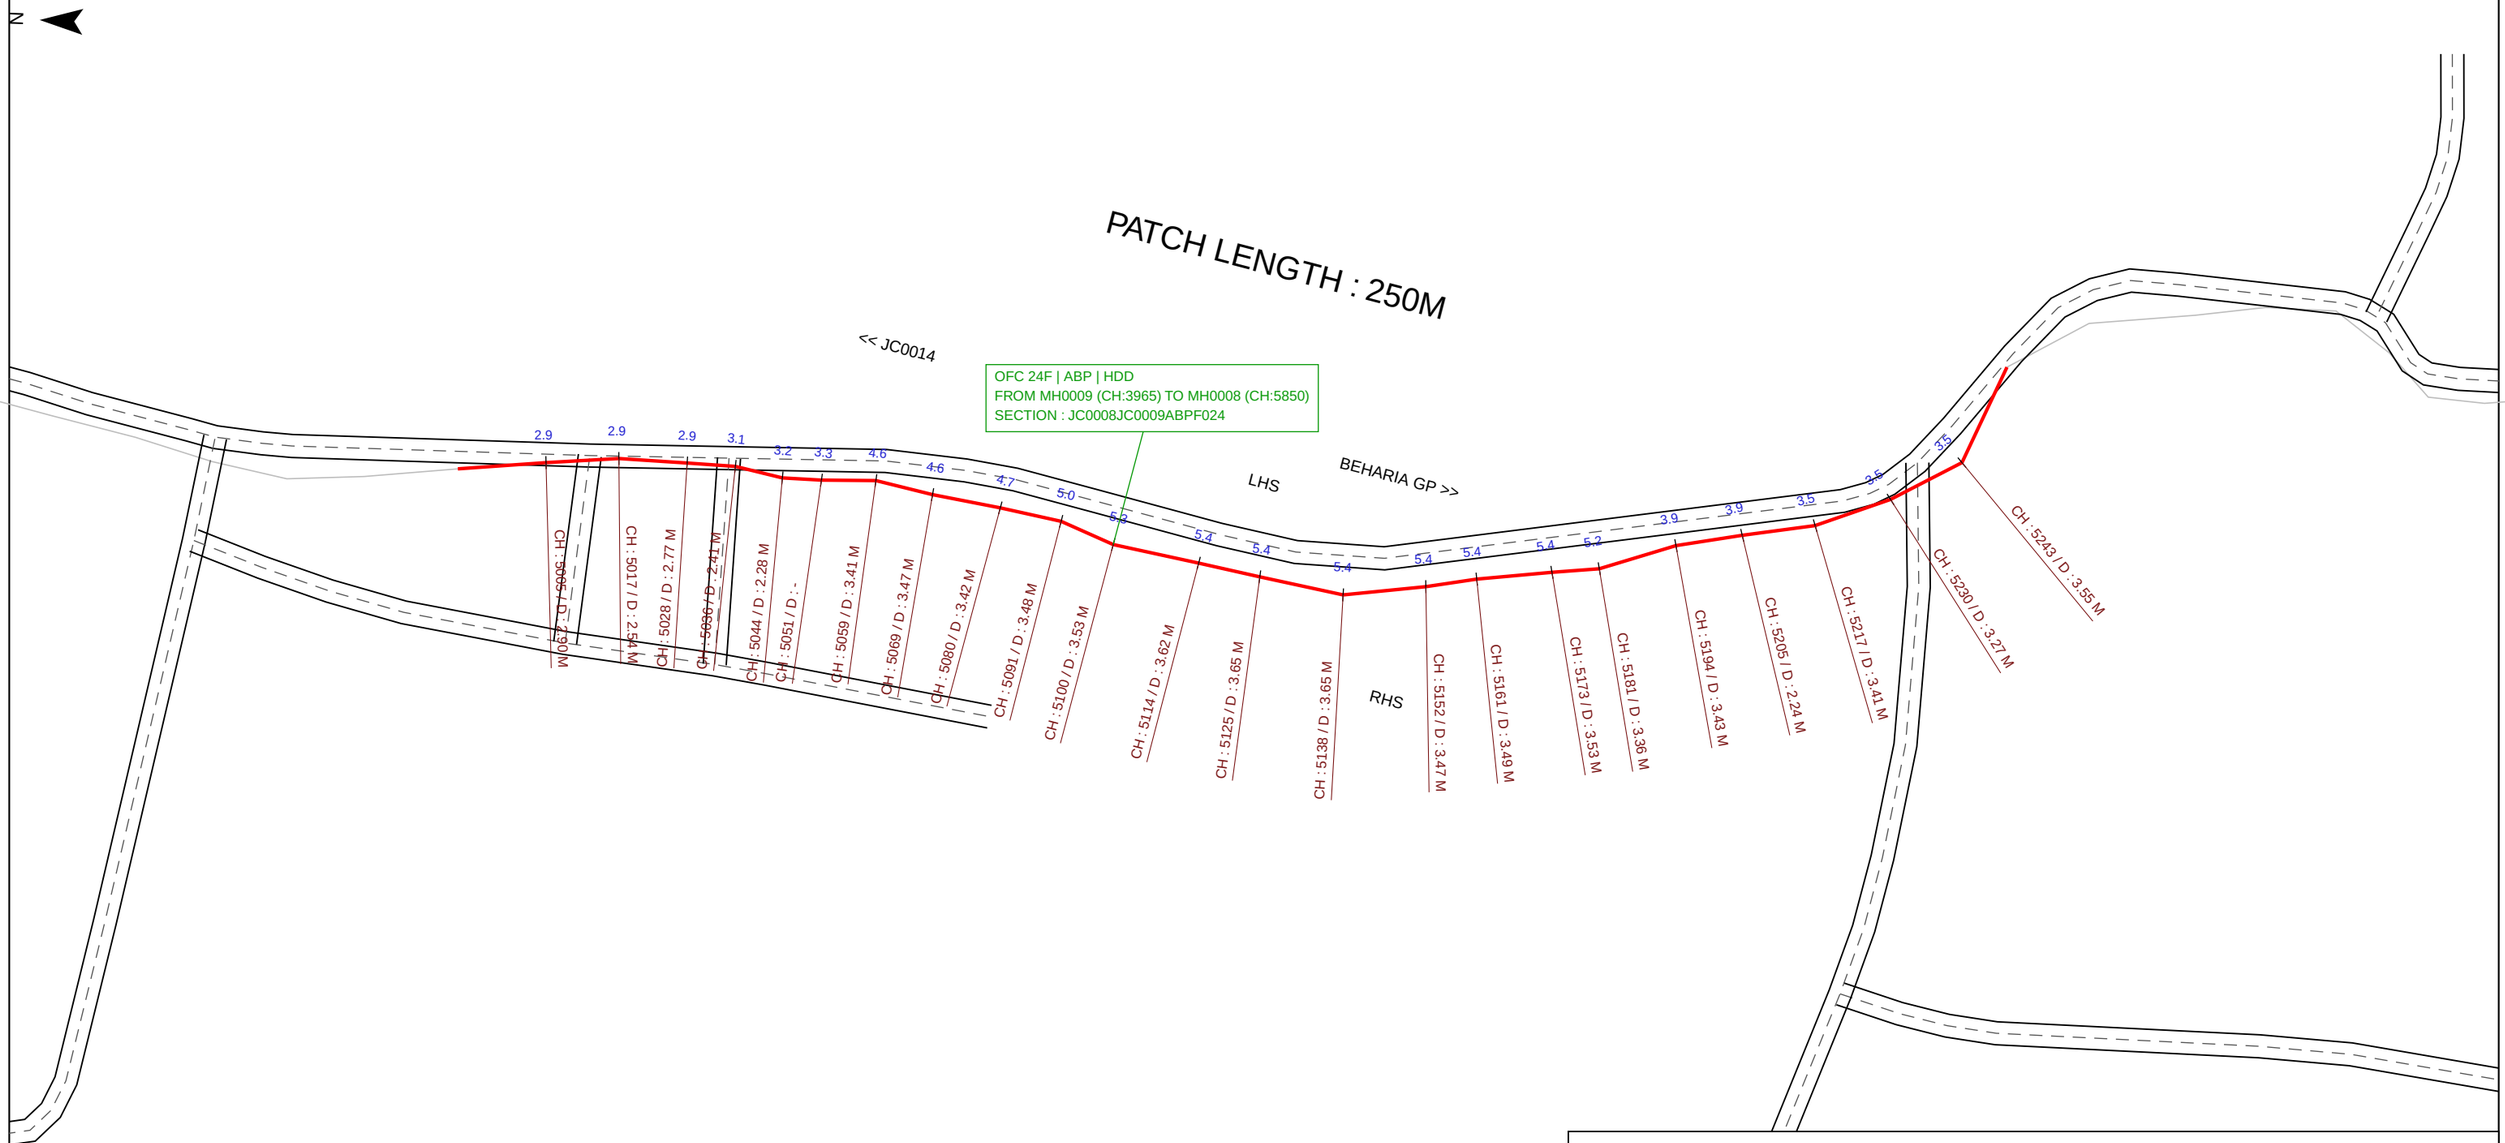

NOTE : ALL MESURMENTS ARE IN METERES (M)


ROAD OFFSET = DISTANCE FROM ROAD CENTRE LINE TO CABLE. ROAD FROM OPENSTREETMAP, CABLE FROM GPS - APPROXIMATE

Amended Bharatnet Program Phase - III

PACKAGE - 9/ WEST BENGAL	PIA - Tera Software
JOB	AS BUILT DRAWING
BLOCK NAME :	
SPAN :	JC0014 TO BEHARIA GP
FROM GP: JC0014 TO GP: BEHARIA GP	

PIA	IE	BSNL

PLANIMETRY SCALE : H/V - 1:1000	SHEET SIZE - A3
FROM CH: 5000 M TO CH: 5250 M	SHEET NO. - 21
Patch Length :- 250 m	DATE:

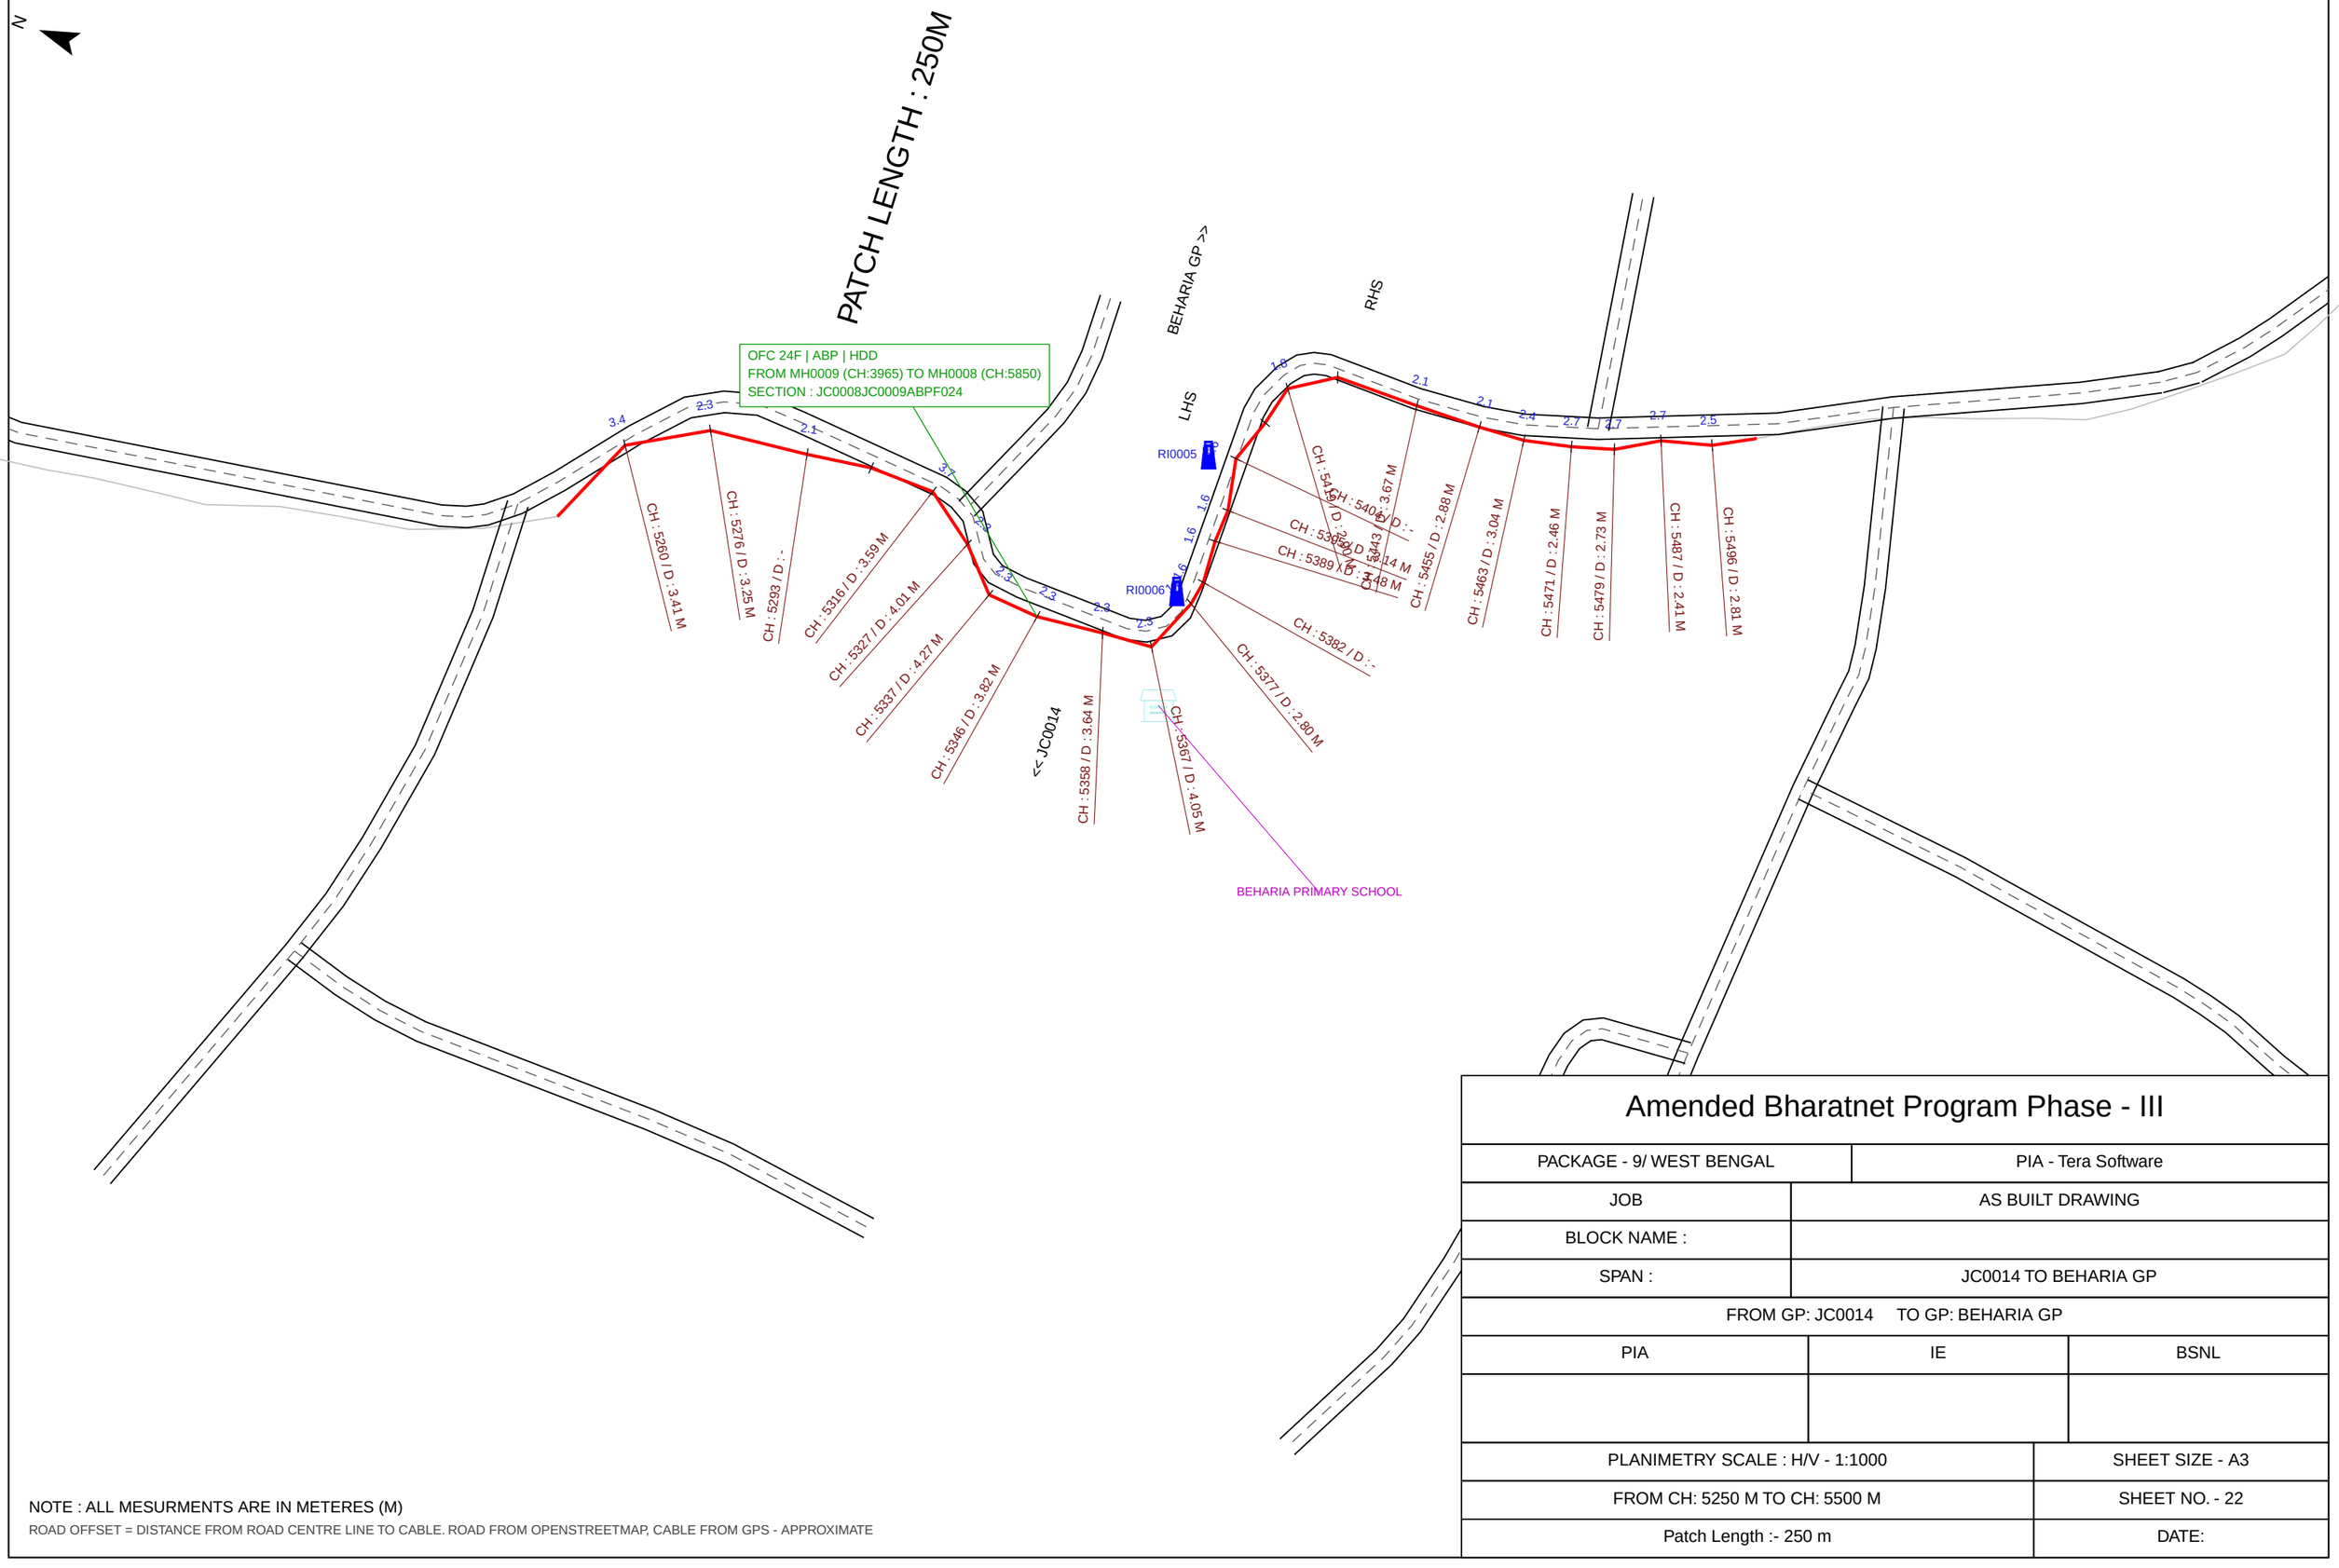

NOTE : ALL MESURMENTS ARE IN METERES (M)


ROAD OFFSET = DISTANCE FROM ROAD CENTRE LINE TO CABLE. ROAD FROM OPENSTREETMAP, CABLE FROM GPS - APPROXIMATE

Amended Bharatnet Program Phase - III

PACKAGE - 9/ WEST BENGAL	PIA - Tera Software
JOB	AS BUILT DRAWING
BLOCK NAME :	
SPAN :	JC0014 TO BEHARIA GP
FROM GP: JC0014 TO GP: BEHARIA GP	

PIA	IE	BSNL

PLANIMETRY SCALE : H/V - 1:1000	SHEET SIZE - A3
FROM CH: 5250 M TO CH: 5500 M	SHEET NO. - 22
Patch Length :- 250 m	DATE:

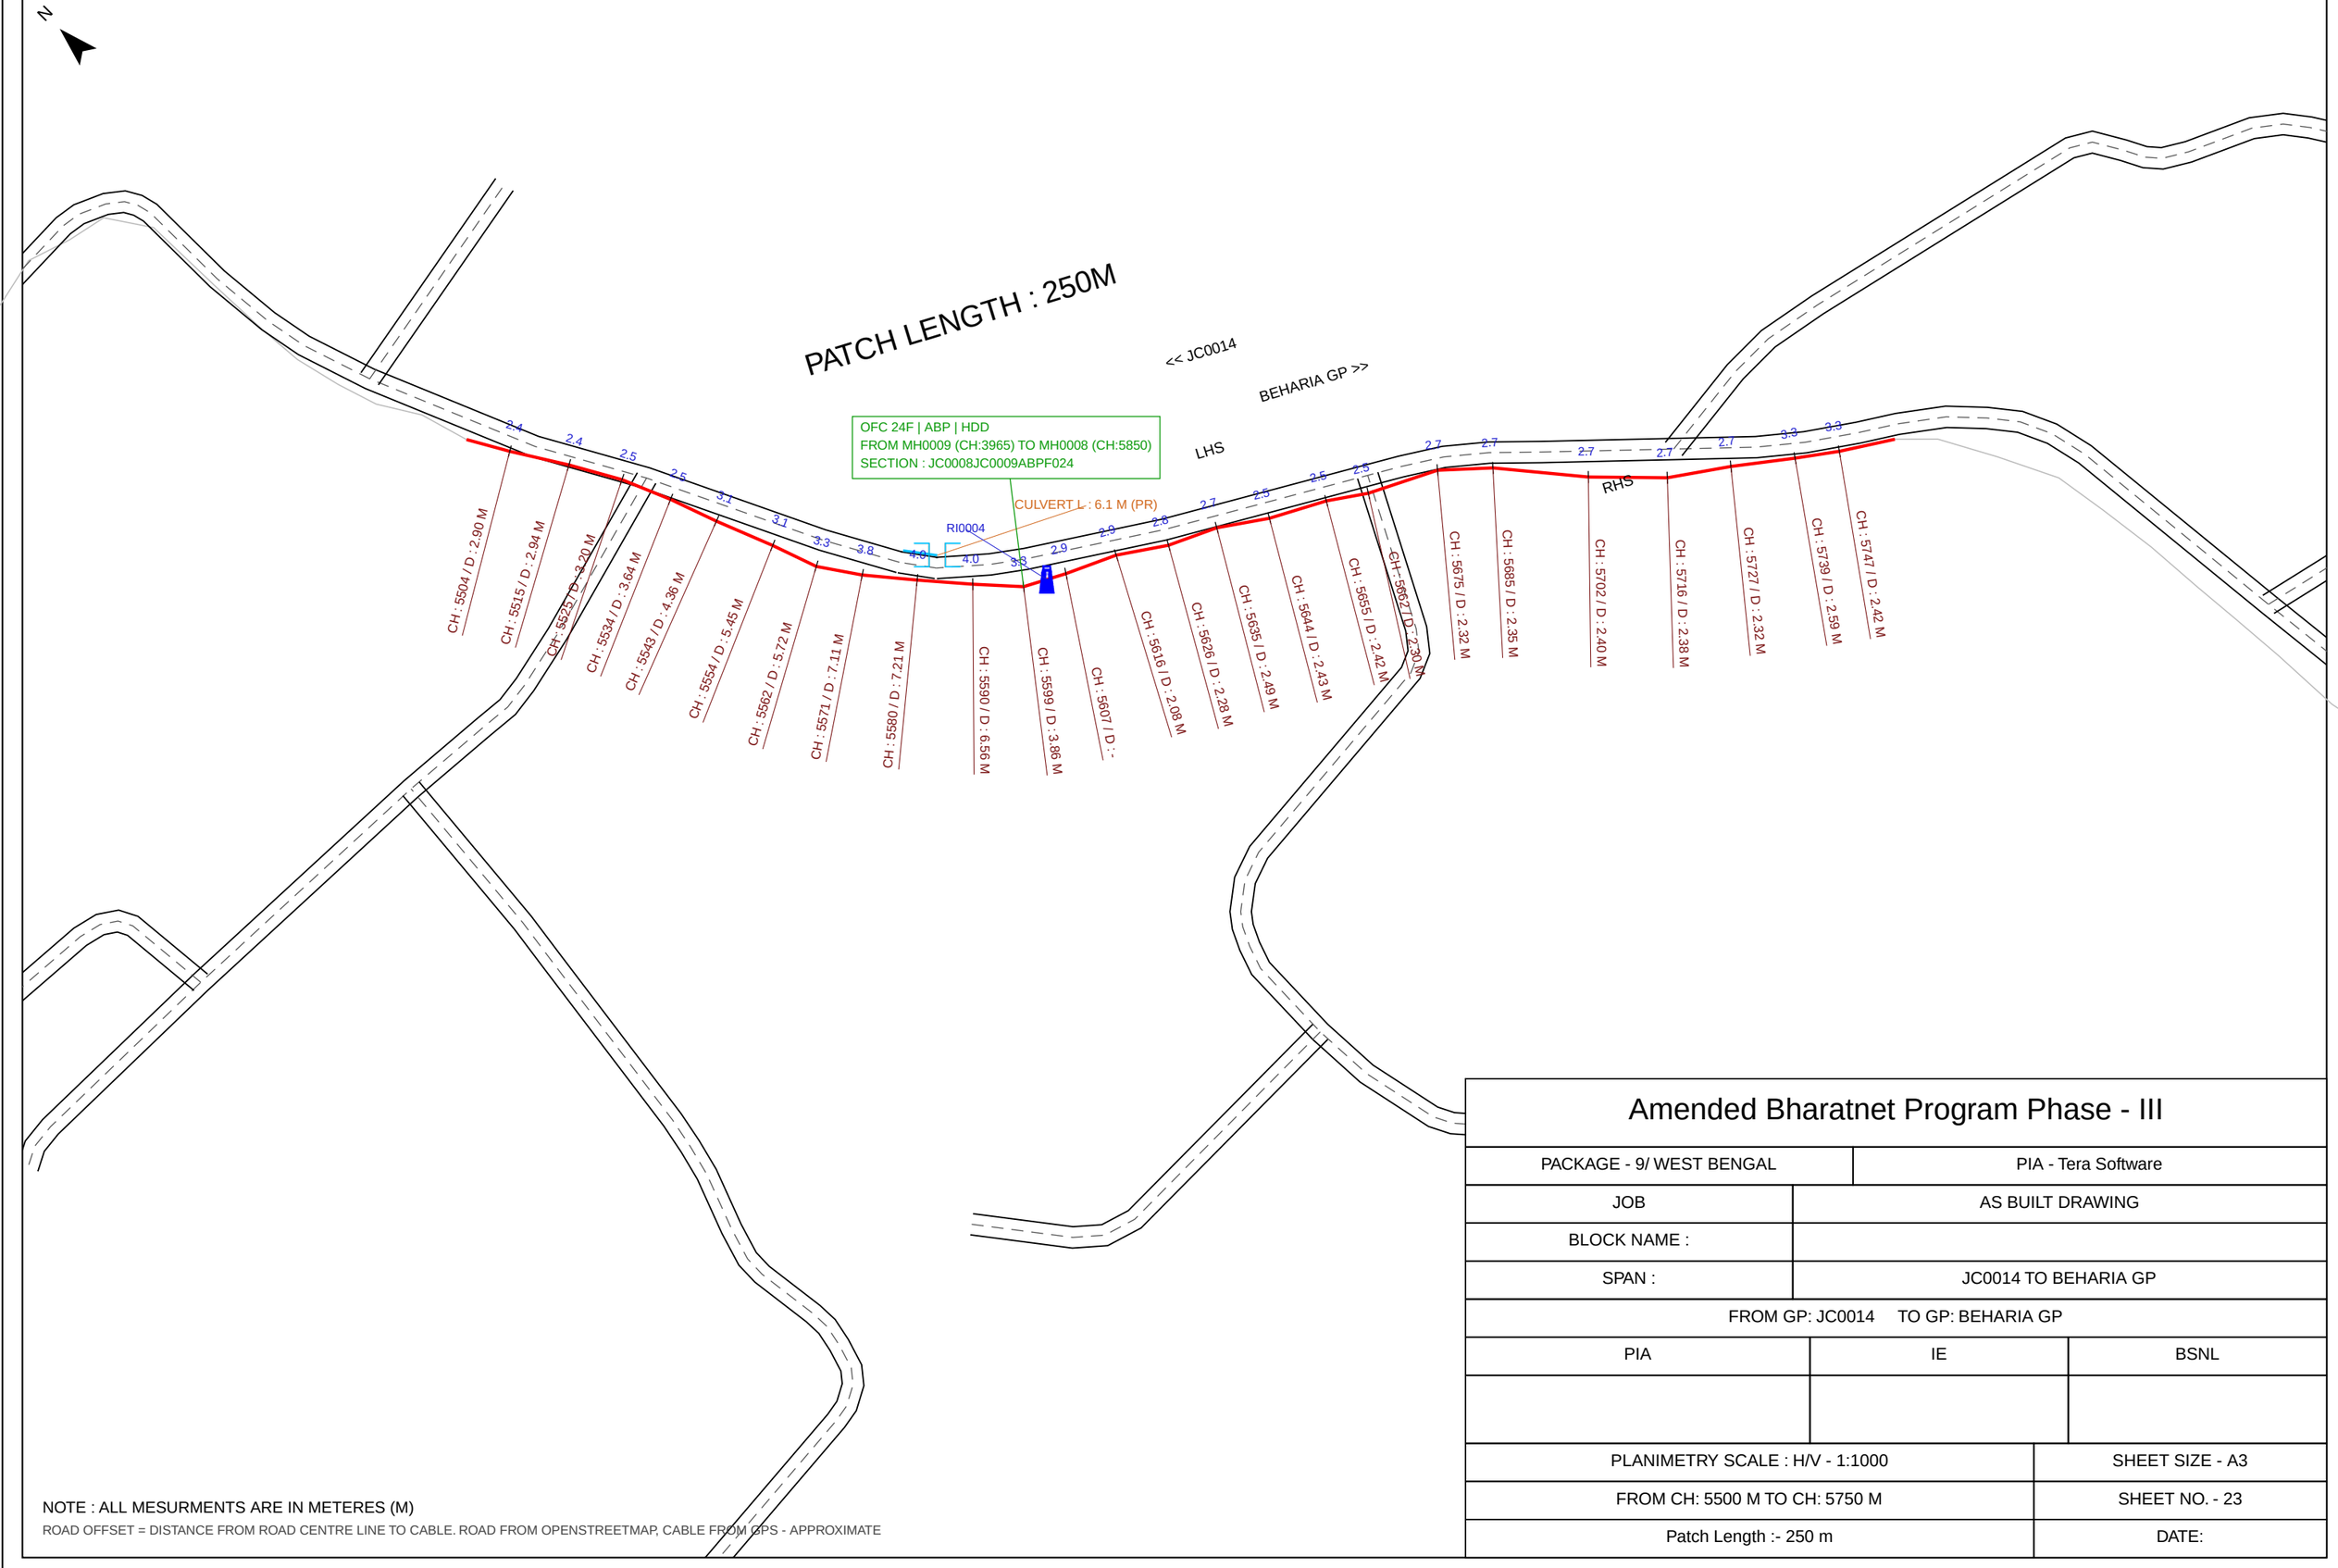

NOTE : ALL MESURMENTS ARE IN METERES (M)


ROAD OFFSET = DISTANCE FROM ROAD CENTRE LINE TO CABLE. ROAD FROM OPENSTREETMAP, CABLE FROM GPS - APPROXIMATE

Amended Bharatnet Program Phase - III

PACKAGE - 9/ WEST BENGAL	PIA - Tera Software
JOB	AS BUILT DRAWING
BLOCK NAME :	
SPAN :	JC0014 TO BEHARIA GP
FROM GP: JC0014 TO GP: BEHARIA GP	

PIA	IE	BSNL

PLANIMETRY SCALE : H/V - 1:1000	SHEET SIZE - A3
FROM CH: 5500 M TO CH: 5750 M	SHEET NO. - 23
Patch Length :- 250 m	DATE:

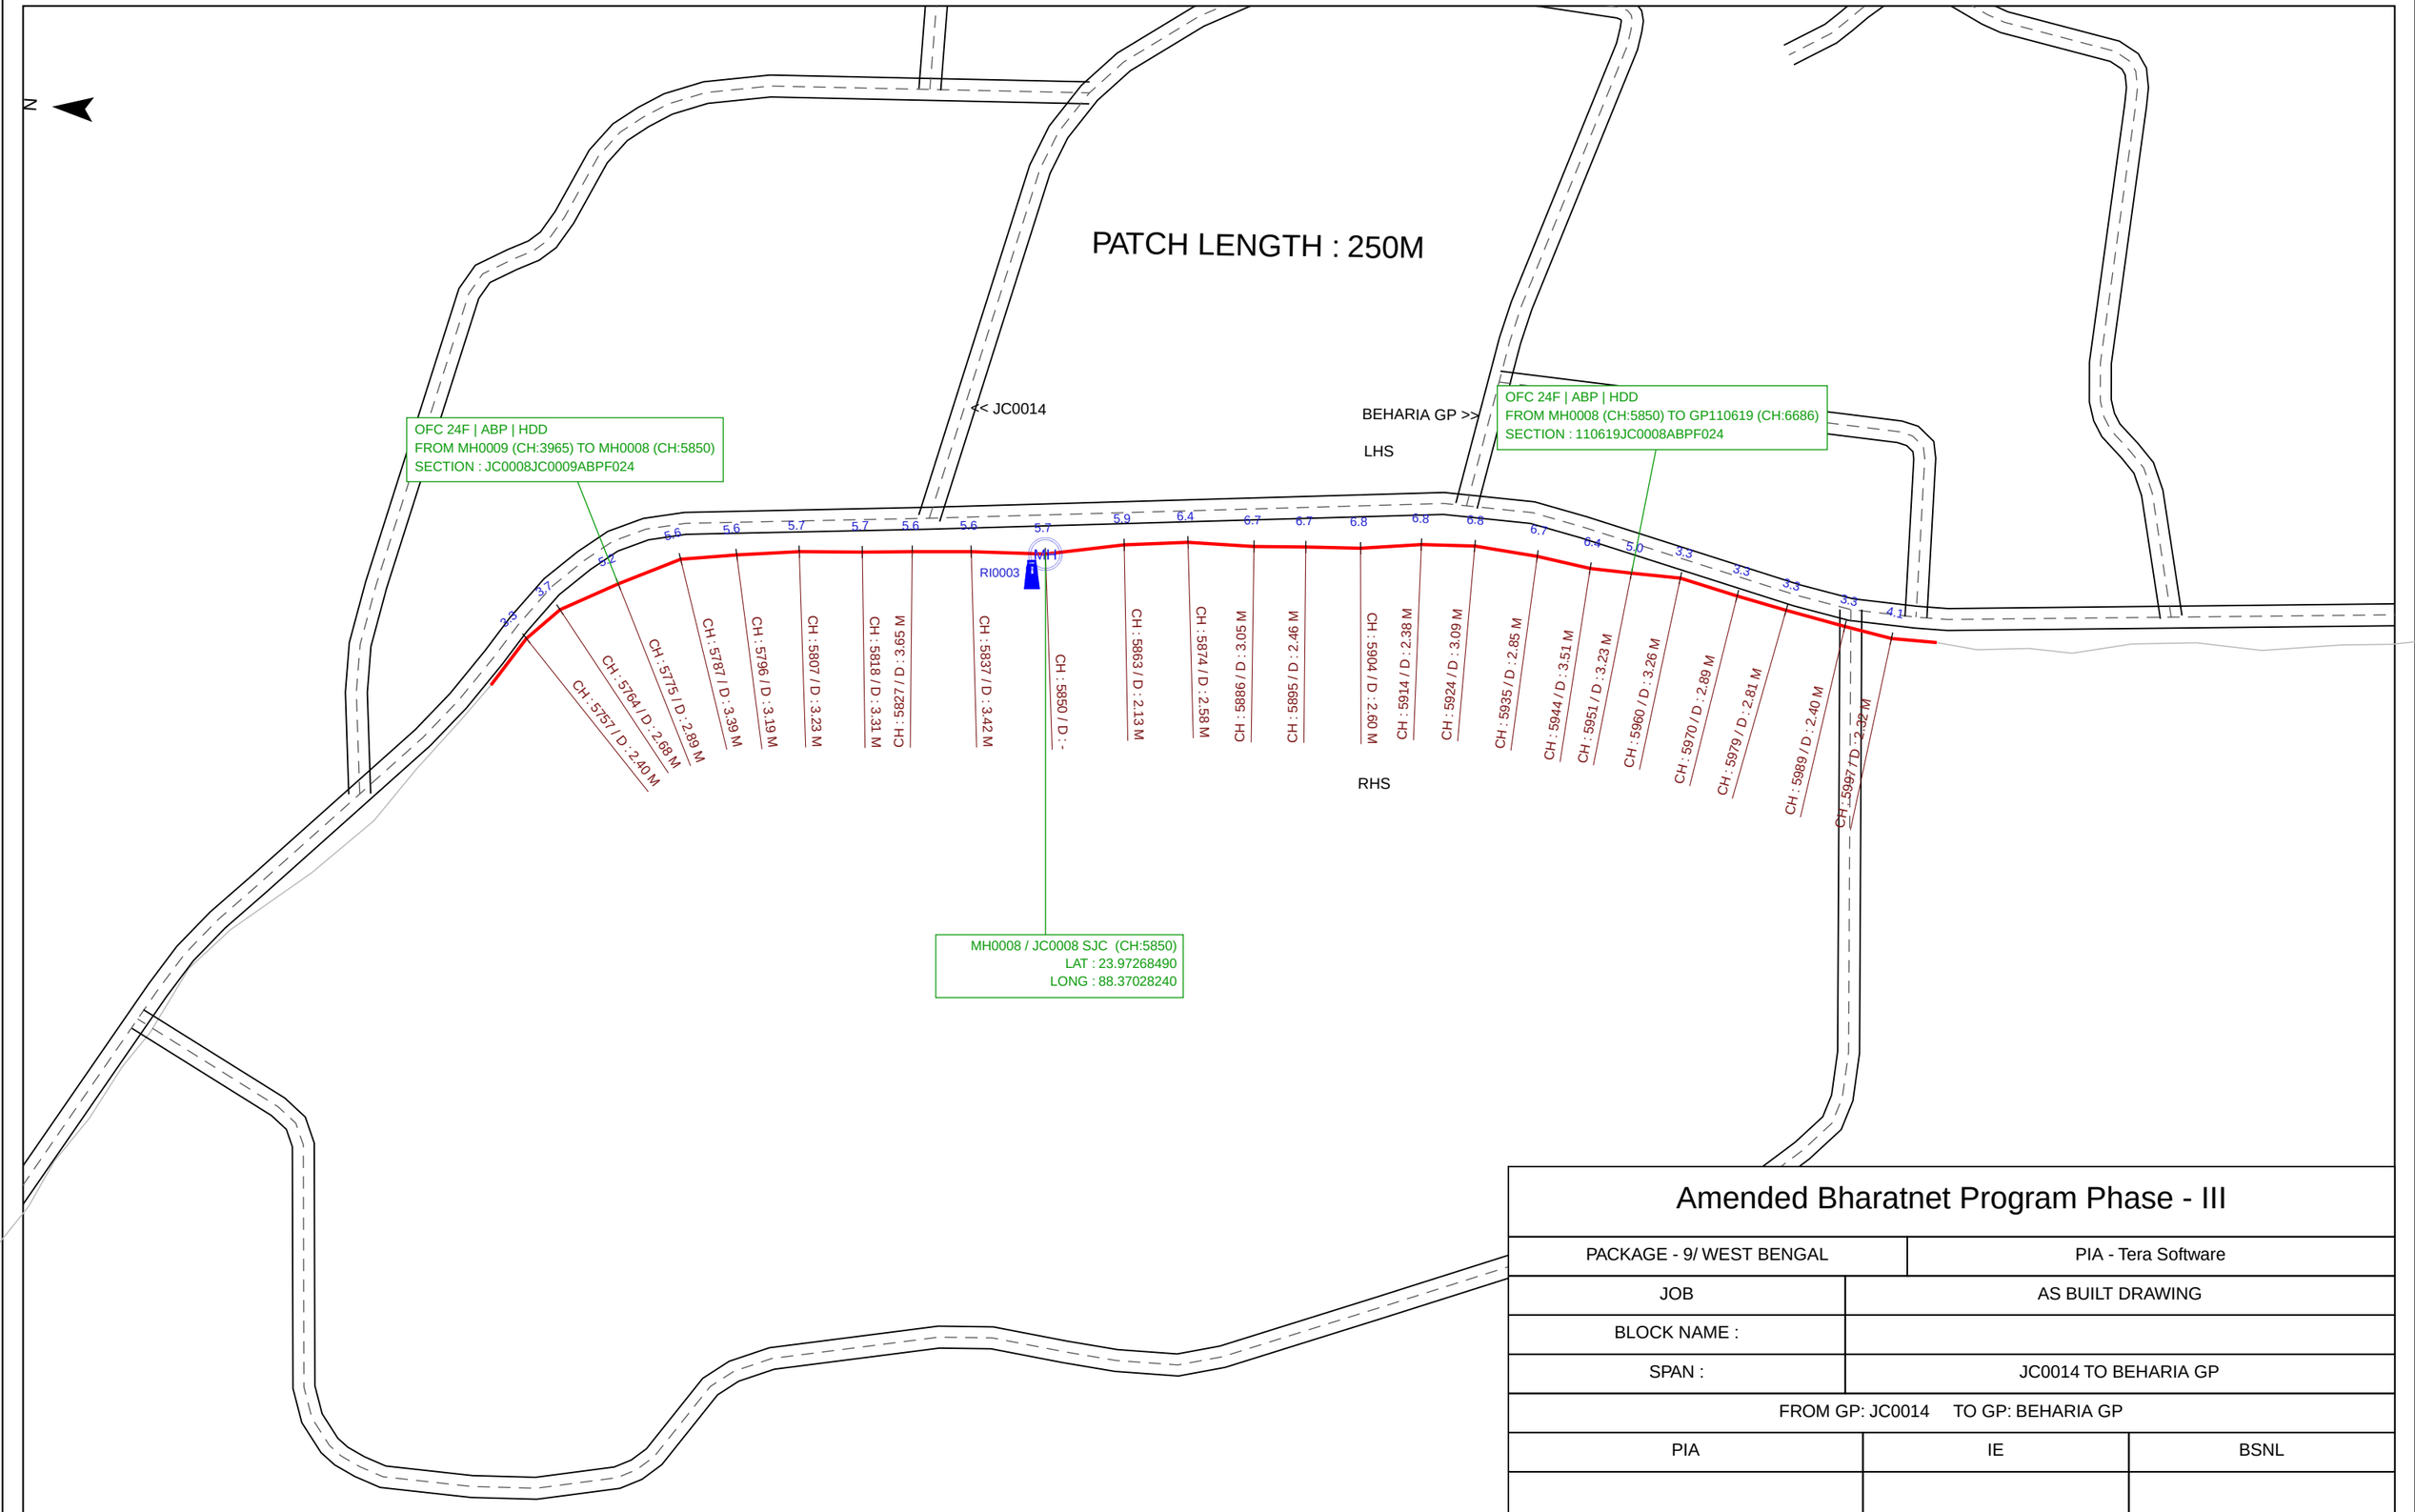

NOTE : ALL MESURMENTS ARE IN METERES (M)


ROAD OFFSET = DISTANCE FROM ROAD CENTRE LINE TO CABLE. ROAD FROM OPENSTREETMAP, CABLE FROM GPS - APPROXIMATE

Amended Bharatnet Program Phase - III

PACKAGE - 9/ WEST BENGAL	PIA - Tera Software
JOB	AS BUILT DRAWING
BLOCK NAME :	
SPAN :	JC0014 TO BEHARIA GP
FROM GP: JC0014 TO GP: BEHARIA GP	

PIA	IE	BSNL

PLANIMETRY SCALE : H/V - 1:1000	SHEET SIZE - A3
FROM CH: 5750 M TO CH: 6000 M	SHEET NO. - 24
Patch Length :- 250 m	DATE:

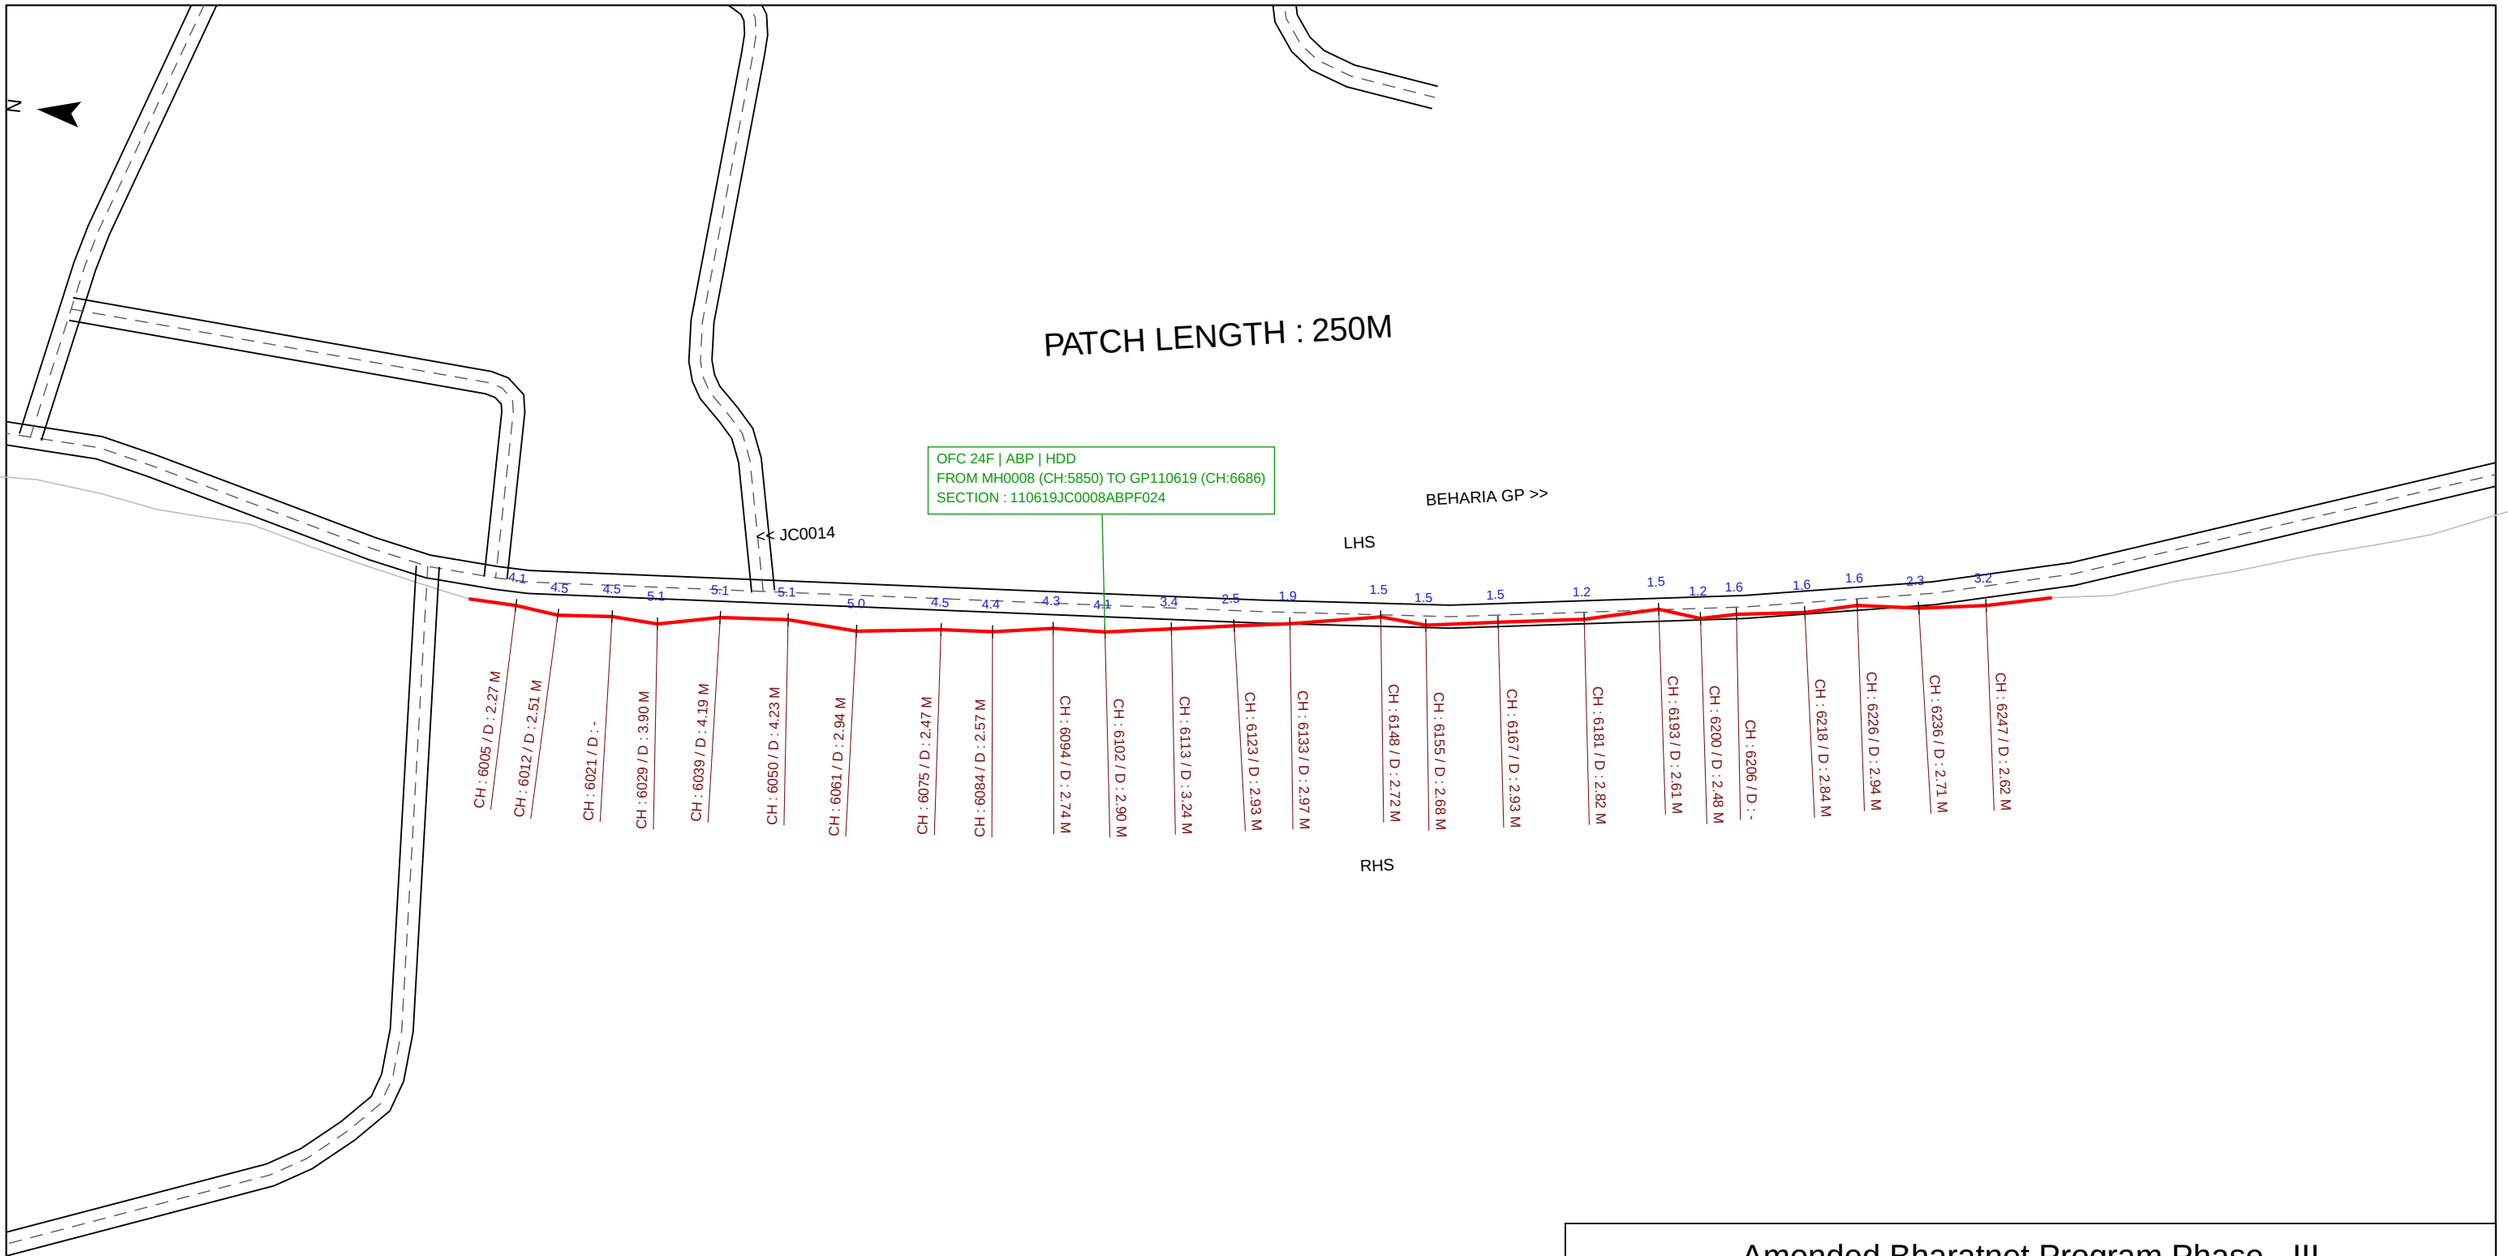

NOTE : ALL MESURMENTS ARE IN METERES (M)

ROAD OFFSET = DISTANCE FROM ROAD CENTRE LINE TO CABLE. ROAD FROM OPENSTREETMAP, CABLE FROM GPS - APPROXIMATE

Amended Bharatnet Program Phase - III

PACKAGE - 9/ WEST BENGAL	PIA - Tera Software
JOB	AS BUILT DRAWING
BLOCK NAME :	
SPAN :	JC0014 TO BEHARIA GP
FROM GP: JC0014 TO GP: BEHARIA GP	

PIA	IE	BSNL

PLANIMETRY SCALE : H/V - 1:1000	SHEET SIZE - A3
FROM CH: 6000 M TO CH: 6250 M	SHEET NO. - 25
Patch Length :- 250 m	DATE:

N


PATCH LENGTH : 250M

OFC 24F | ABP | HDD
FROM MH0008 (CH:5850) TO GP110619 (CH:6686)
SECTION : 110619JC0008ABPF024

<< JC0014

BEHARIA GP >>

LHS

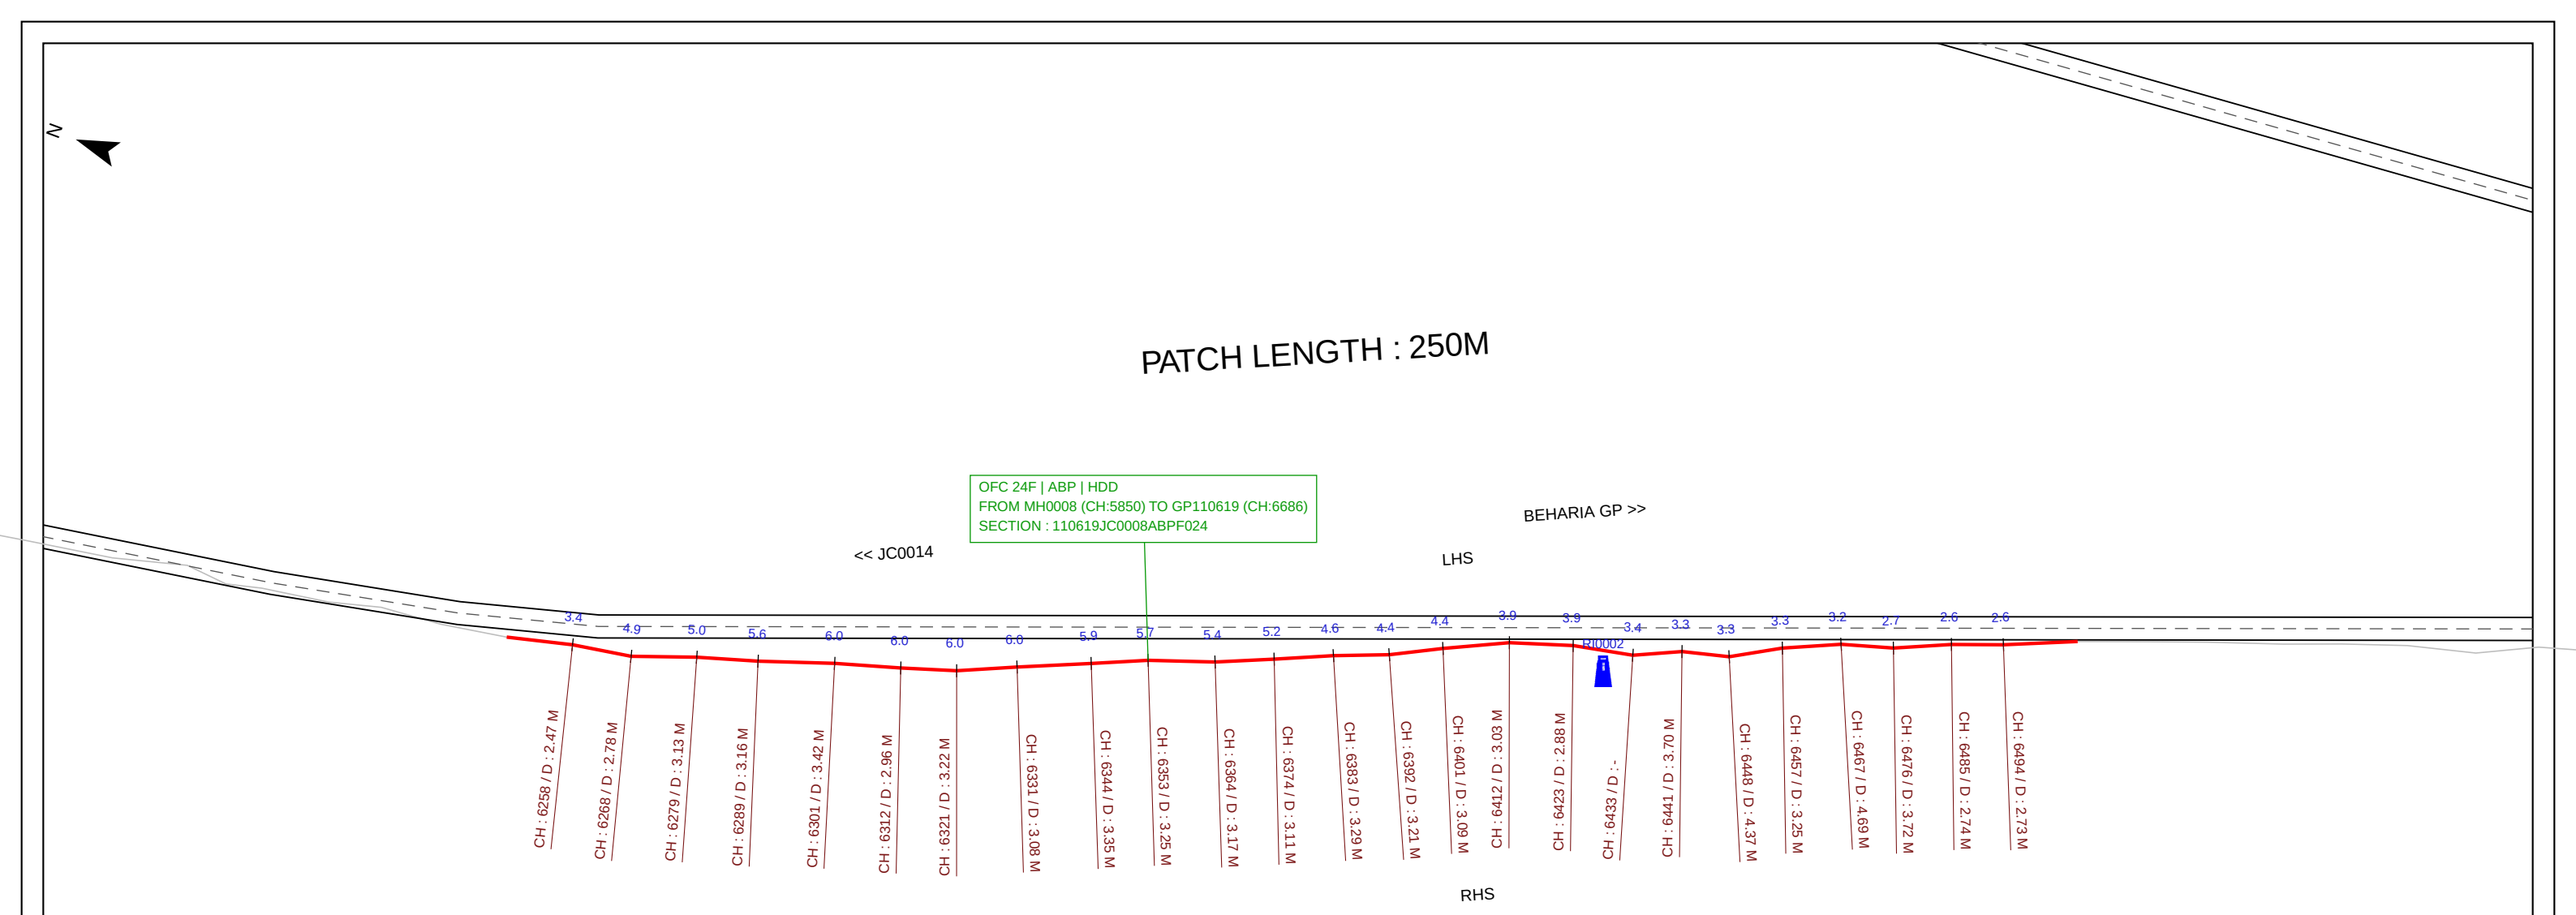

RHS

NOTE : ALL MESURMENTS ARE IN METERES (M)

ROAD OFFSET = DISTANCE FROM ROAD CENTRE LINE TO CABLE. ROAD FROM OPENSTREETMAP, CABLE FROM GPS - APPROXIMATE

Amended Bharatnet Program Phase - III


PACKAGE - 9/ WEST BENGAL	PIA - Tera Software
JOB	AS BUILT DRAWING
BLOCK NAME :	
SPAN :	JC0014 TO BEHARIA GP
FROM GP: JC0014 TO GP: BEHARIA GP	

PIA	IE	BSNL

PLANIMETRY SCALE : H/V - 1:1000	SHEET SIZE - A3
FROM CH: 6250 M TO CH: 6500 M	SHEET NO. - 26
Patch Length :- 250 m	DATE:

N

PATCH LENGTH : 186M

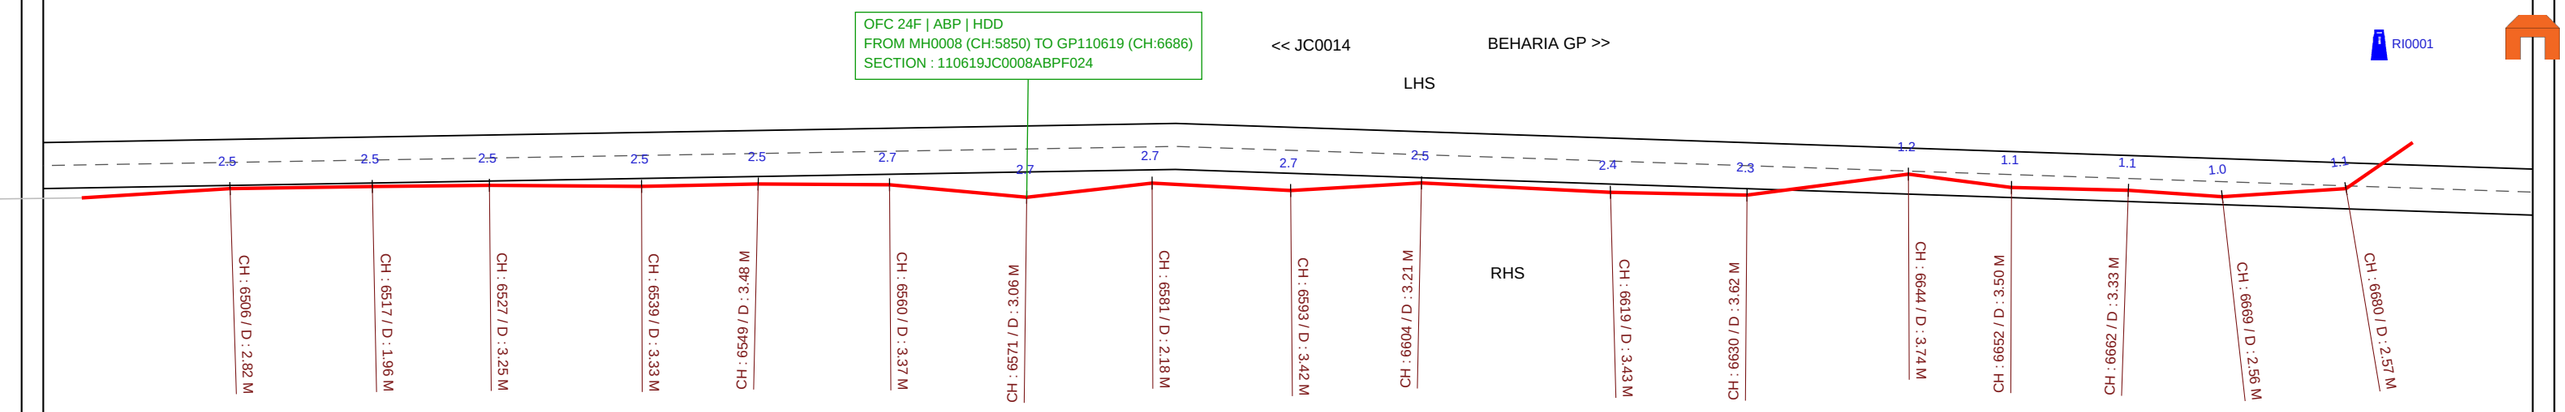

NOTE : ALL MESURMENTS ARE IN METERES (M)

ROAD OFFSET = DISTANCE FROM ROAD CENTRE LINE TO CABLE. ROAD FROM OPENSTREETMAP, CABLE FROM GPS - APPROXIMATE

Amended Bharatnet Program Phase - III

PACKAGE - 9/ WEST BENGAL	PIA - Tera Software
JOB	AS BUILT DRAWING
BLOCK NAME :	
SPAN :	JC0014 TO BEHARIA GP
FROM GP: JC0014 TO GP: BEHARIA GP	

PIA	IE	BSNL

PLANIMETRY SCALE : H/V - 1:500	SHEET SIZE - A3
FROM CH: 6500 M TO CH: 6686 M	SHEET NO. - 27
Patch Length :- 186 m	DATE: